

STREET



STREET

TOWNLEY

STREET

ATWOOD

WILLARD

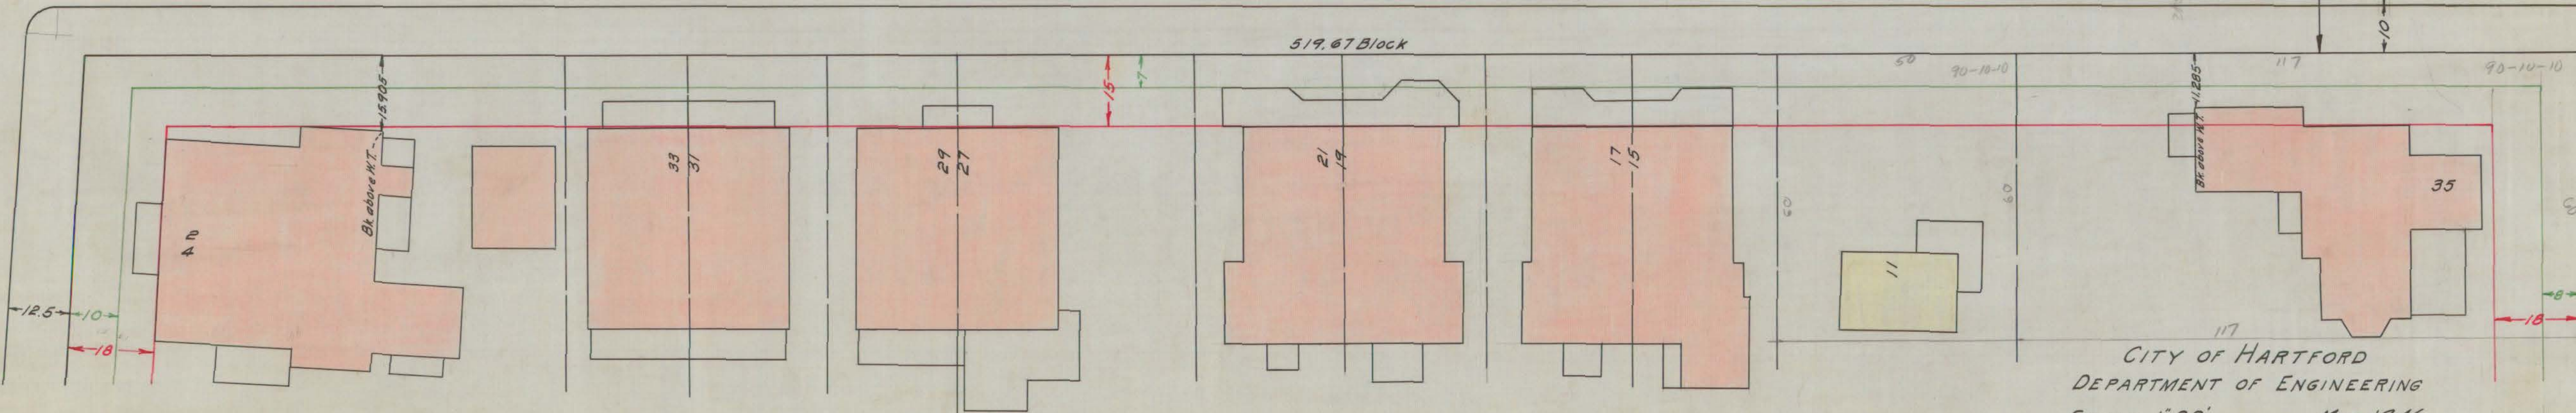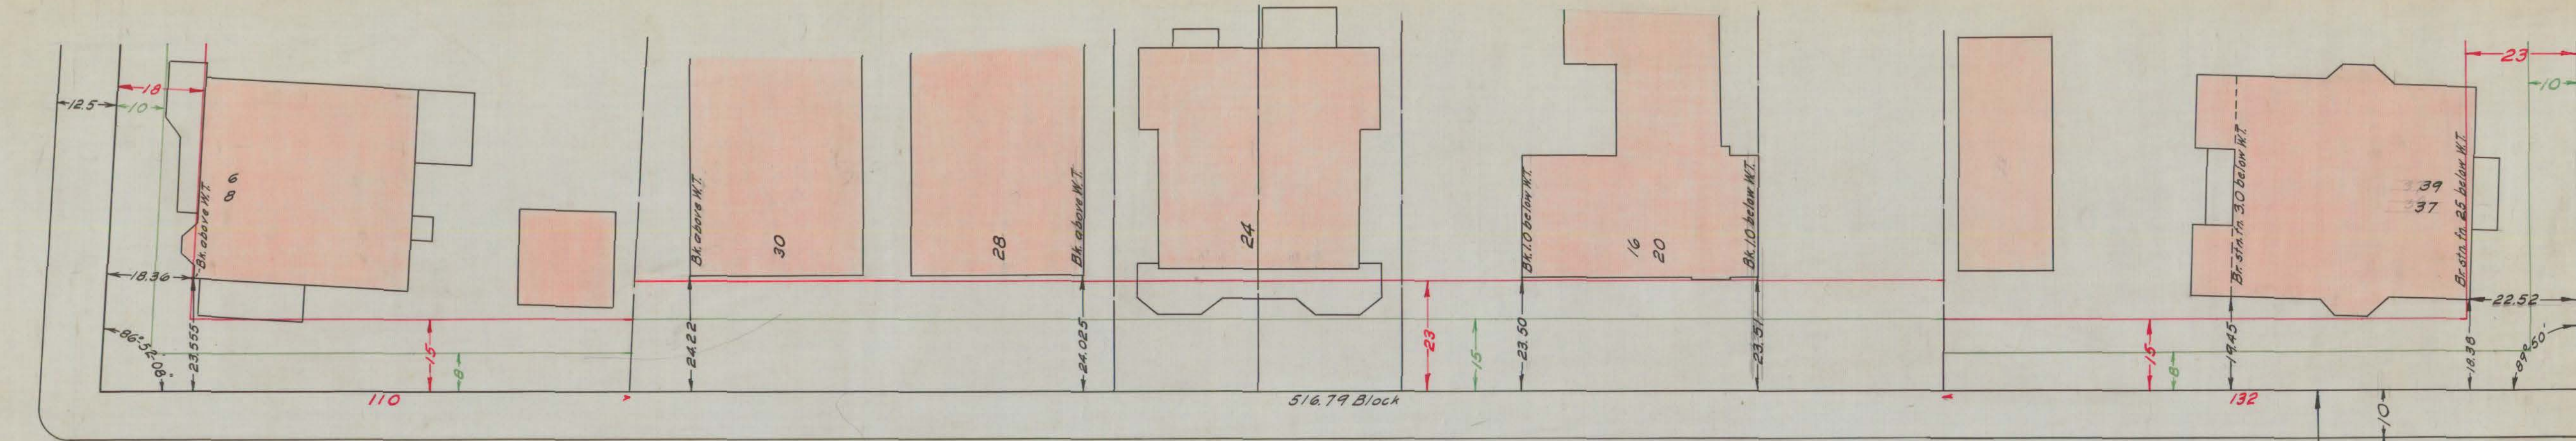

CITY OF HARTFORD
DEPARTMENT OF ENGINEERING
SCALE-1"=20' MAY 1946
DAYBOOK No. 08761

NOTES-686