


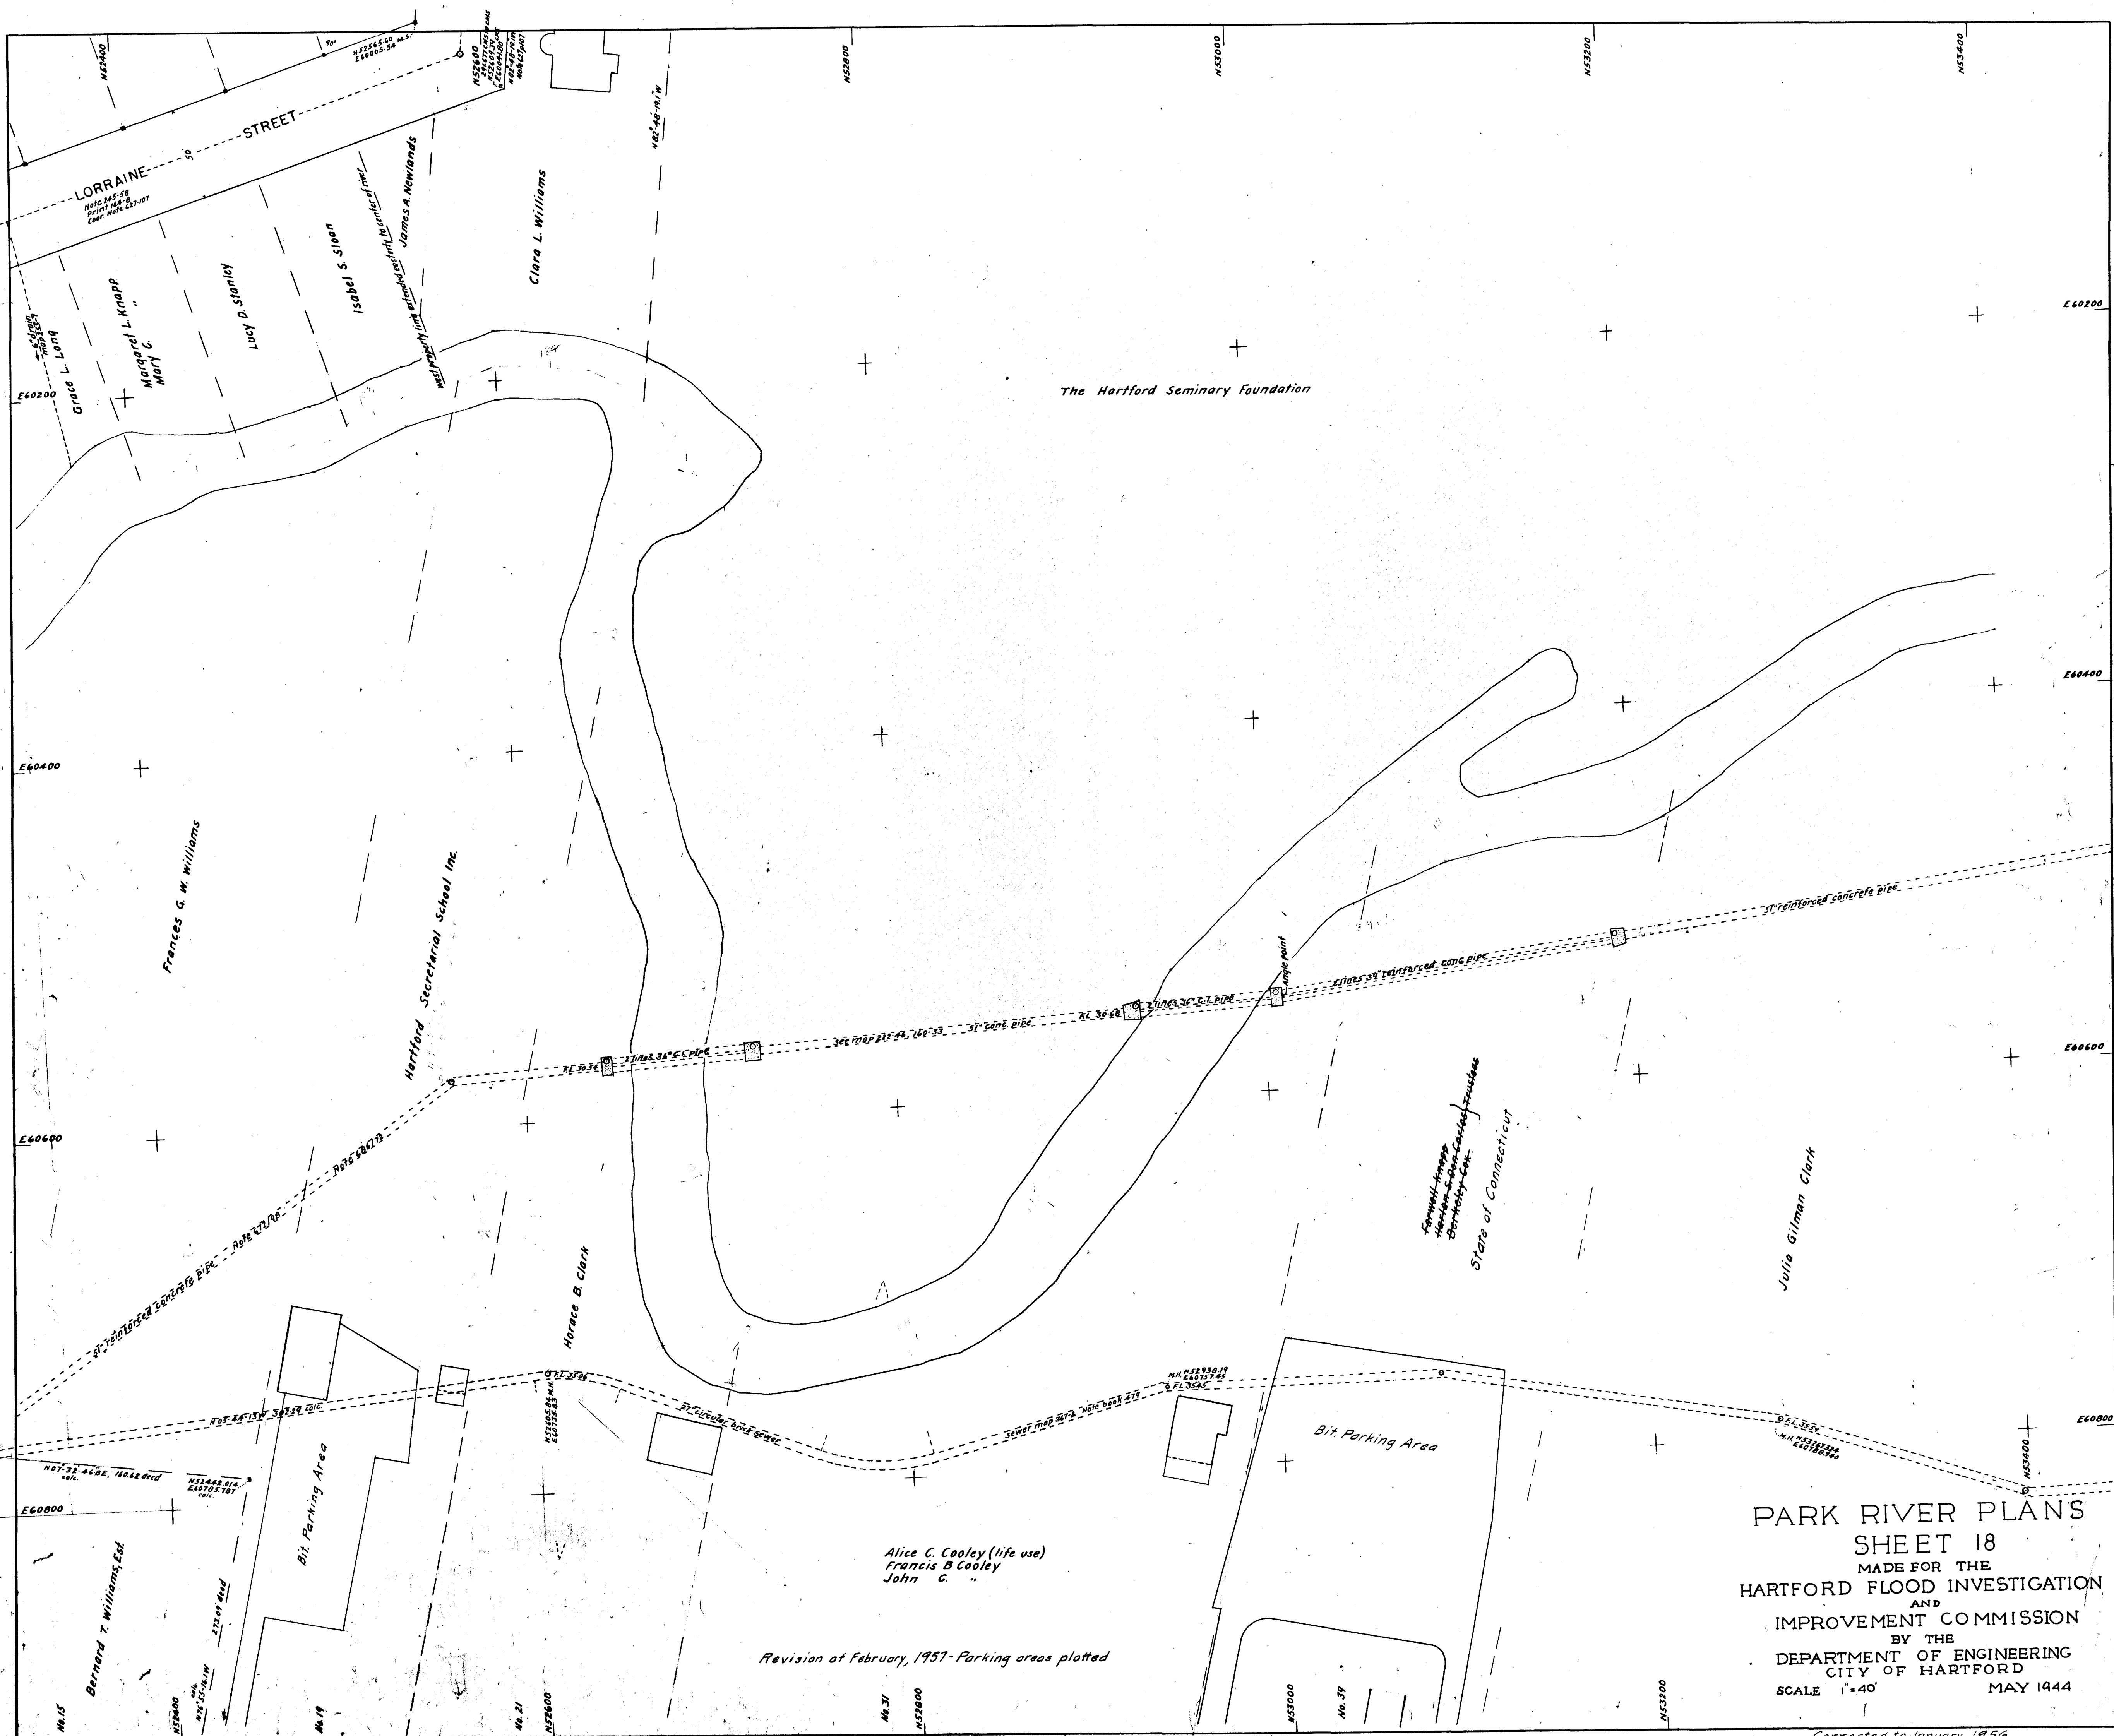

PARK RIVER PLANS
SHEET 18
MADE FOR THE
HARTFORD FLOOD INVESTIGATION
AND
IMPROVEMENT COMMISSION
BY THE
DEPARTMENT OF ENGINEERING
CITY OF HARTFORD
SCALE 1"=40' MAY 1944

Revision of February, 1957 - Parking areas plotted

Corrected to January, 1956