



03448

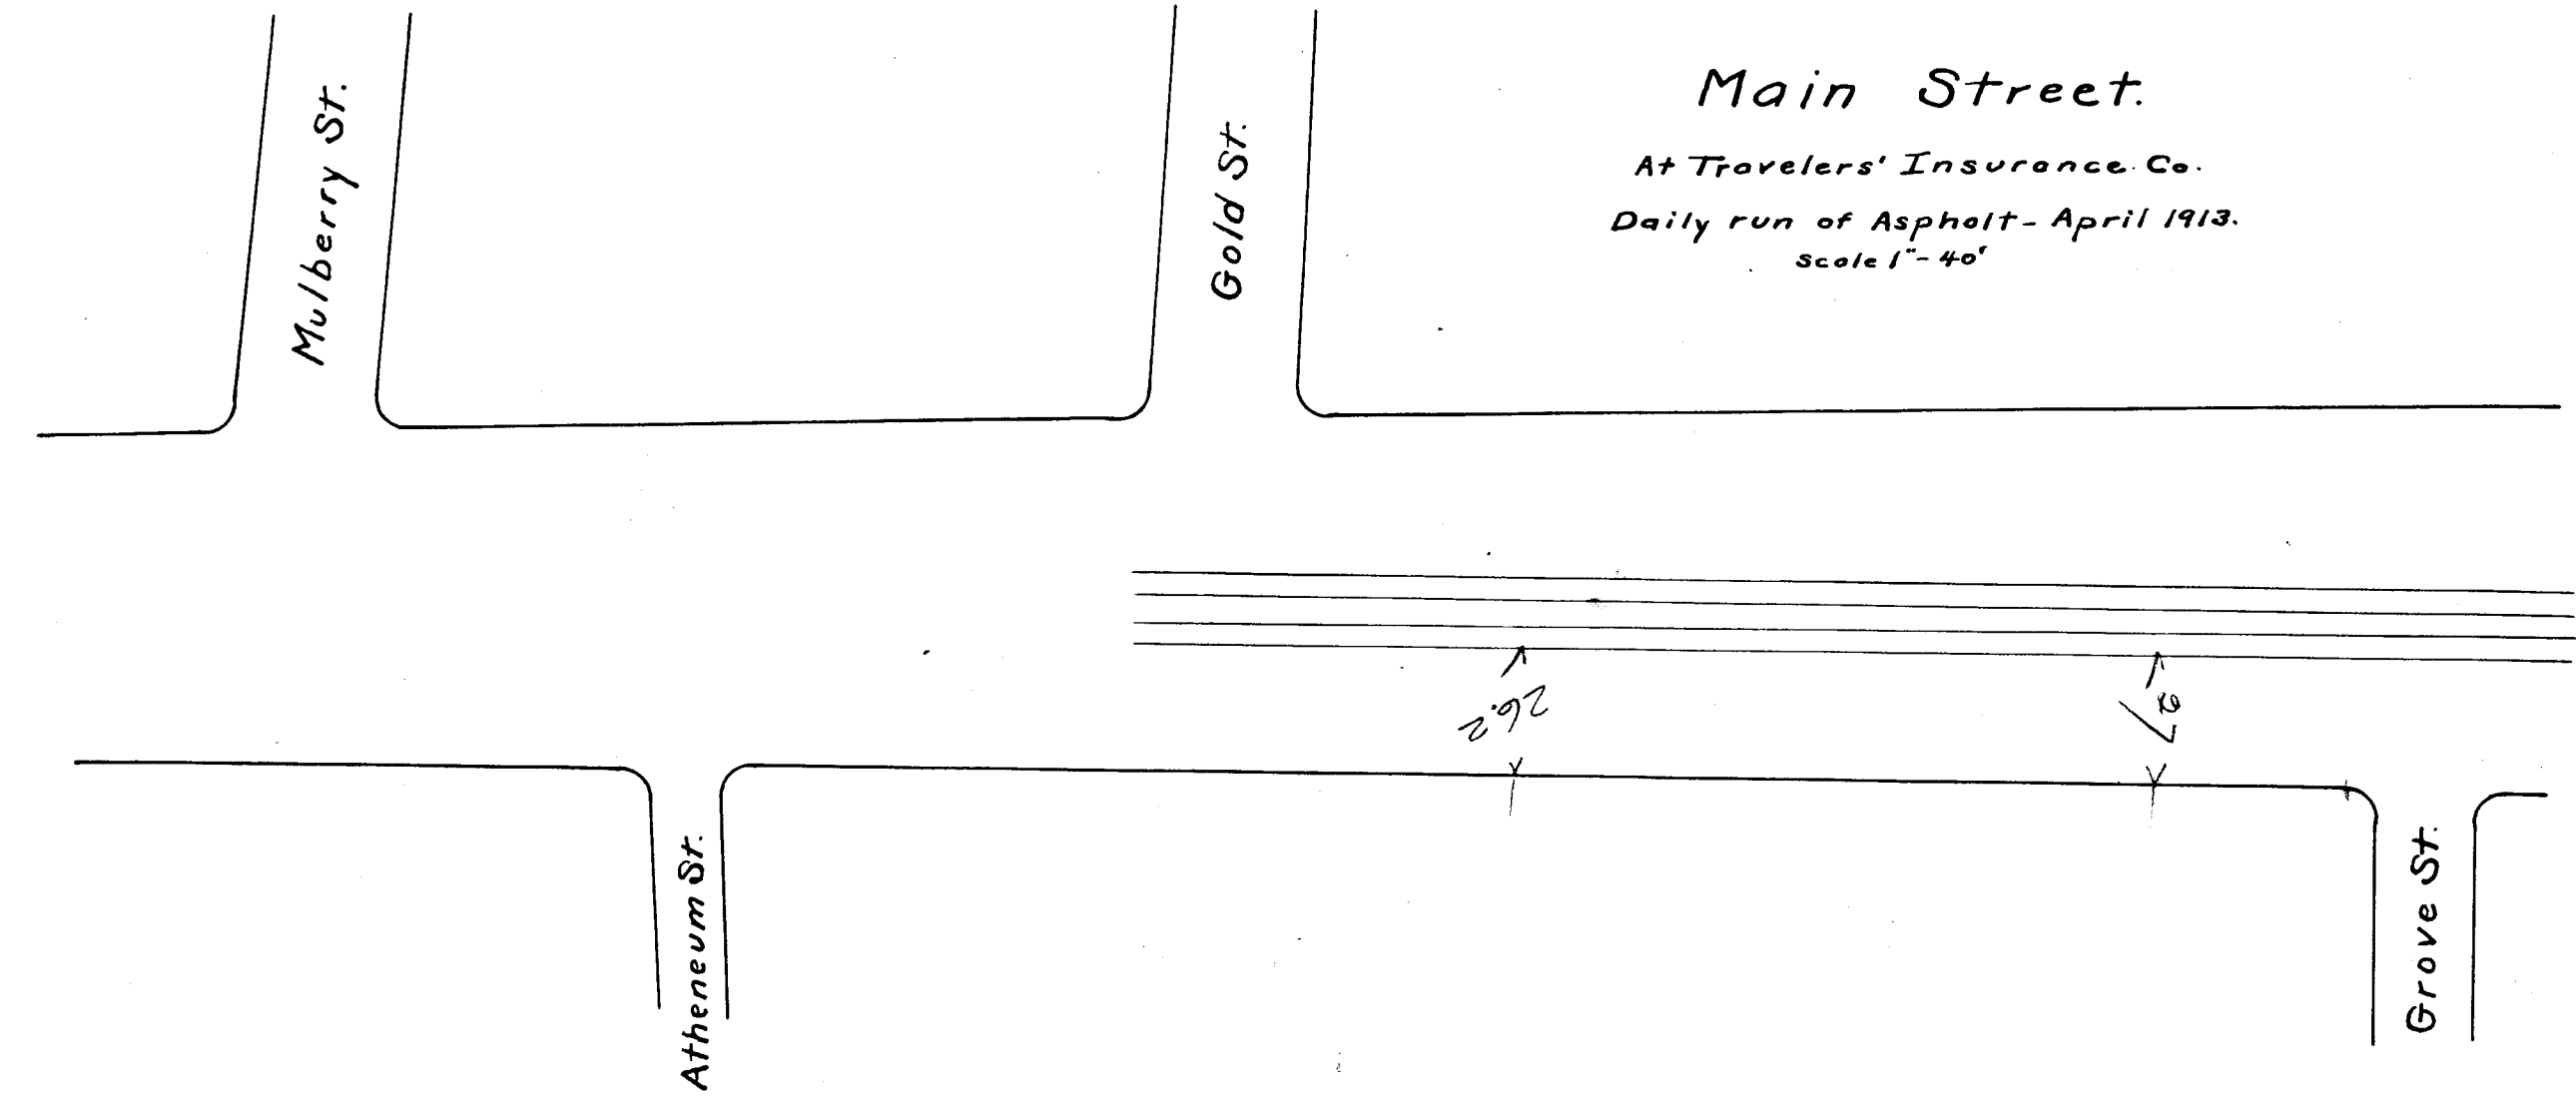

Main Street.
At Travelers' Insurance Co.
Daily run of Asphalt - April 1913.
Scale 1" = 40'

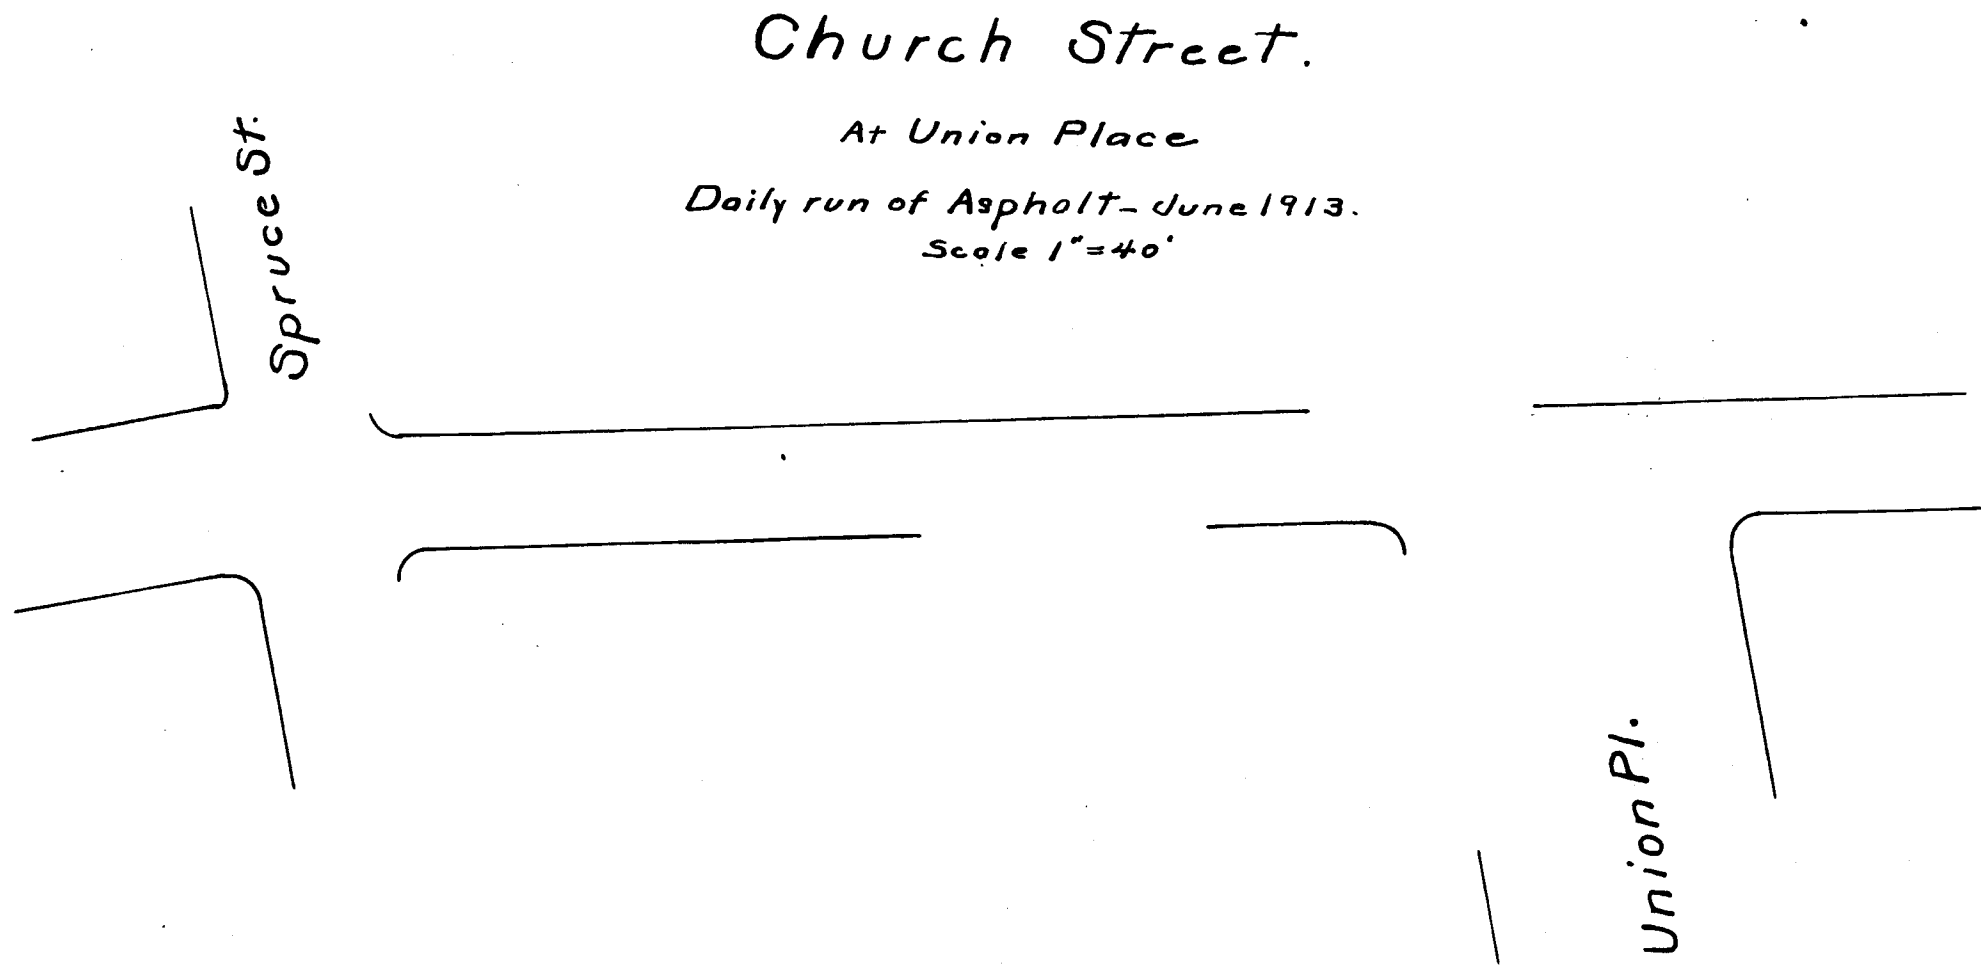

Church Street.
At Union Place
Daily run of Asphalt - June 1913.
Scale 1" = 40'

Jan-1914

03448

03448