


10 17

El. 55

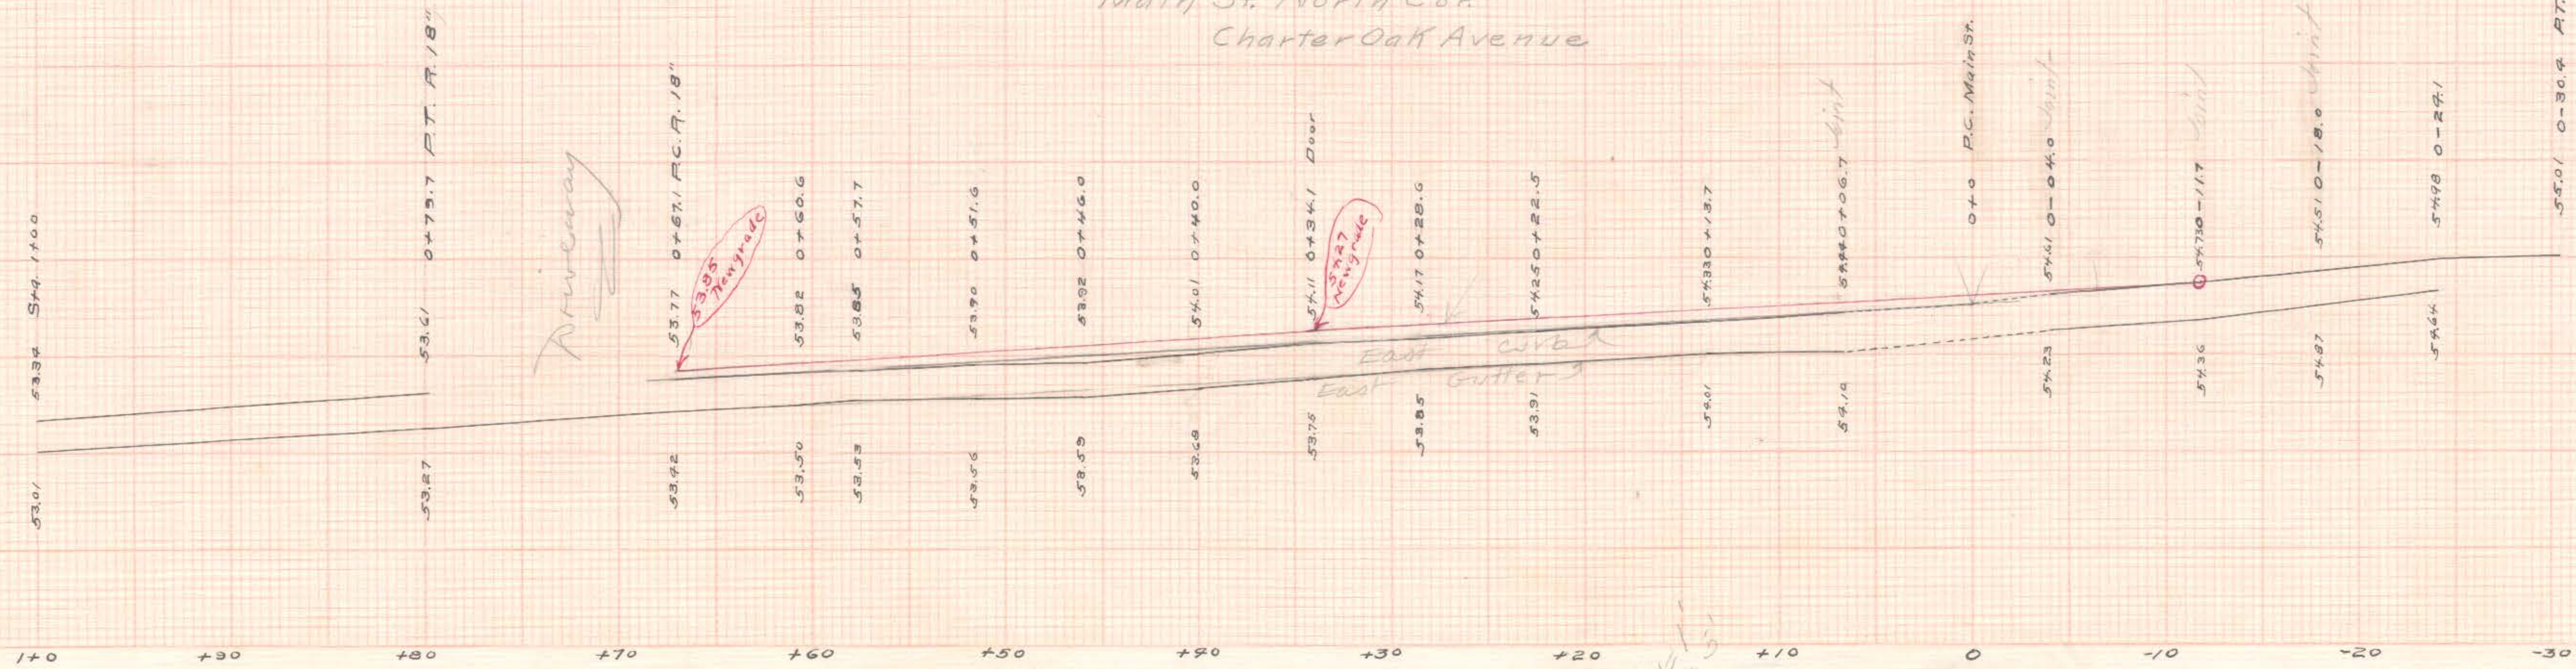

El. 53

* 03558

03 12