


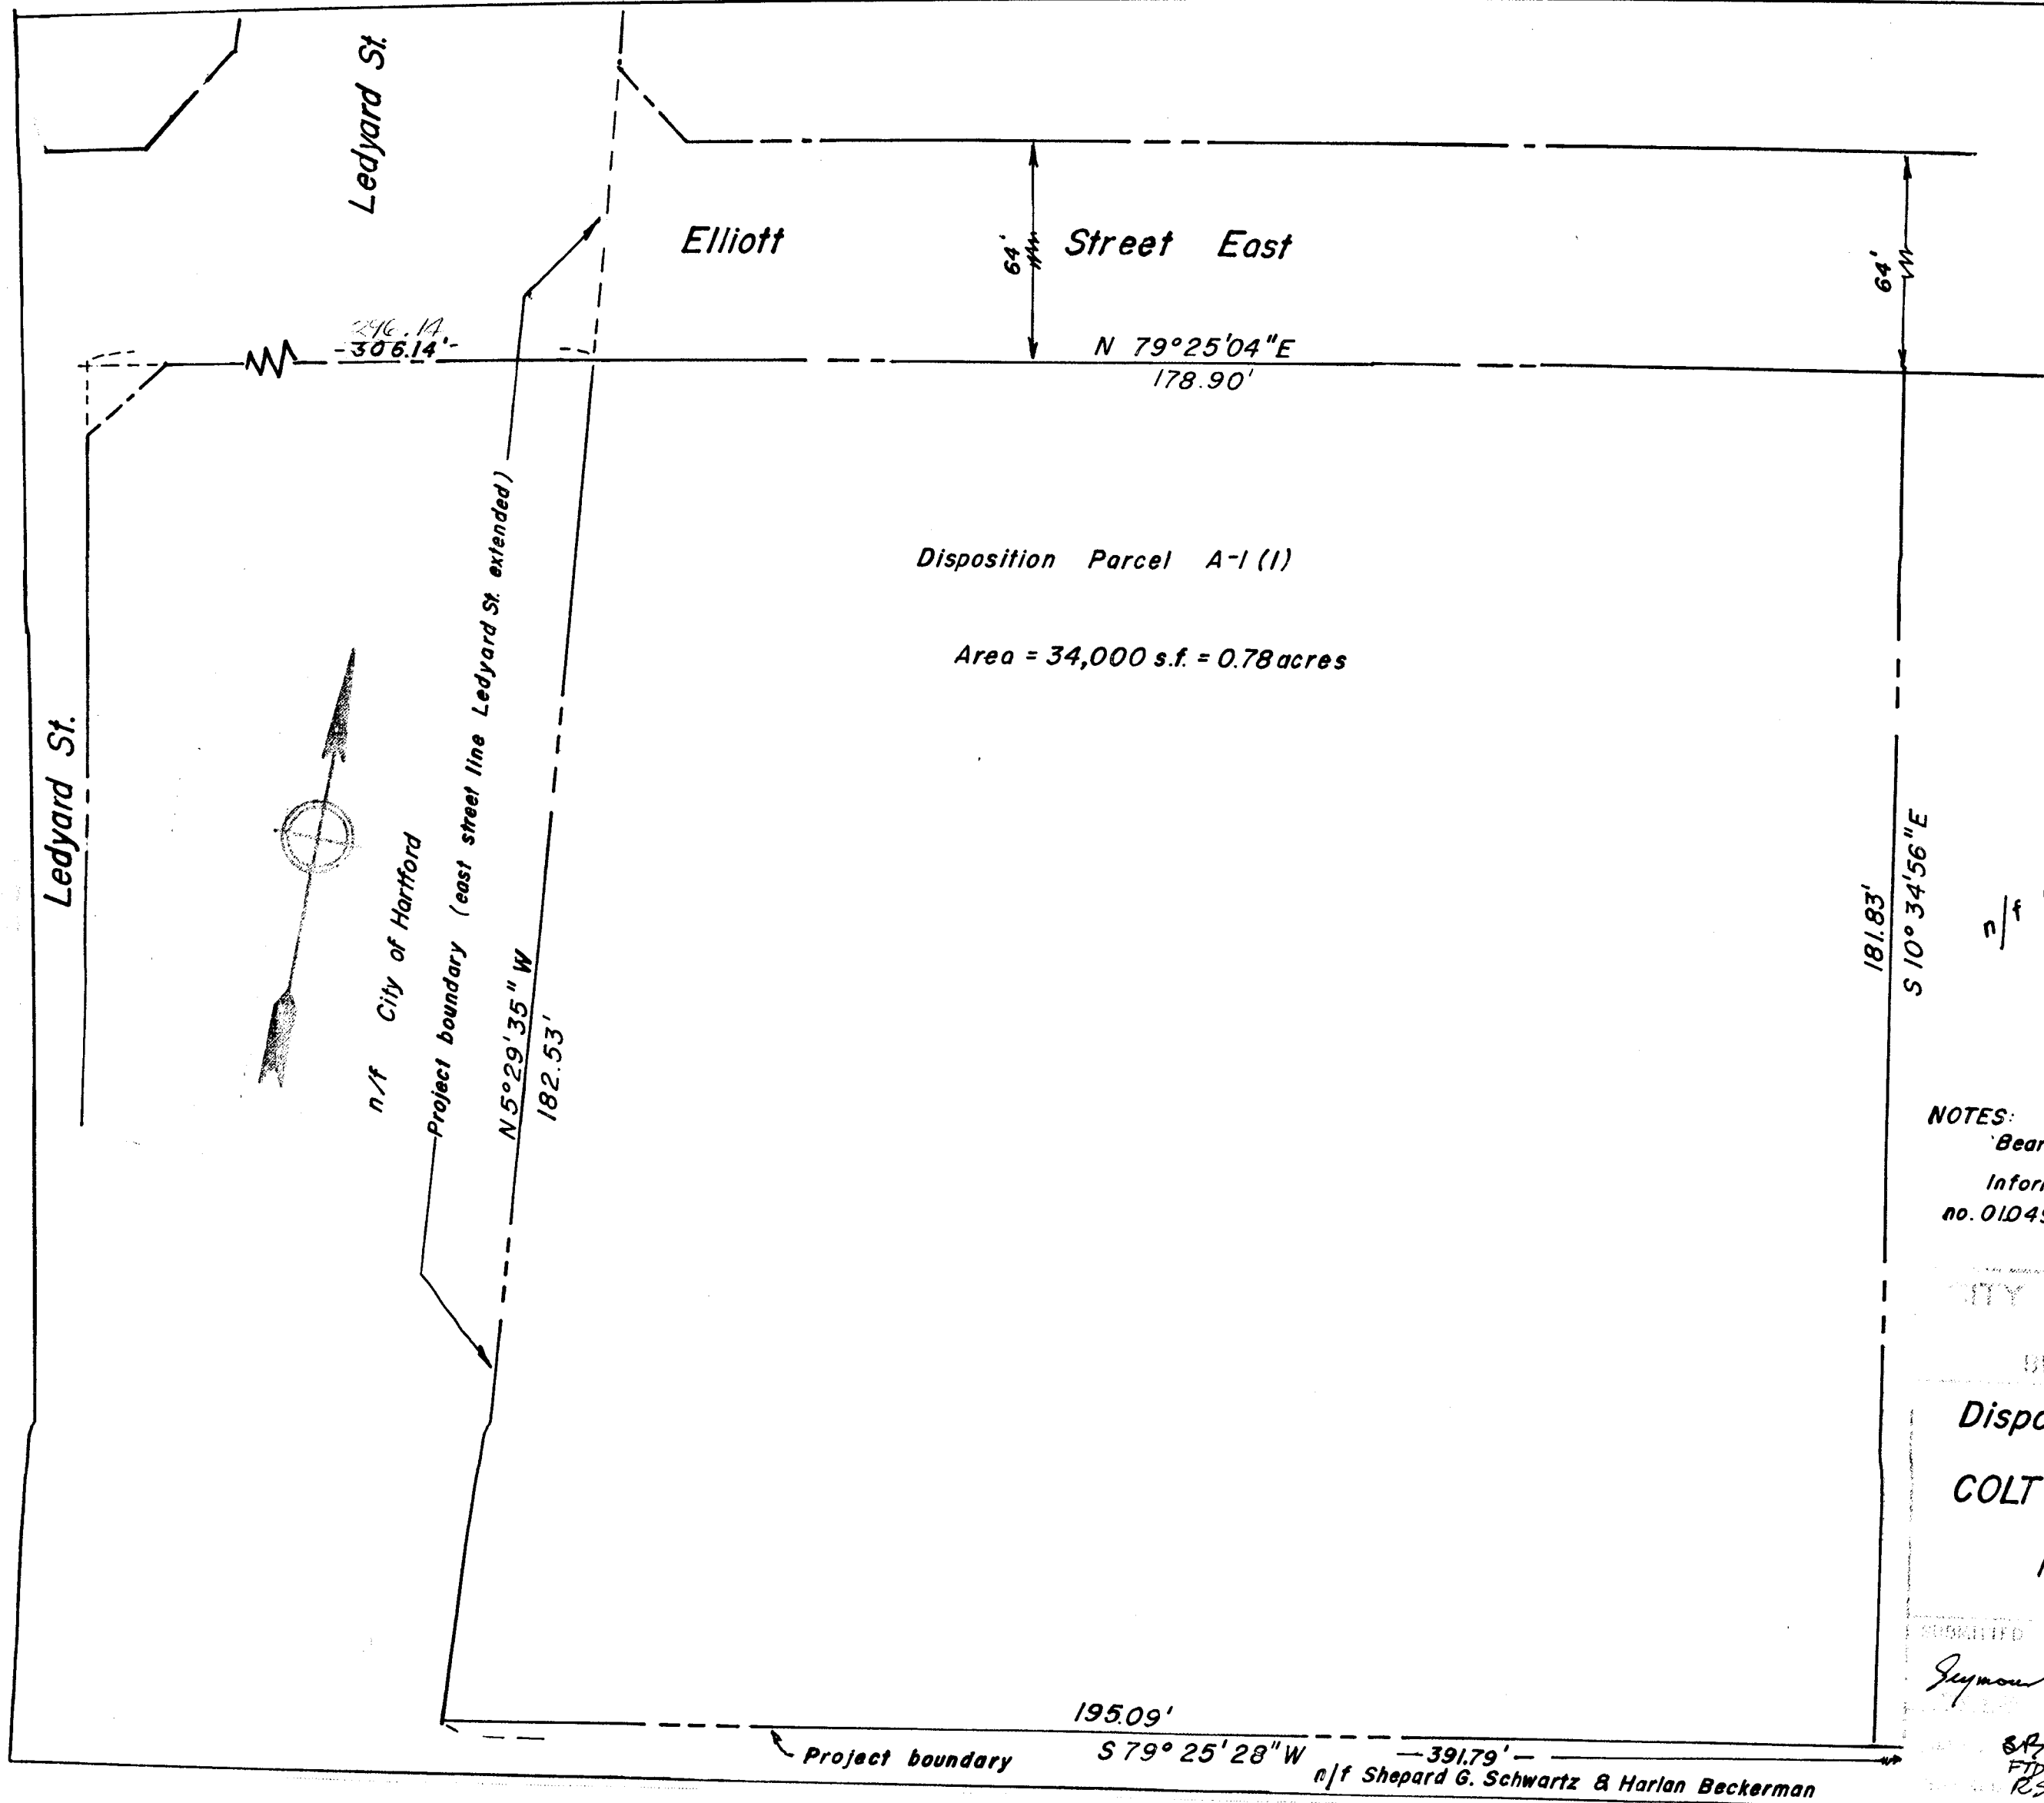

NOTES:
Bearings based on M.D.C. grid system.
Information from map prepared by this Bureau, Daybook
no. 010499 file no. 92/29 dated: 12/74 revised: 1/3/75

CITY OF HARTFORD, CONNECTICUT
DEPARTMENT OF PUBLIC WORKS
BY A.D. ENGINEERING SERVICE

Disposition Parcel A-1 (1)
COLT PARK SOUTH REDEVELOPMENT
HARTFORD CONNECTICUT

SUBMITTED
RECEIVED
Seymour Bayall Russell E. Doeg George E. Hynes
010610
1 inch = 20 feet
June 1977