


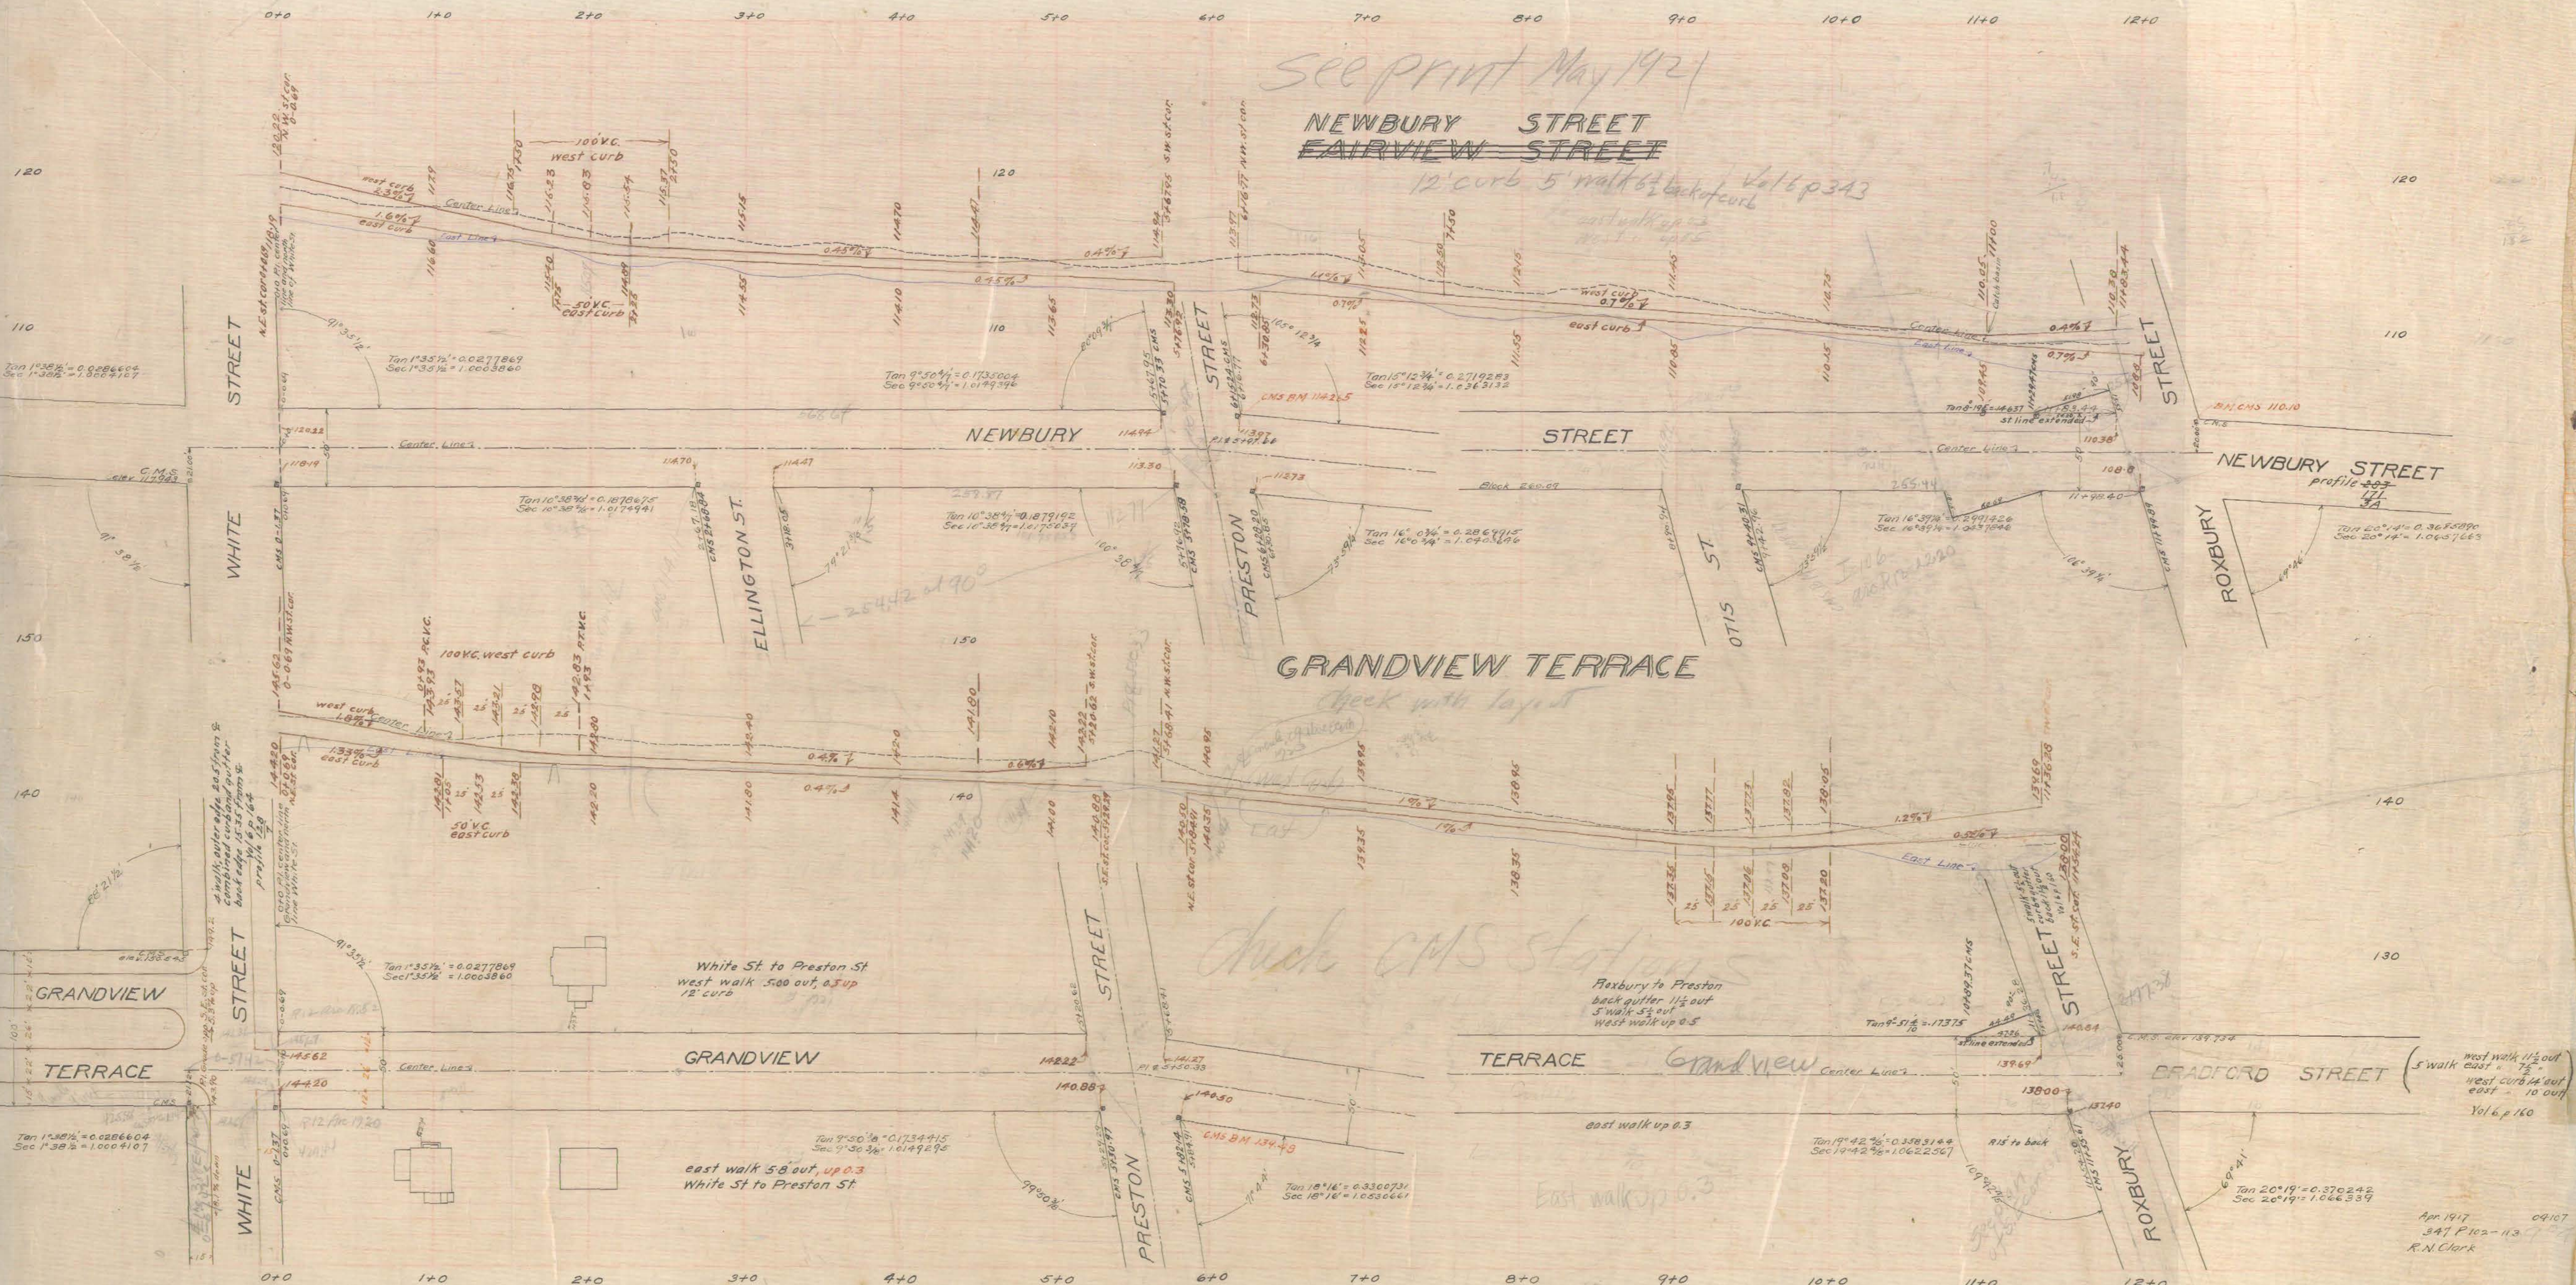

See print May 1921

NEWBURY STREET
~~FAIRVIEW STREET~~

12' curb 5' walk 6' back of curb
Vol 6 p 343

GRANDVIEW TERRACE

check CMS stations

Roxbury to Preston
back gutter 11 1/2' out
5' walk 5 1/2' out
West walk up 0.5

East walk up 0.3

Apr 1917 04/07
347 P 102-113
R.N. Clark