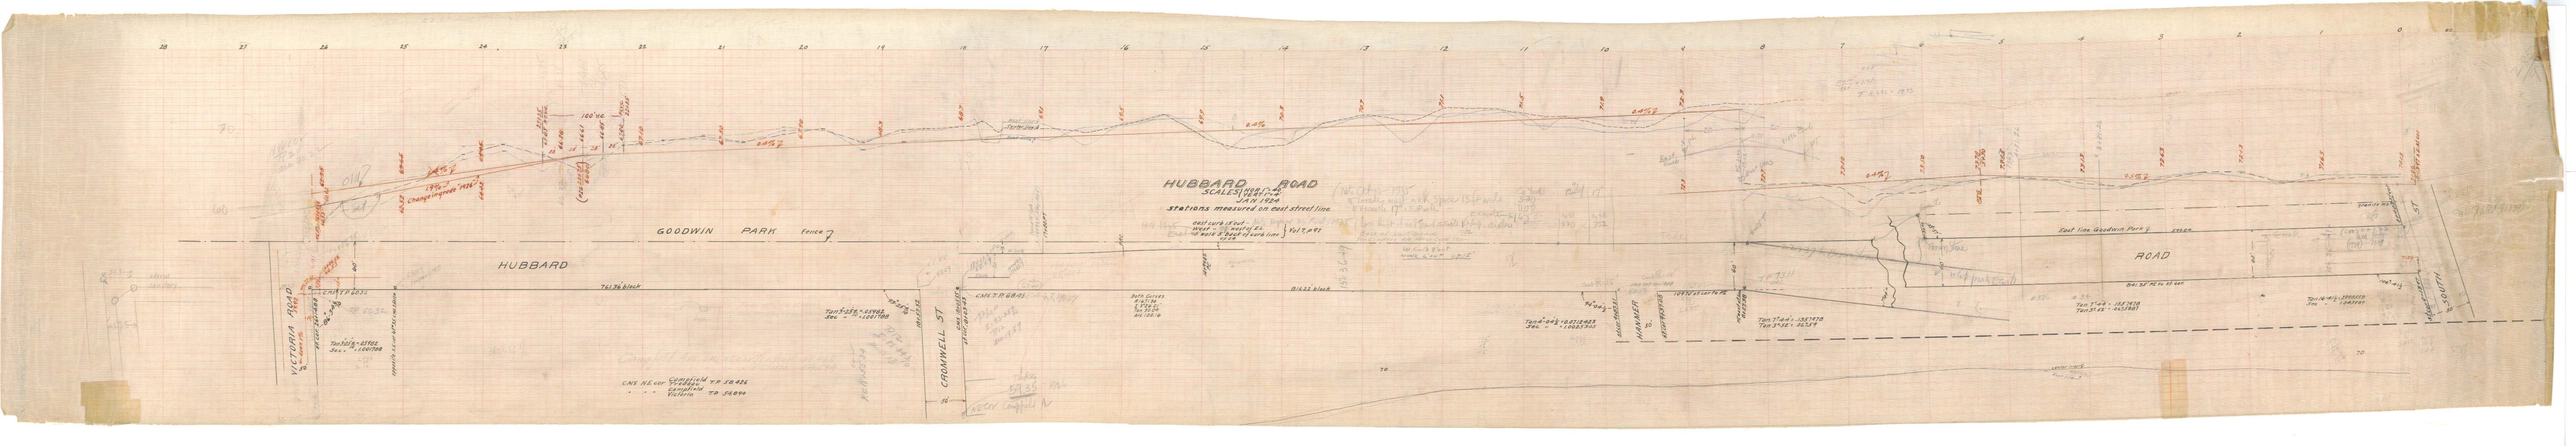
HUBBARD ROAD
SCALES: HORIZ. 1" = 20'
VERT. 1" = 2'
JAN 1924
stations measured on east street line
GOODWIN PARK fence
HUBBARD
ROAD
VICTORIA ROAD
CROMWELL ST
WARNER ST
SOUTH ST
East line Goodwin Park
Changing grade 1936
Tel 36 block
Dial 22 block
C.N.S. N.E. cor Campbell TP 58426
" " " Longford
" " " Victoria TP 58494