


STREET
NILES

AVENUE.
ASYLUM



NOTE: AREAS DESIGNATED "GRASS AREA", "CONC WALK" AND "SHRUBBERY" ARE NOT TO BE PAVED UNDER CONTRACT NO. E-60-410

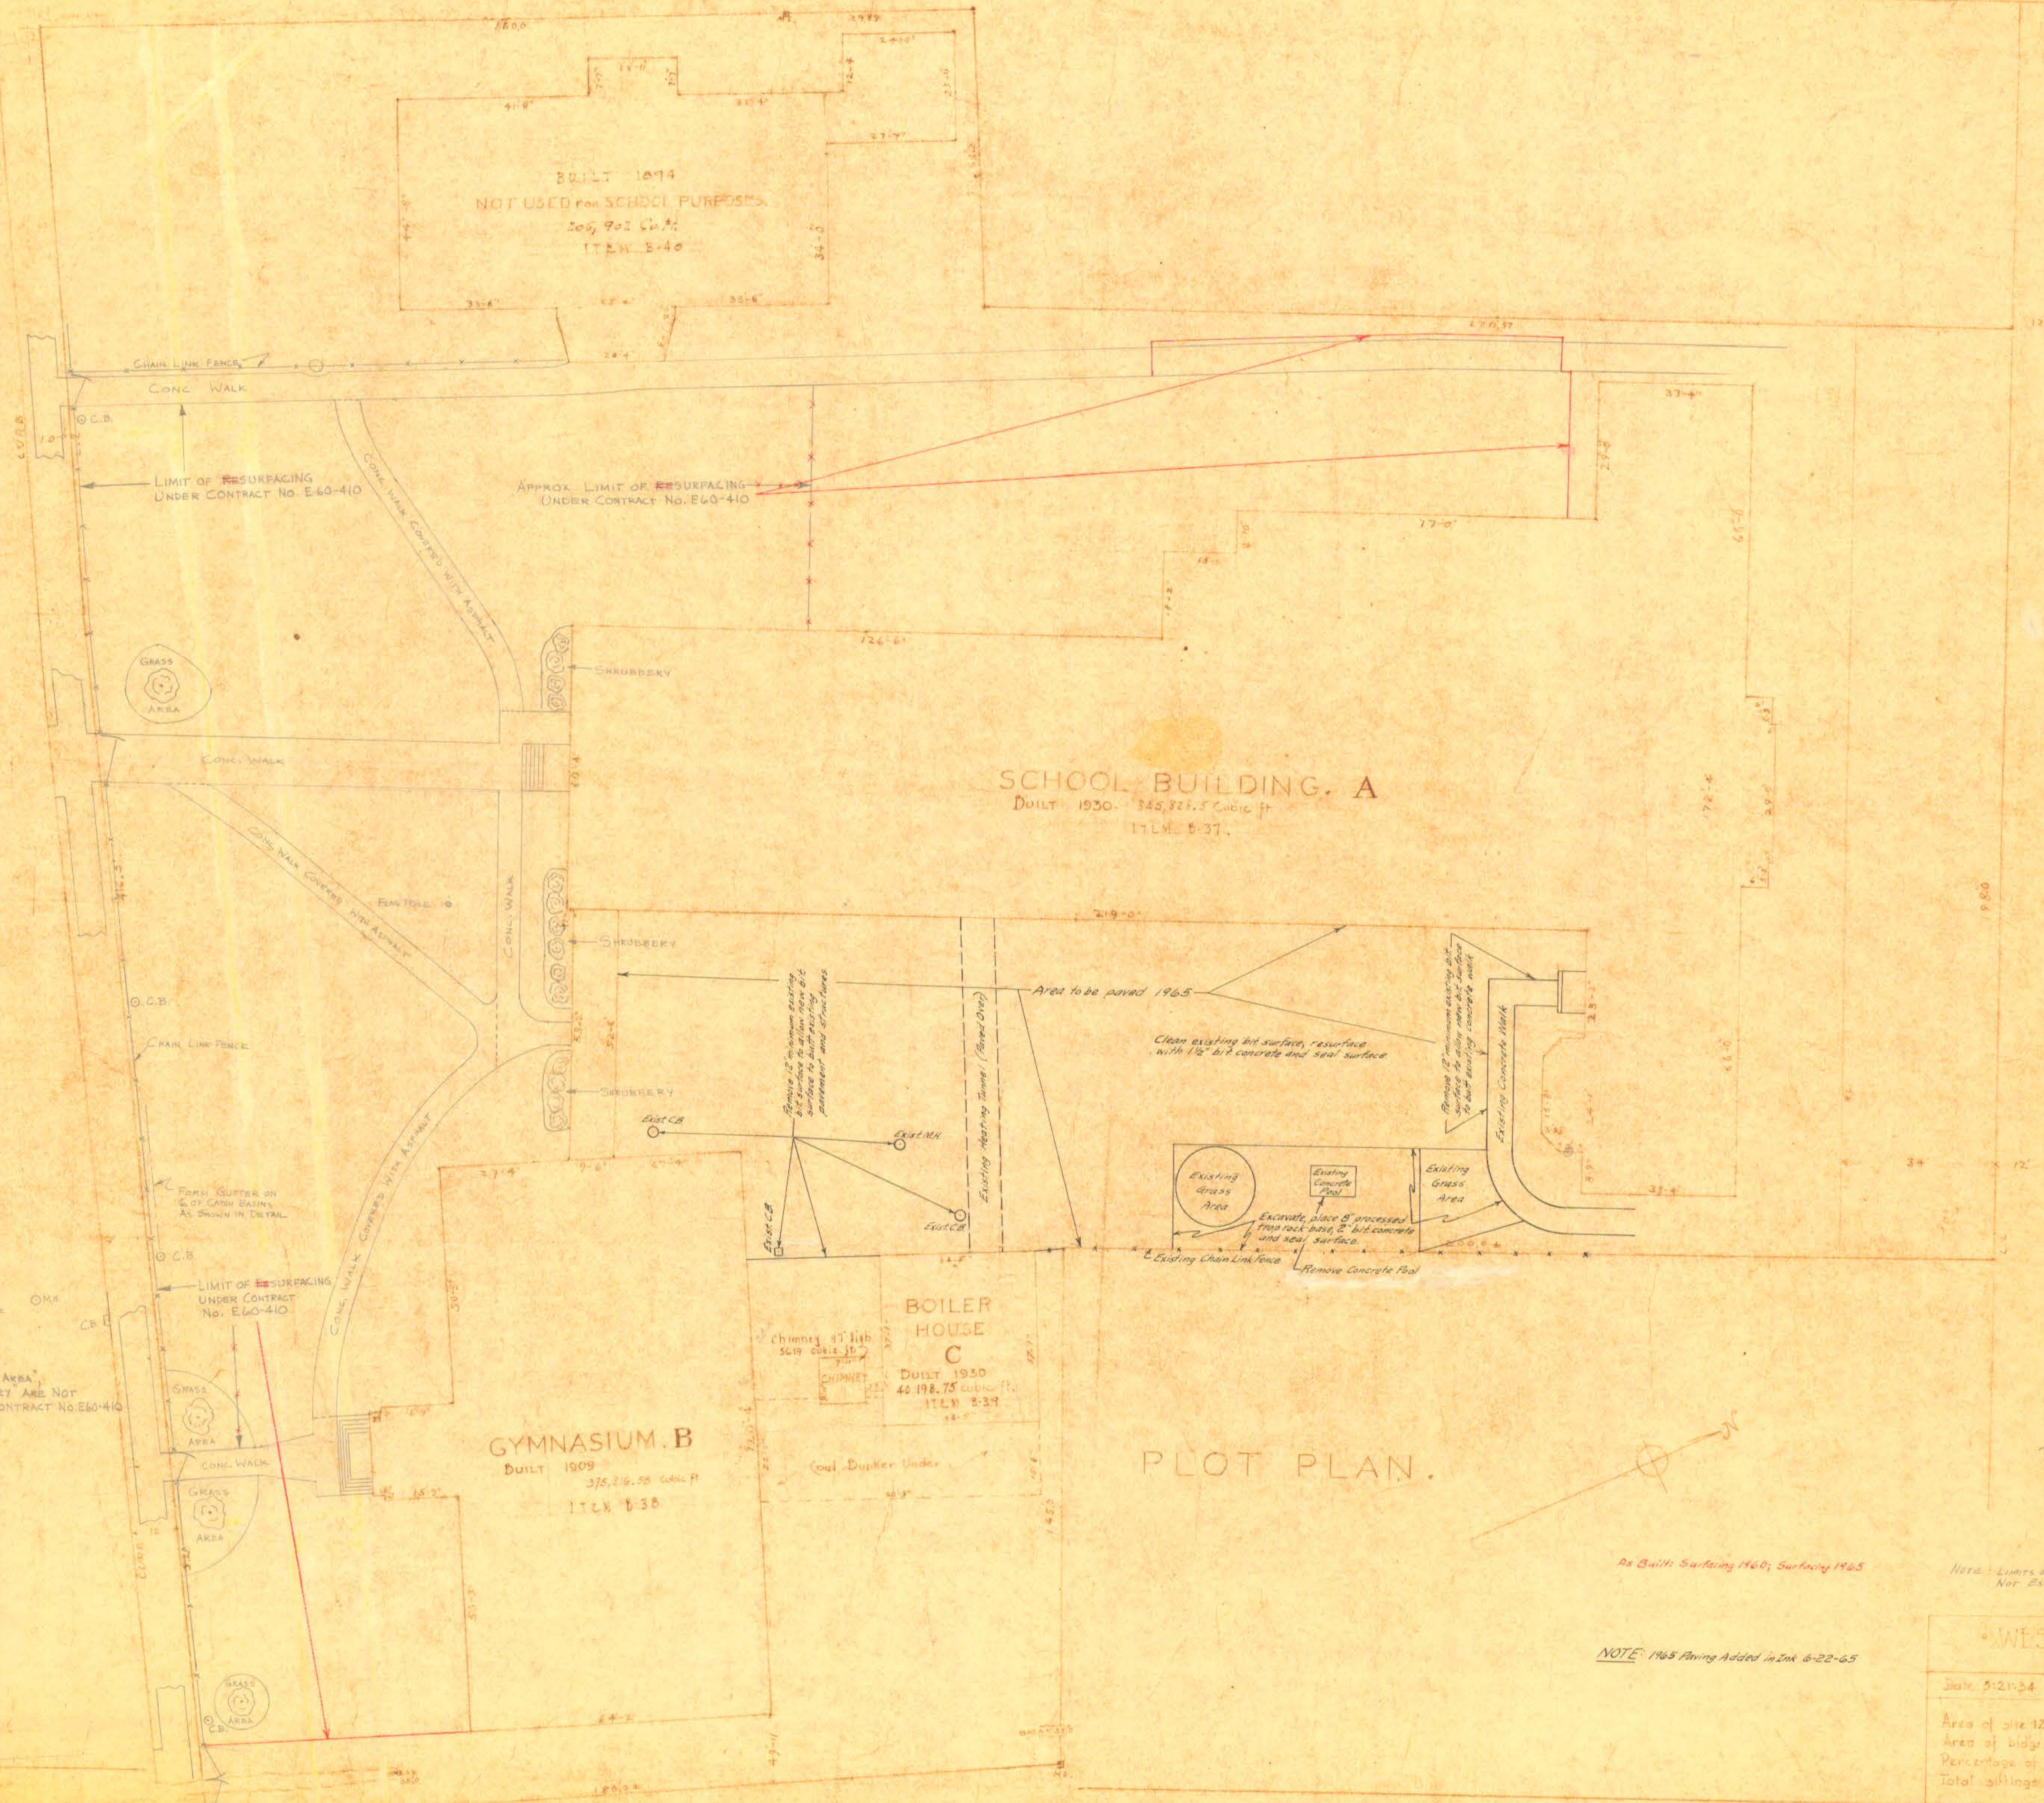

WEST MIDDLE SCHOOL PLAYGROUND

CITY OF HARTFORD
DEPARTMENT OF ENGINEERING
PENCILED DATA ADDED JULY 1960
SCALE 1"=16'-0" DAY BOOK NO. 09641

NOTE: LIMITS OF WORK COMPLETED UNDER CONTRACT E-60-410 NOT EXACTLY AS SHOWN ON PLAN 7/21/61 W.D.J.
ITLW 5-37, 5-38, 5-39 & 5-40

WEST MIDDLE SCHOOL
927 ASYLUM AVE.

Date 5-21-64 Scale 1/4 inch = 1 foot Drawn by W.D.J.
Area of site 122,543.18 Total Floor Area 58,707.33
Area of building ground level 31,722.5
Percentage of site occupied by bldgs 25.9%
Total girders 570 (Cubic feet in bldgs 1,268,831.58)