


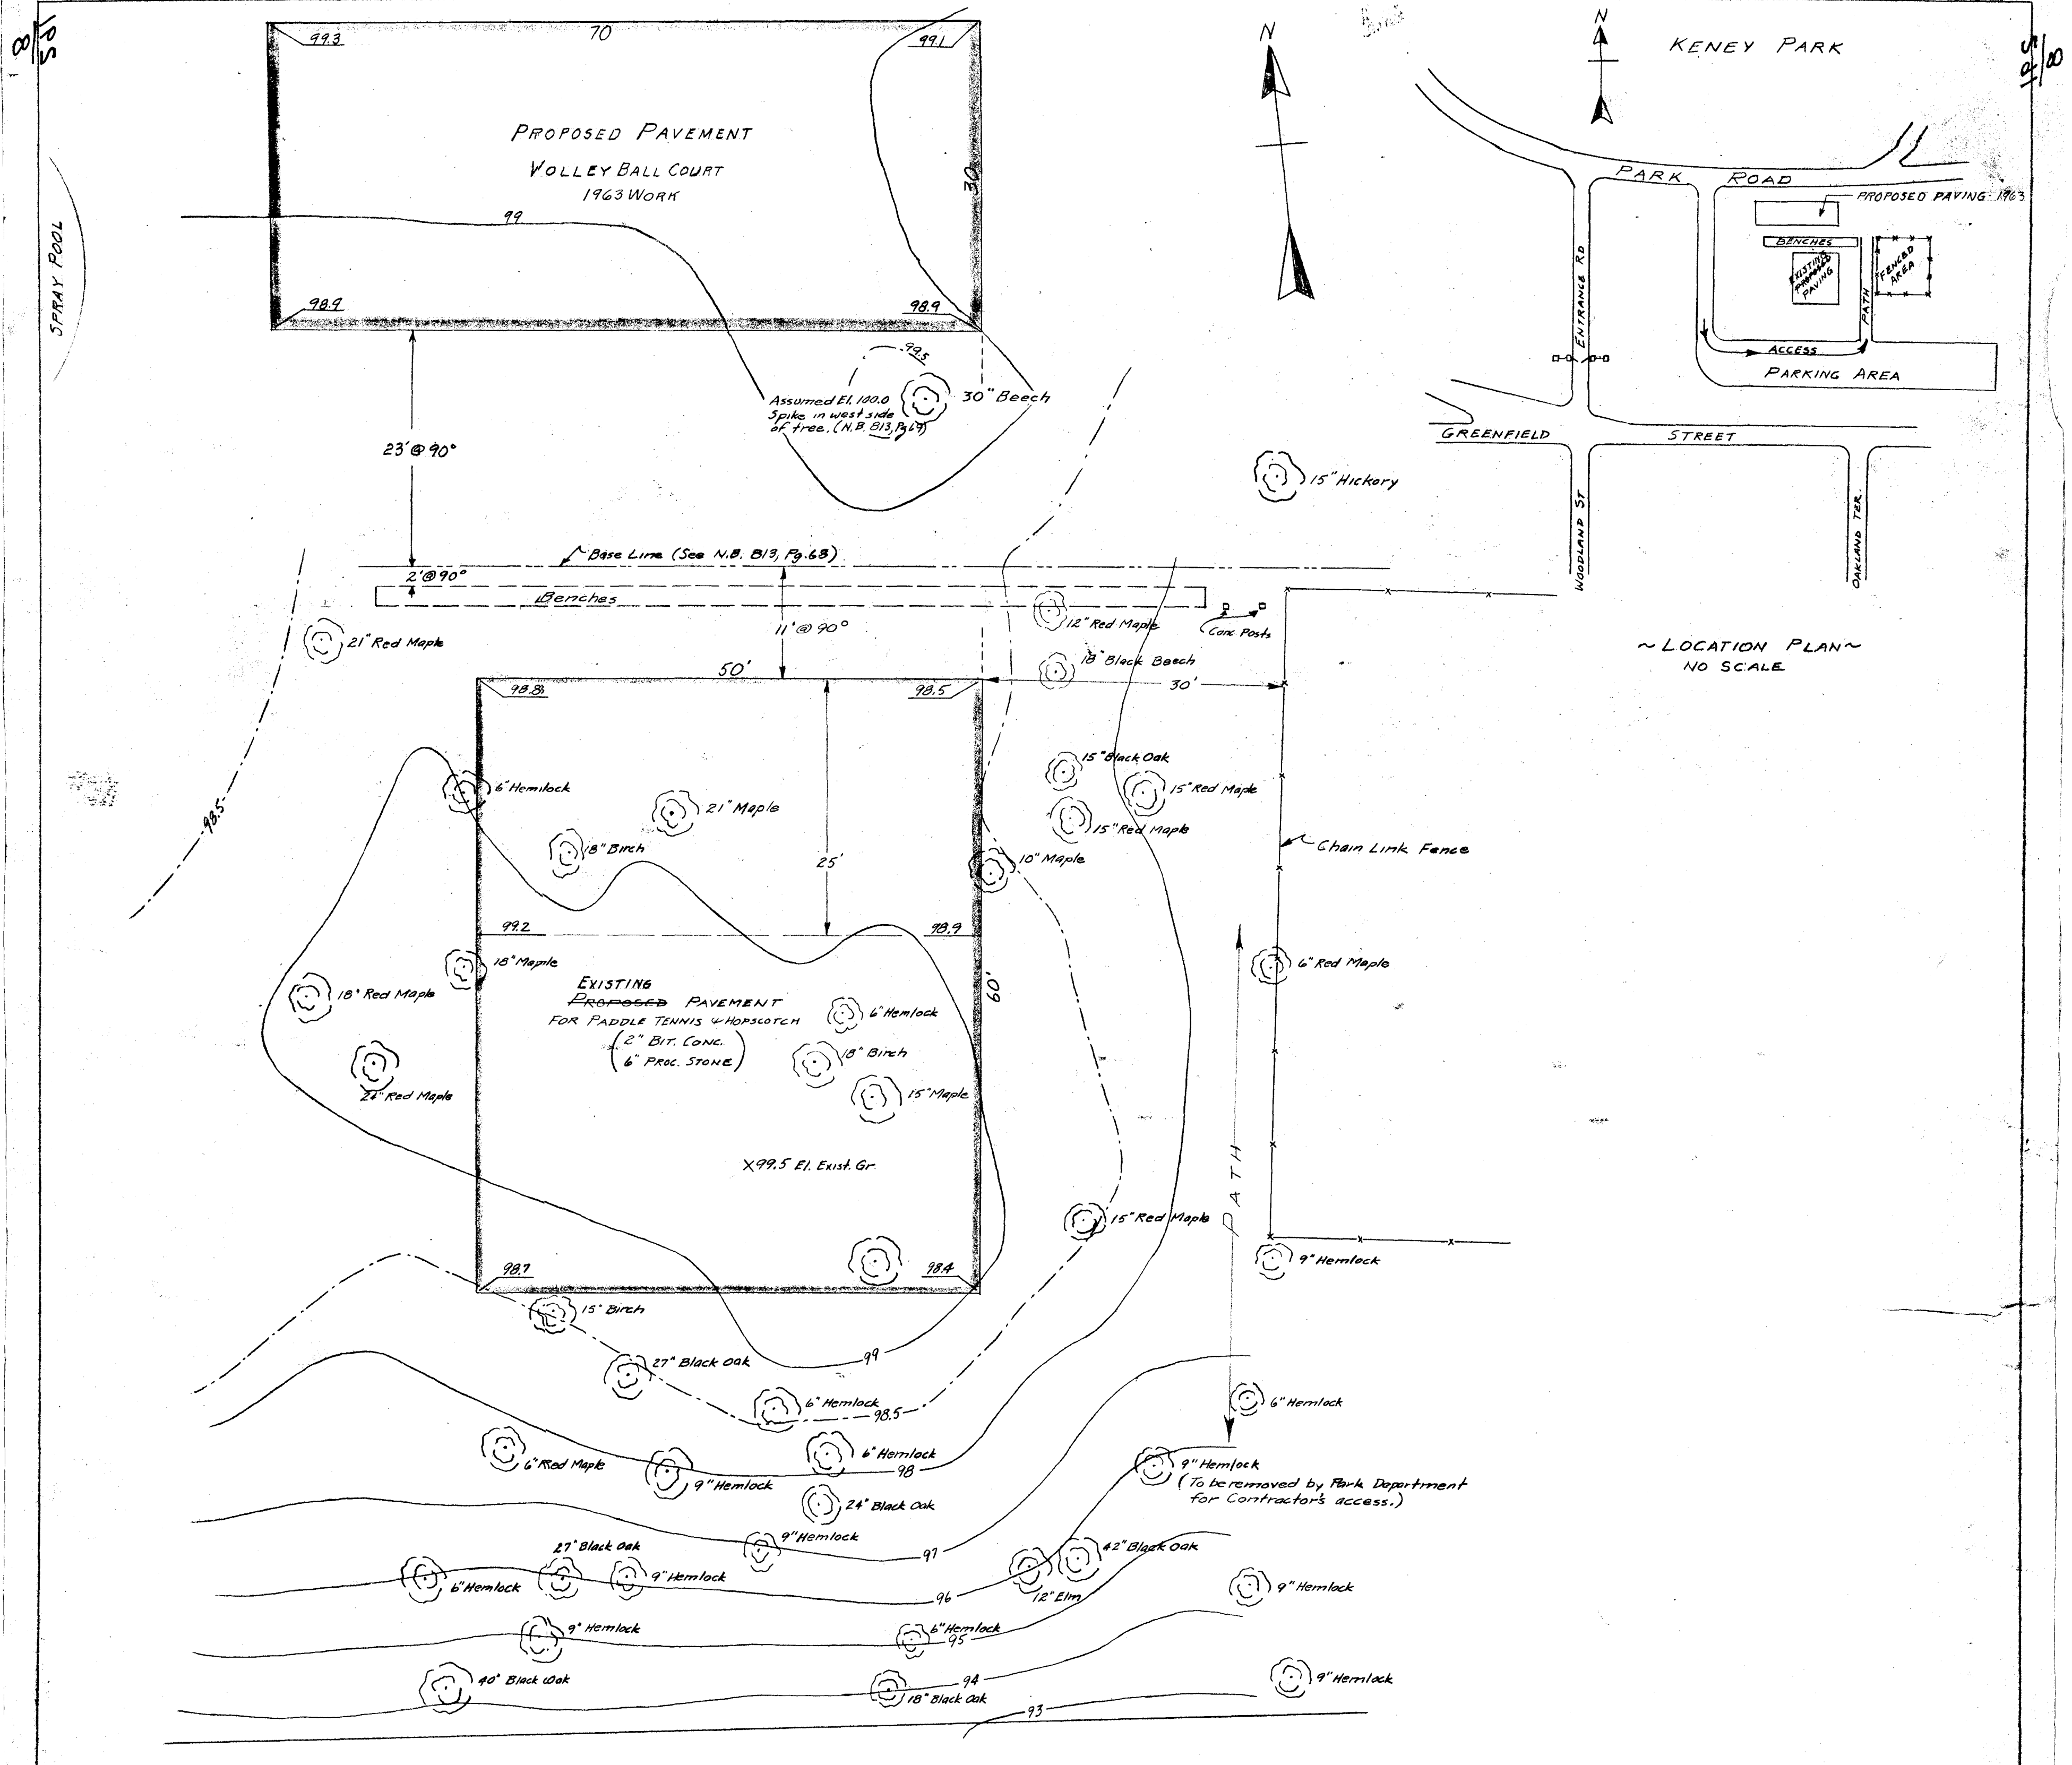

NOTE - Contours are existing ground.
 Proposed paving grades are underlined.
 All trees within and adjacent to paved area
 to be removed by Park Department.
 All grades based on assumed elevation 100.00 at 30\"/>

CITY OF HARTFORD, CONNECTICUT DEPARTMENT OF ENGINEERING		
KENEY PARK PADDLE TENNIS COURTS AT KENEY - WOODLAND PLAYGROUND		
SCALE 1"=10'-0"		
SUBMITTED <i>George E. Heppner</i> DIV. OF ENGINEERING	RECOMMENDED ASST. CITY ENG.	APPROVED <i>Arthur H. Bellow</i> CITY ENGINEER
DESIGN	DRAWN <i>E.J.P.</i>	DAYBOOK NO. 09720
TRACED <i>E.J.P.</i> CHECK <i>G.E.H.</i>		DATE AUGUST 1962