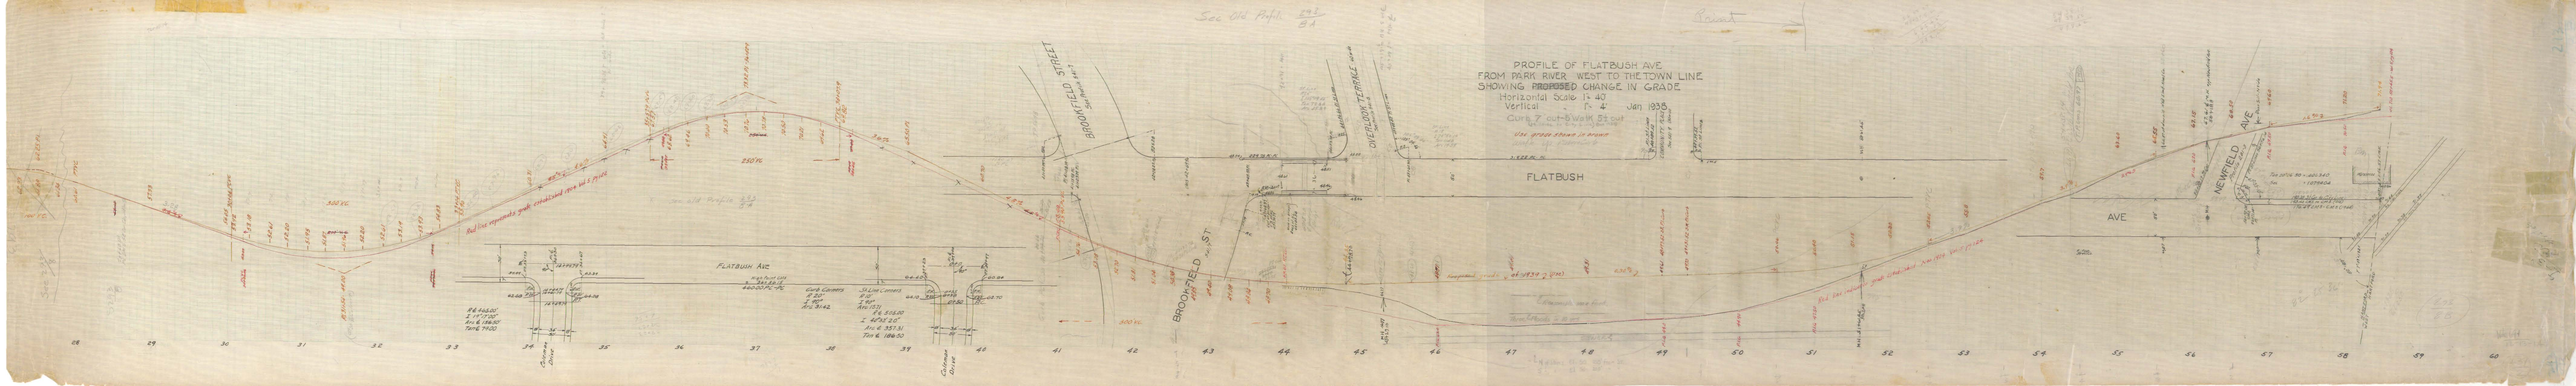
PROFILE OF FLATBUSH AVE.
FROM PARK RIVER WEST TO THE TOWN LINE
SHOWING PROPOSED CHANGE IN GRADE
Horizontal Scale 1" = 40'
Vertical " 1" = 4'
Jan 1938
Curve 7' cut - 5' Walk 54' cut
Use green shown in brown
See Old Profile 194/84
Present
BROOKFIELD STREET
See Sheet No. 3
FLATBUSH
AVE
NEWFIELD AVE
BROOKFIELD ST
FLATBUSH AVE
Curve Cover
Curve Cover
Curve Cover
Old Profile
Old Profile
Old Profile