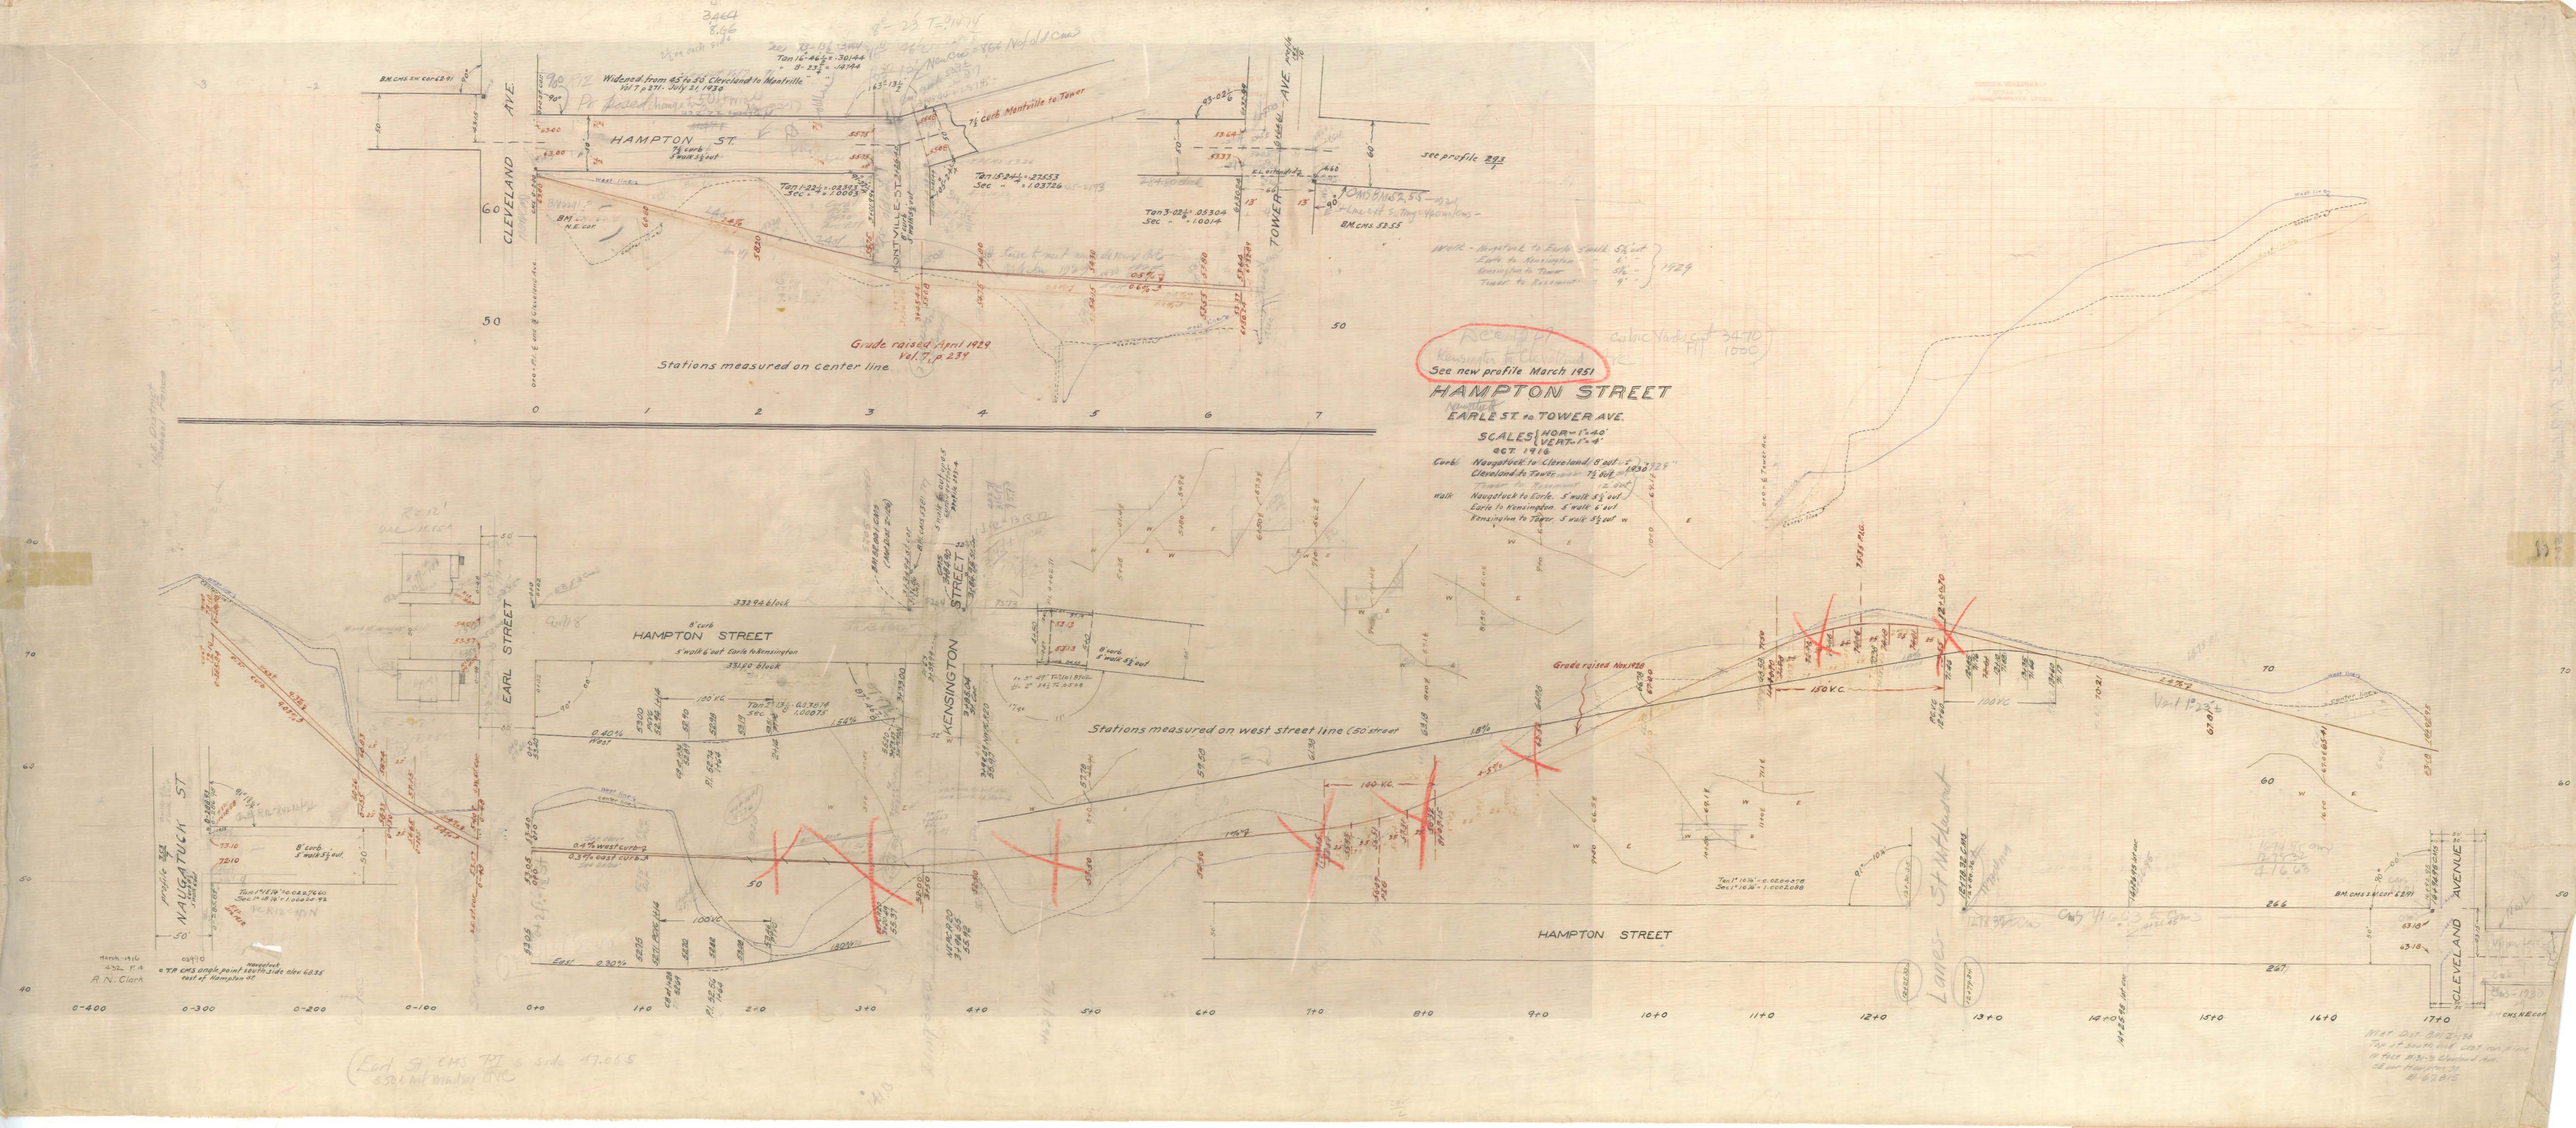
HAMPTON STREET
EARLE ST. to TOWER AVE.
SCALES { HOR. = 1" = 40'
VERT. = 1" = 4'
OCT. 1916
Curb: Naugatuck to Cleveland 8" out
Cleveland to Tower 7½" out
Tower to Basement
Walk: Naugatuck to Earle 5' walk 5½" out
Earle to Kensington 5' walk 6" out
Kensington to Tower 5' walk 5½" out
See new profile March 1951
Grade raised April 1929
Vol. 7, p. 234
Stations measured on center line
Widened from 45' to 50' Cleveland to Montville
Vol. 7, p. 271 - July 21, 1930
7½" curb Montville to Tower
CLEVELAND AVE
MONTVILLE ST
TOWER AVE
see profile
BM CMS 53.55
Work - Naugatuck to Earle 5' walk 5½" out
Earle to Kensington 6"
Kensington to Tower 5½"
Tower to Basement 9"
1929
Grade raised Nov. 1926
Stations measured on west street line (50' street)
EARL STREET
KENSINGTON STREET
NAUGATUCK ST
HAMPTON STREET
8" curb
5' walk 6" out Earle to Kensington
8" curb
5' walk 5½" out
0.40% west
0.30% east
0.04% west curb-7
0.37% east curb-3
100' V.C.
150' V.C.
March 1916
A. N. Clark
Naugatuck
0.7' ⊕ CMS angle point south side abv 6835
east of Hampton St.
Lanes St. Wetland
CLEVELAND AVENUE
BM CMS & N Cor 2291
BM CMS N Cor
0-400
0-300
0-200
0-100
0+0
1+0
2+0
3+0
4+0
5+0
6+0
7+0
8+0
9+0
10+0
11+0
12+0
13+0
14+0
15+0
16+0
17+0