


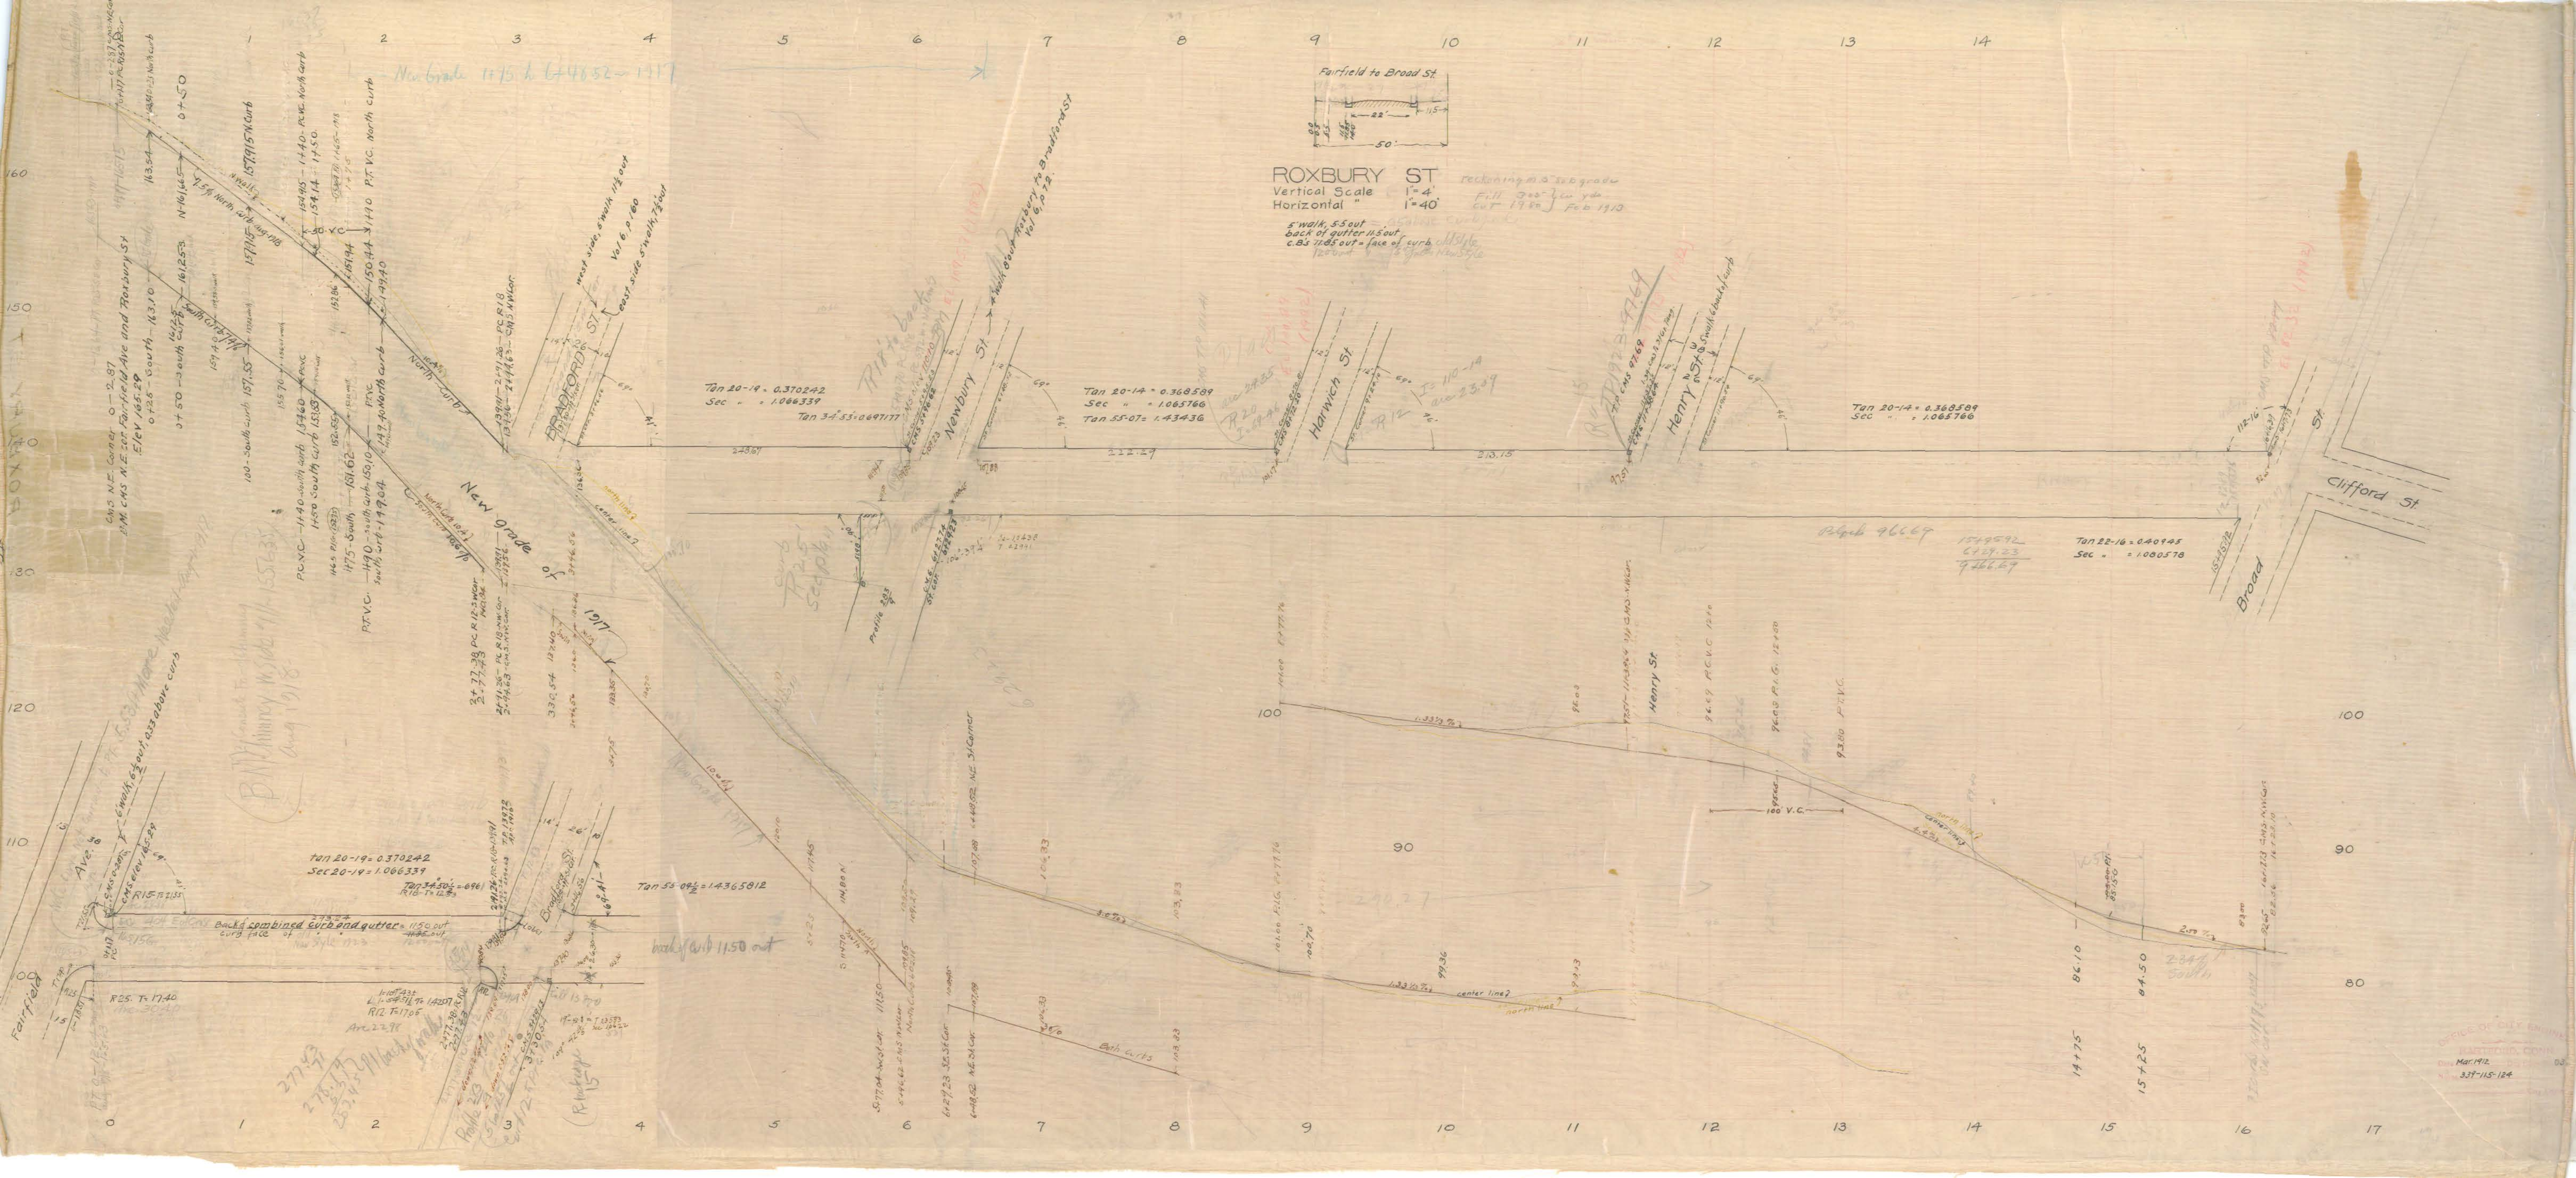

ROXBURY ST
Vertical Scale 1" = 4'
Horizontal " 1" = 40'
reckoning P.S. to grade
Cut 17.80 Feb 1913
5' walk, 5.5' out
back of gutter 11.5' out
c.B. 71.65' out = face of curb old style
12.00' out = face of curb new style