


CANAAN ST

CANAAN STREET

SCALES { HOR 1" = 40'
VERT 1" = 4'

Vol 6 p 239
May 1929 ex 16 1/2 Road 36
Sheet 6

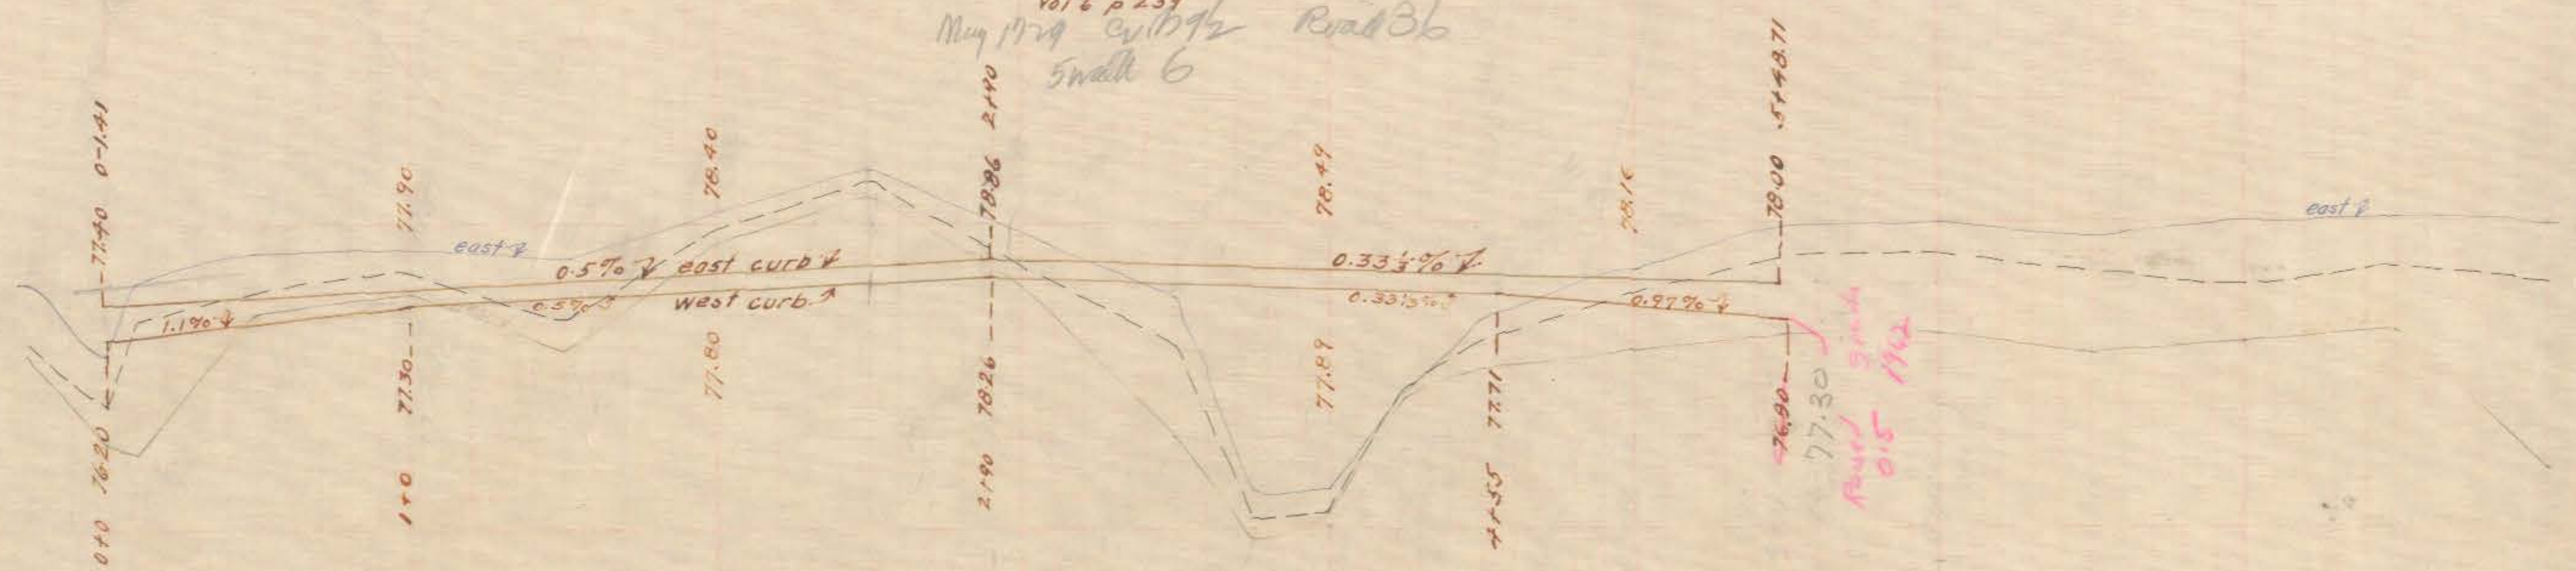

tan 3-44 = .065251
sec " = 1.00213

profile 305
8

STREET

BURNHAM

Curb Corner
P15
76.93
Tan 1°28' = 0.0256620
Sec 1°28' = 1.0003292

CANAAN STREET

Curb Corner
P18
76.93
Tan 1°28' = 0.0256620
Sec 1°28' = 1.0003292

EUCLID ST WEST

Curb Corner
P20
78.27
Tan 1°28' = 0.0256620
Sec 1°28' = 1.0003292

Curb Corner
P22
78.27
Tan 1°28' = 0.0256620
Sec 1°28' = 1.0003292

ST WEST

MORNINGSIDE