

0 1 2 3 4 5 6 7 8

80


70

60

80

70


60

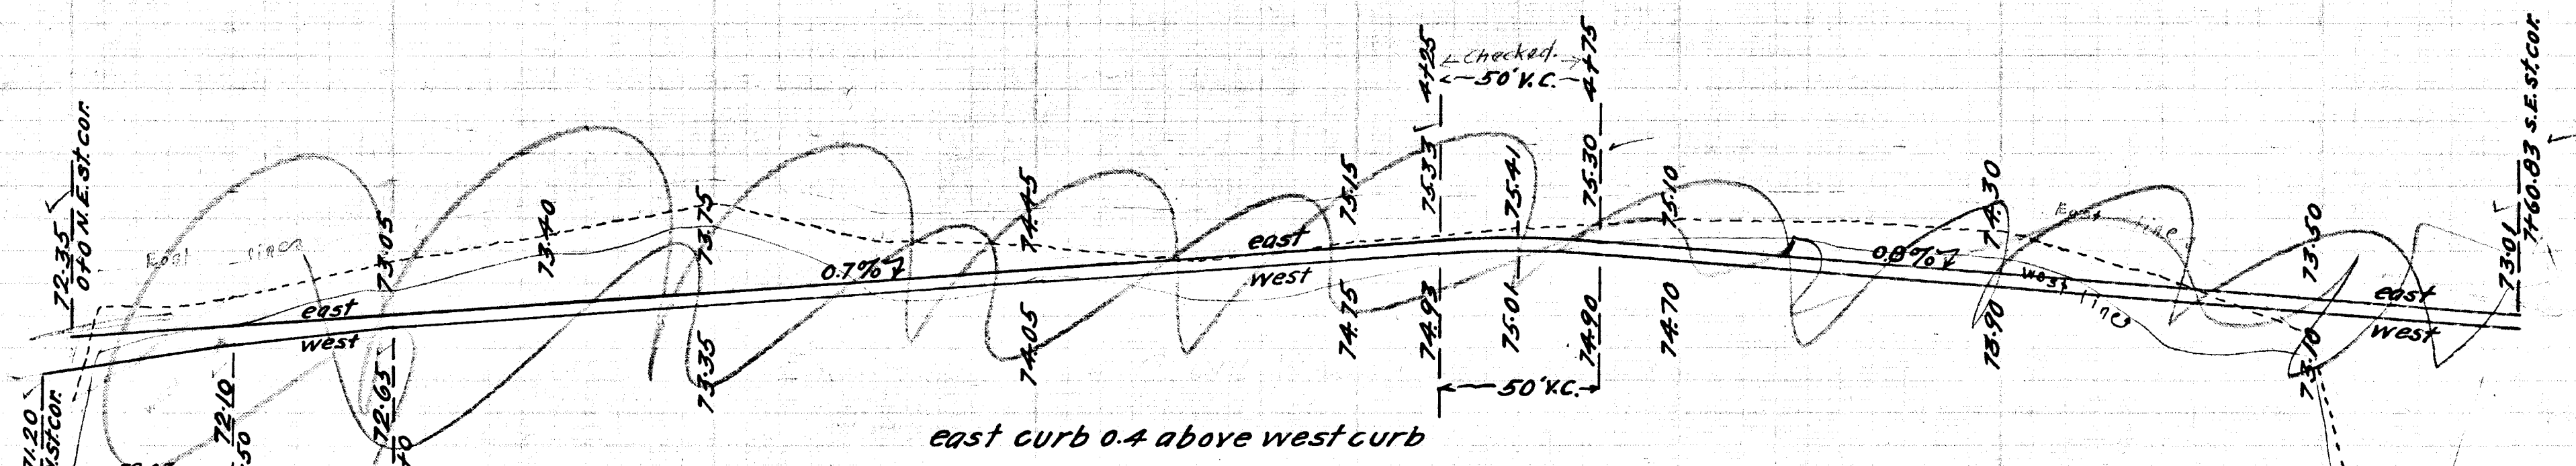

See Granby St
WESTBROOK STREET
SCALES { HOR 1"=40'
VERT 1"=4'

AVENUE 124
profile 124
13

0+903 st corner
0+0 N.E. st corner

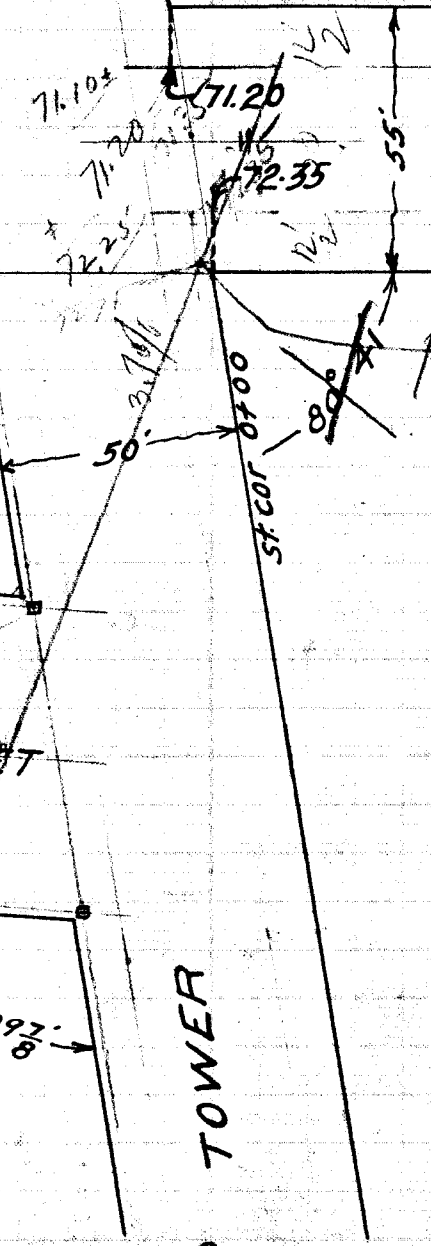


WESTBROOK

Discontinued Line Change

STREET

760.83

Proposed (C.W.) 72.35
Tan 9°19' = .164055
Sec " = 1.013368

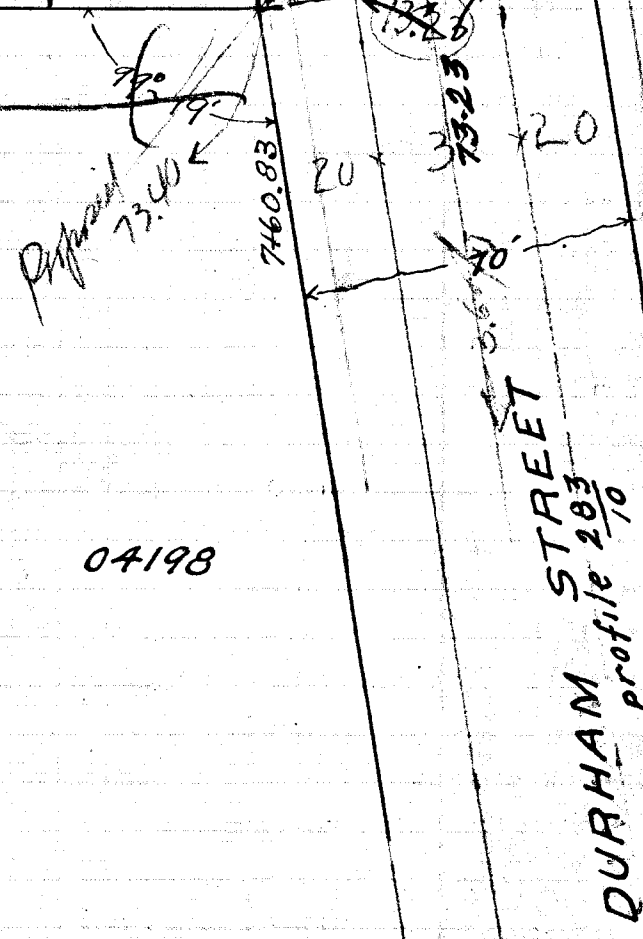

DURHAM STREET
profile 203
10

Feb 1917
428
109

04198

TOWER

Tan 13°09' = .233896
Sec " = 1.02699

0 1 2 3 4 5 6 7 8