


B.B.M. and door sill entrance. 280-2 280-2
tele 5087-19

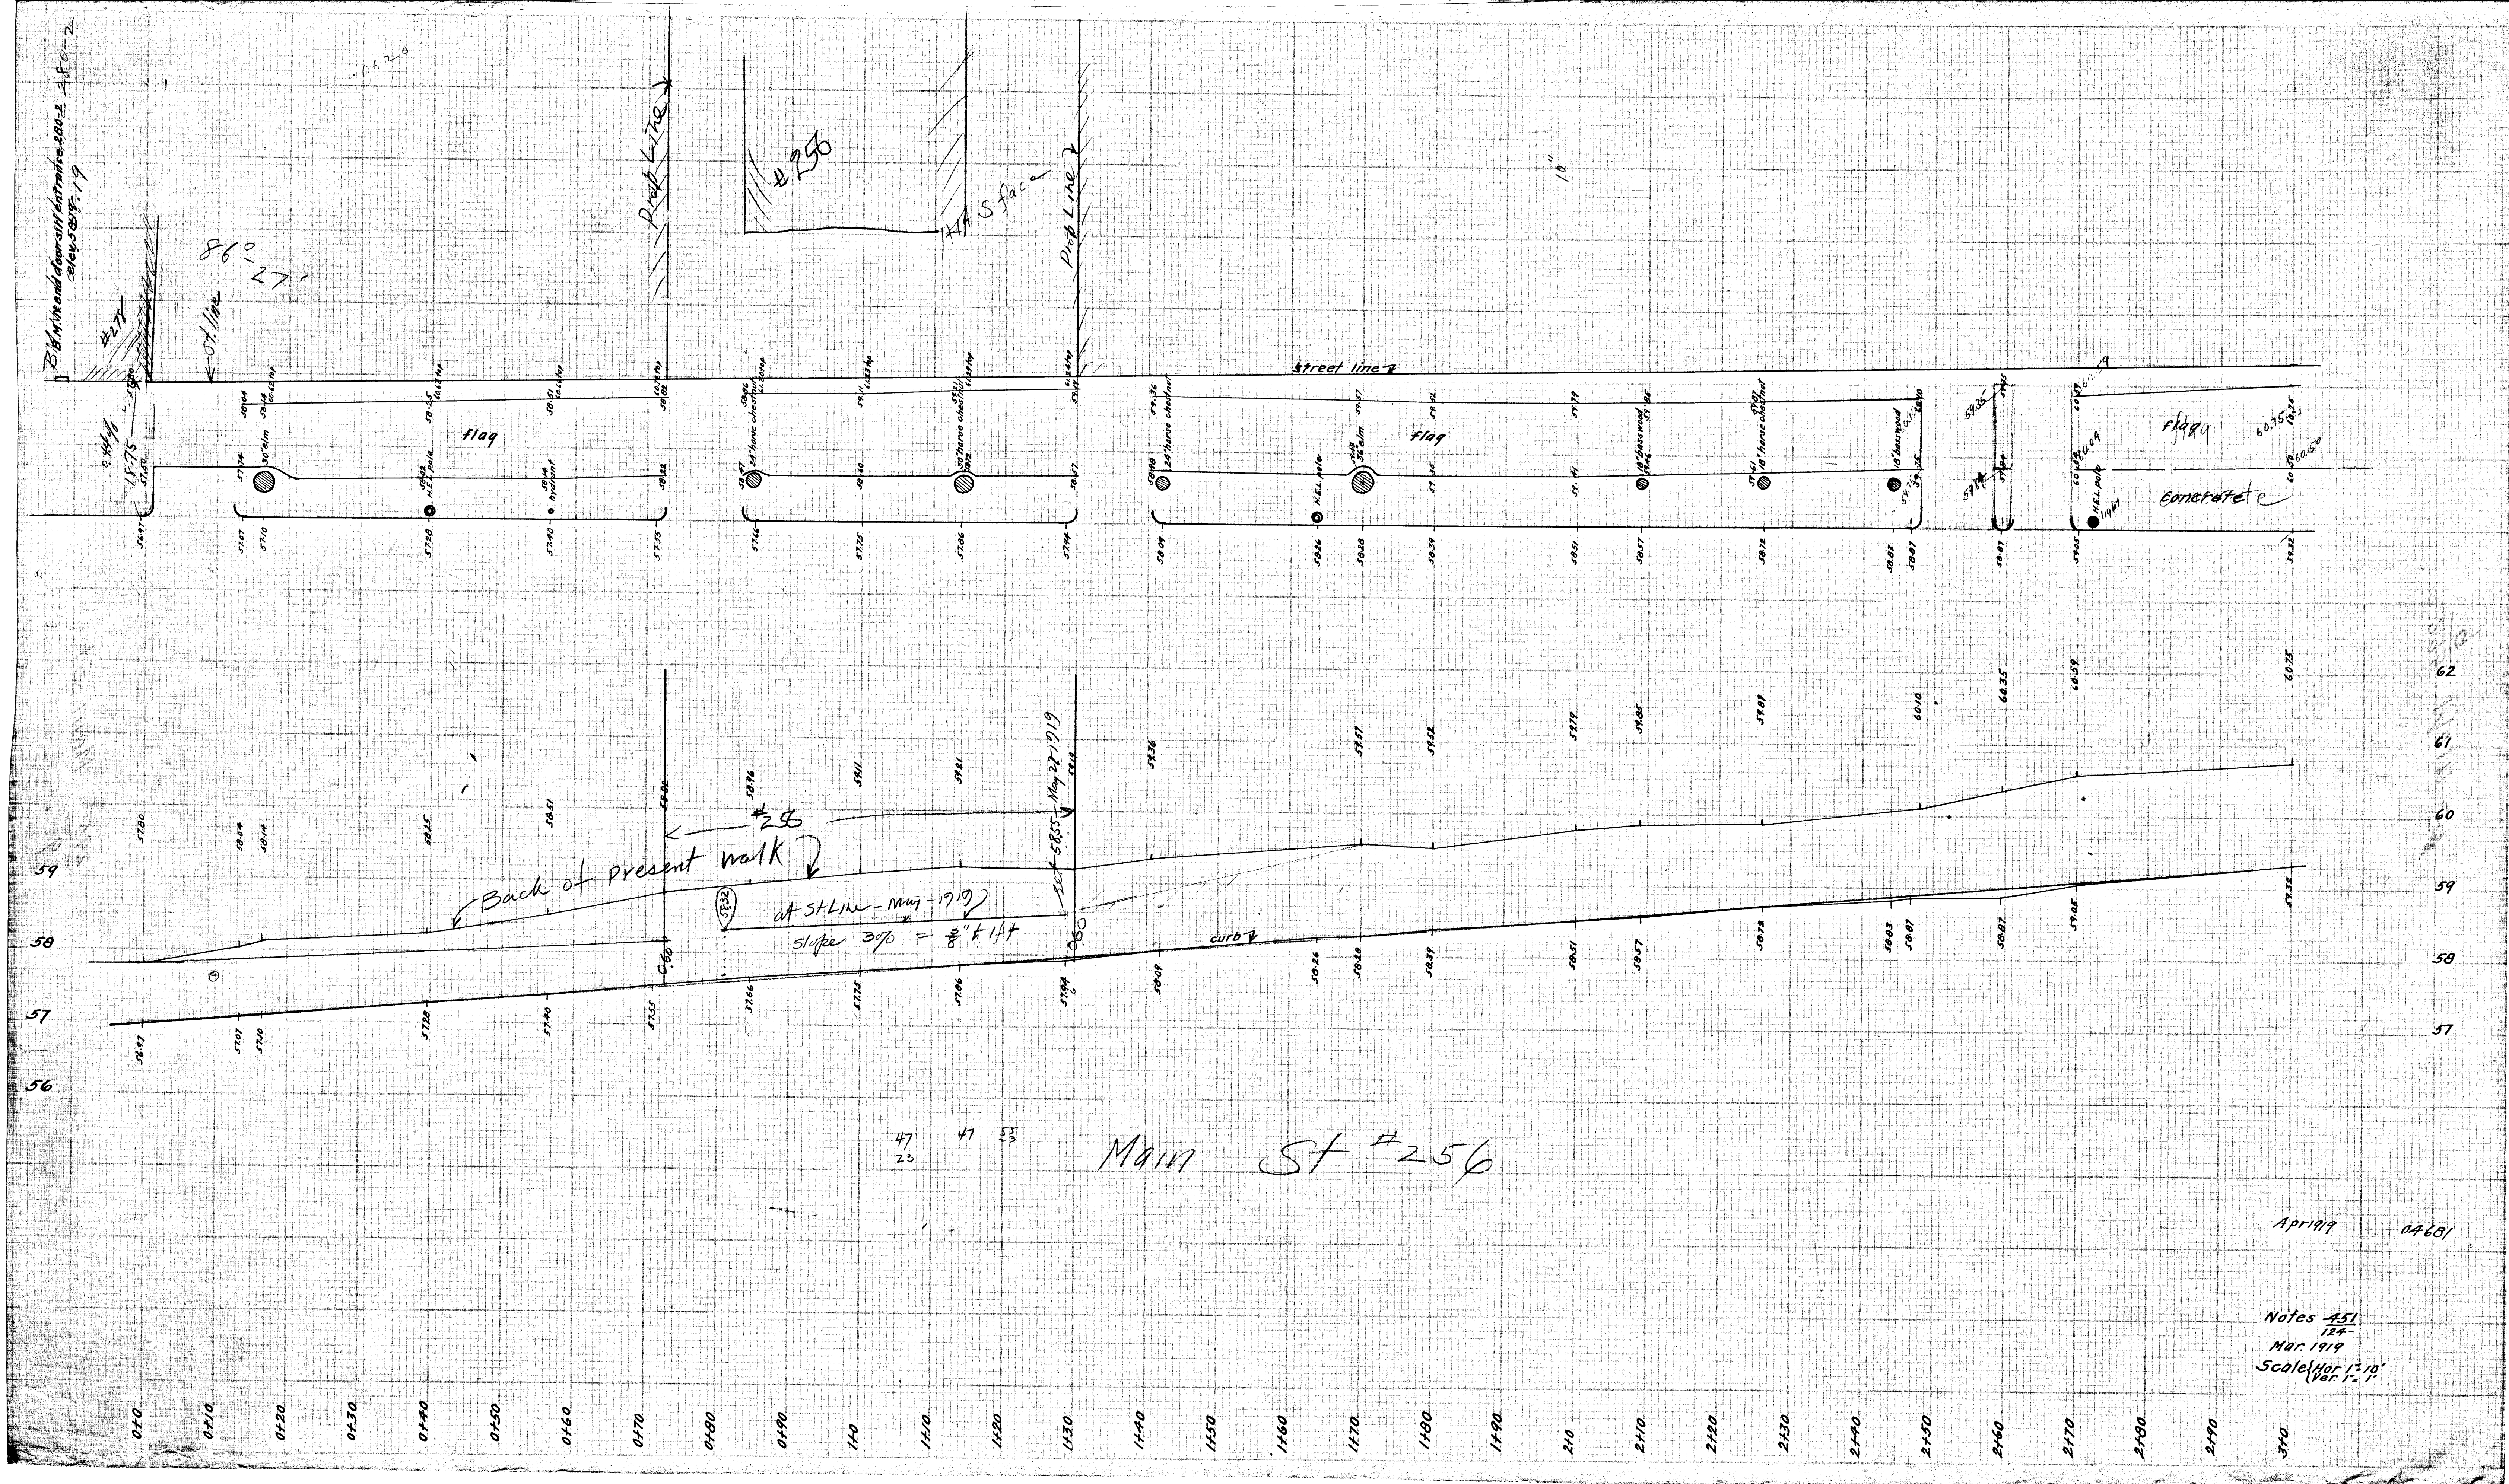

Apr 19/19 04681

Notes 451
124-
Mar. 1919
Scale { Hor 1" = 10'
Ver. 1" = 1'