


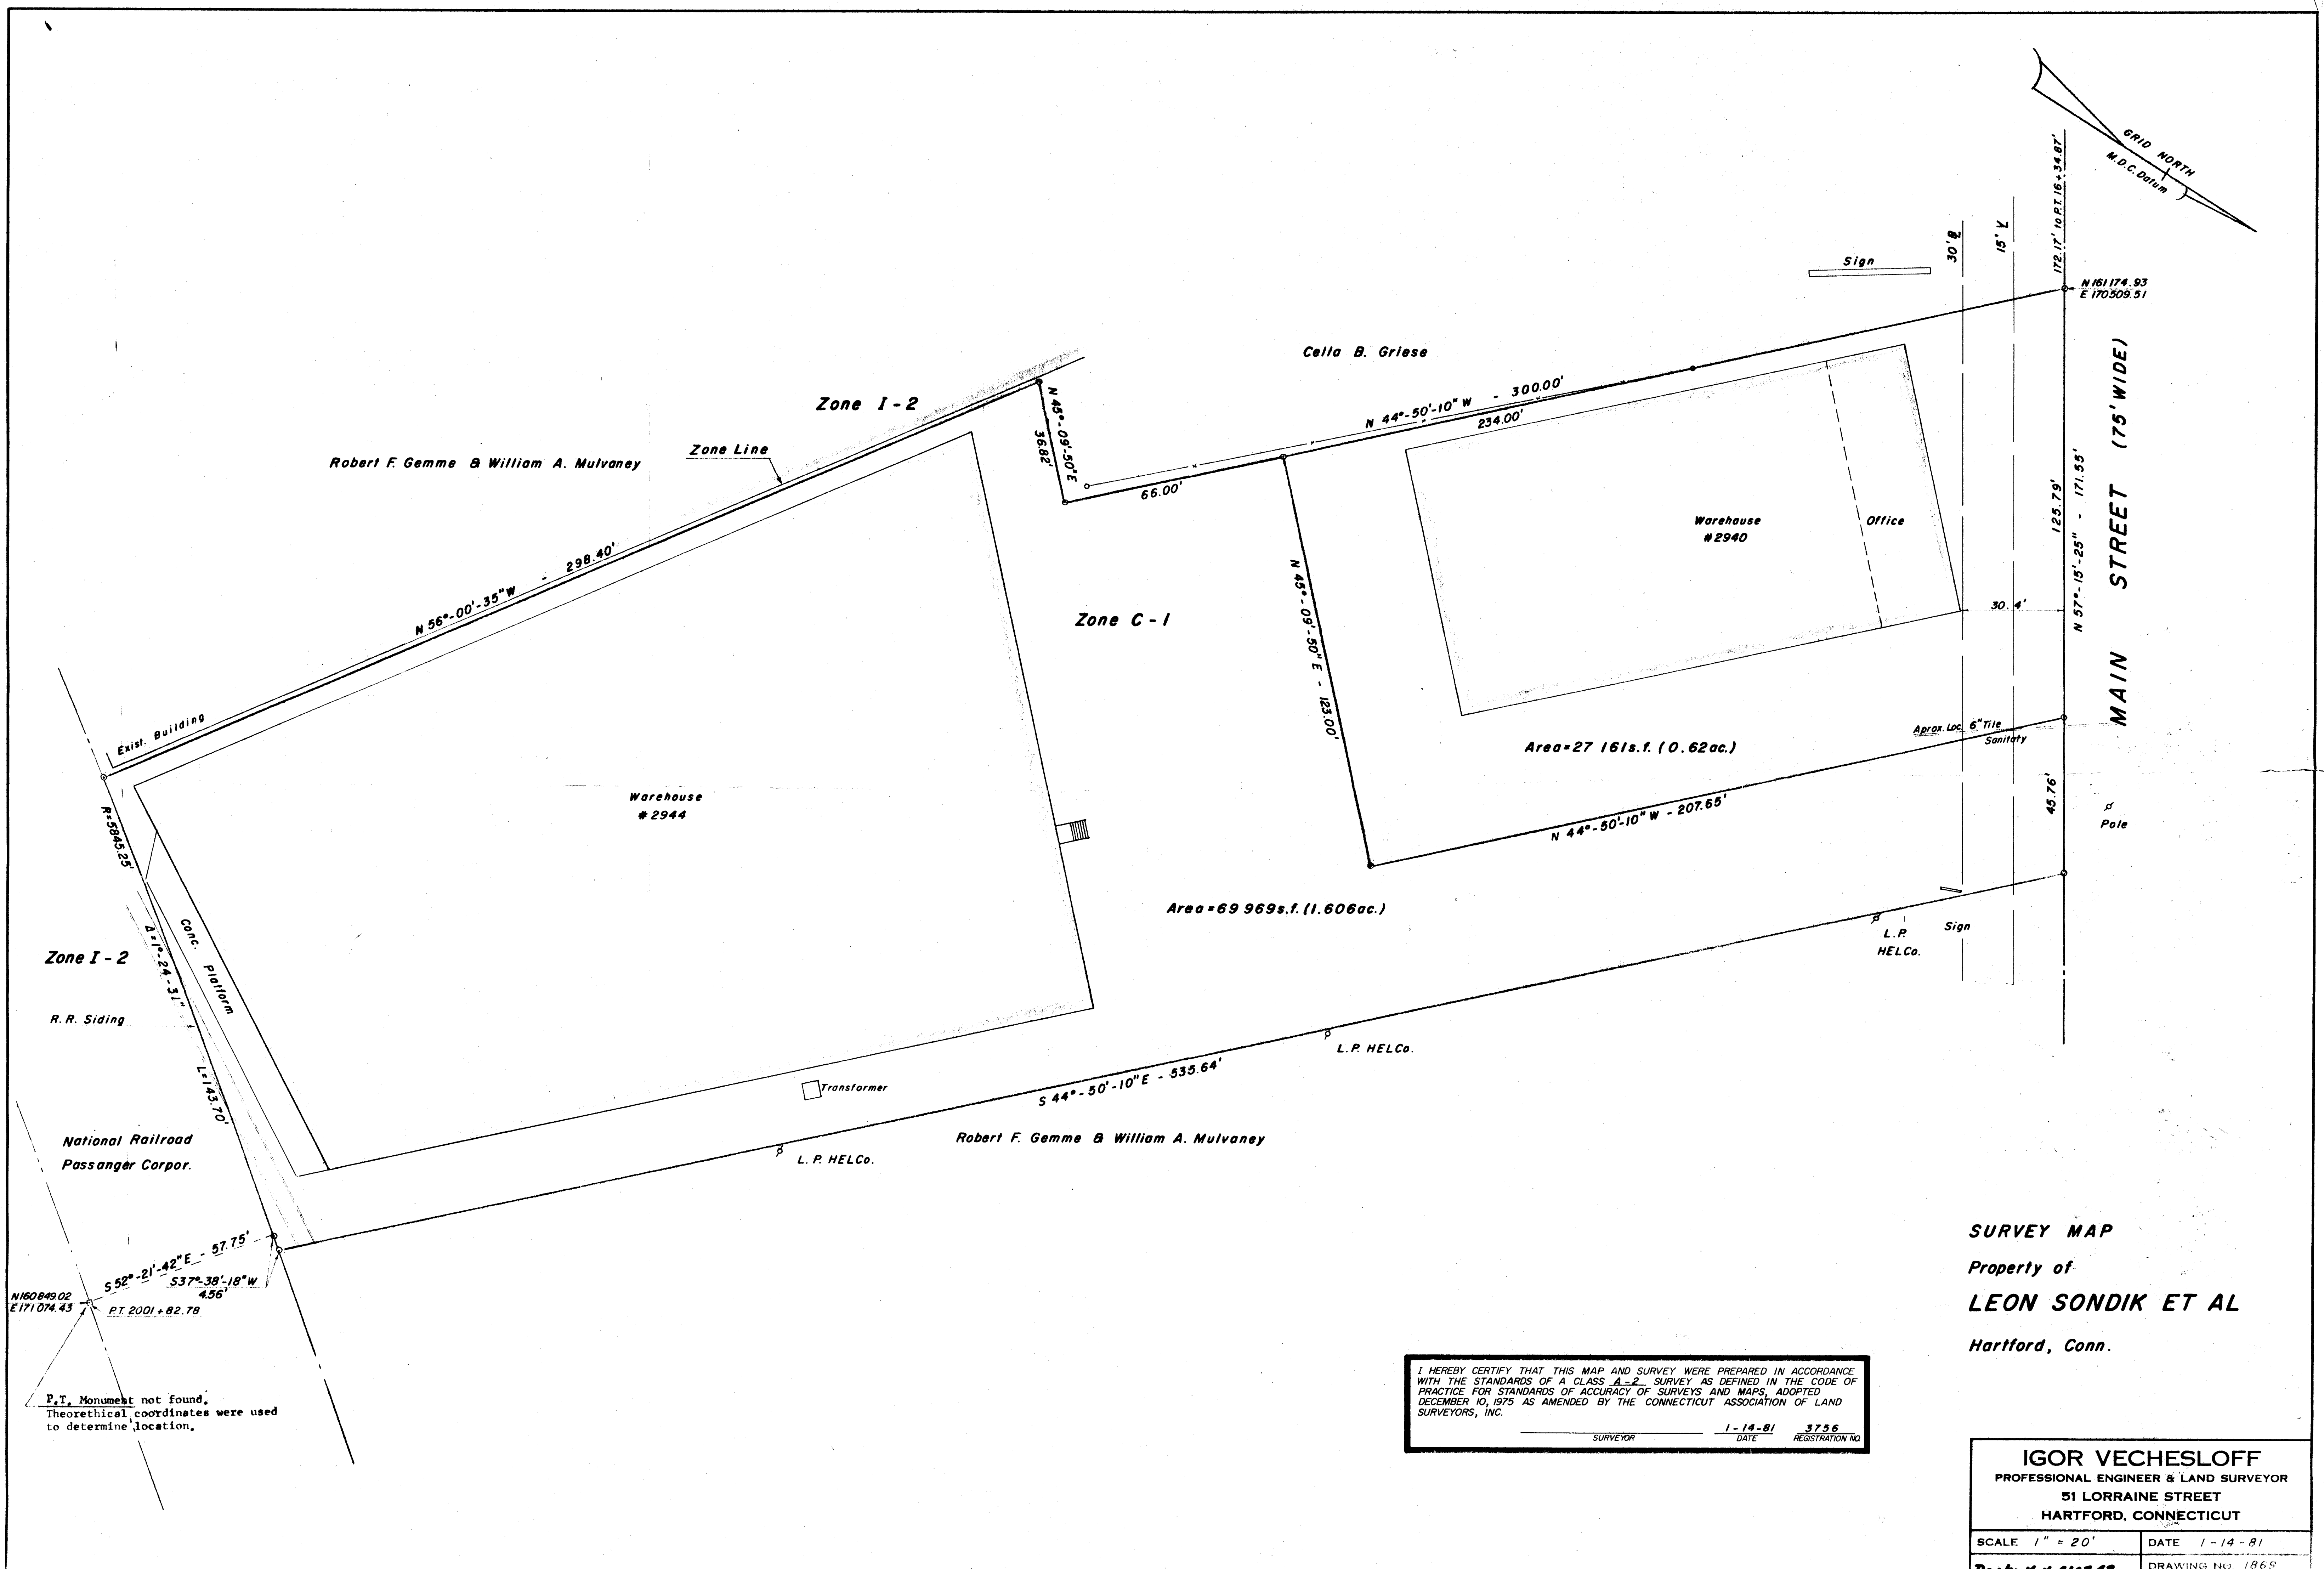

SURVEY MAP
 Property of
LEON SONDIK ET AL
 Hartford, Conn.

I HEREBY CERTIFY THAT THIS MAP AND SURVEY WERE PREPARED IN ACCORDANCE WITH THE STANDARDS OF A CLASS **A-2** SURVEY AS DEFINED IN THE CODE OF PRACTICE FOR STANDARDS OF ACCURACY OF SURVEYS AND MAPS, ADOPTED DECEMBER 10, 1975 AS AMENDED BY THE CONNECTICUT ASSOCIATION OF LAND SURVEYORS, INC.

SURVEYOR IGOR VECHESLOFF DATE 1-14-81 REGISTRATION NO. 3756

IGOR VECHESLOFF
 PROFESSIONAL ENGINEER & LAND SURVEYOR
 51 LORRAINE STREET
 HARTFORD, CONNECTICUT

SCALE 1" = 20' DATE 1-14-81
 Daybook # 010743 DRAWING NO. 1868