


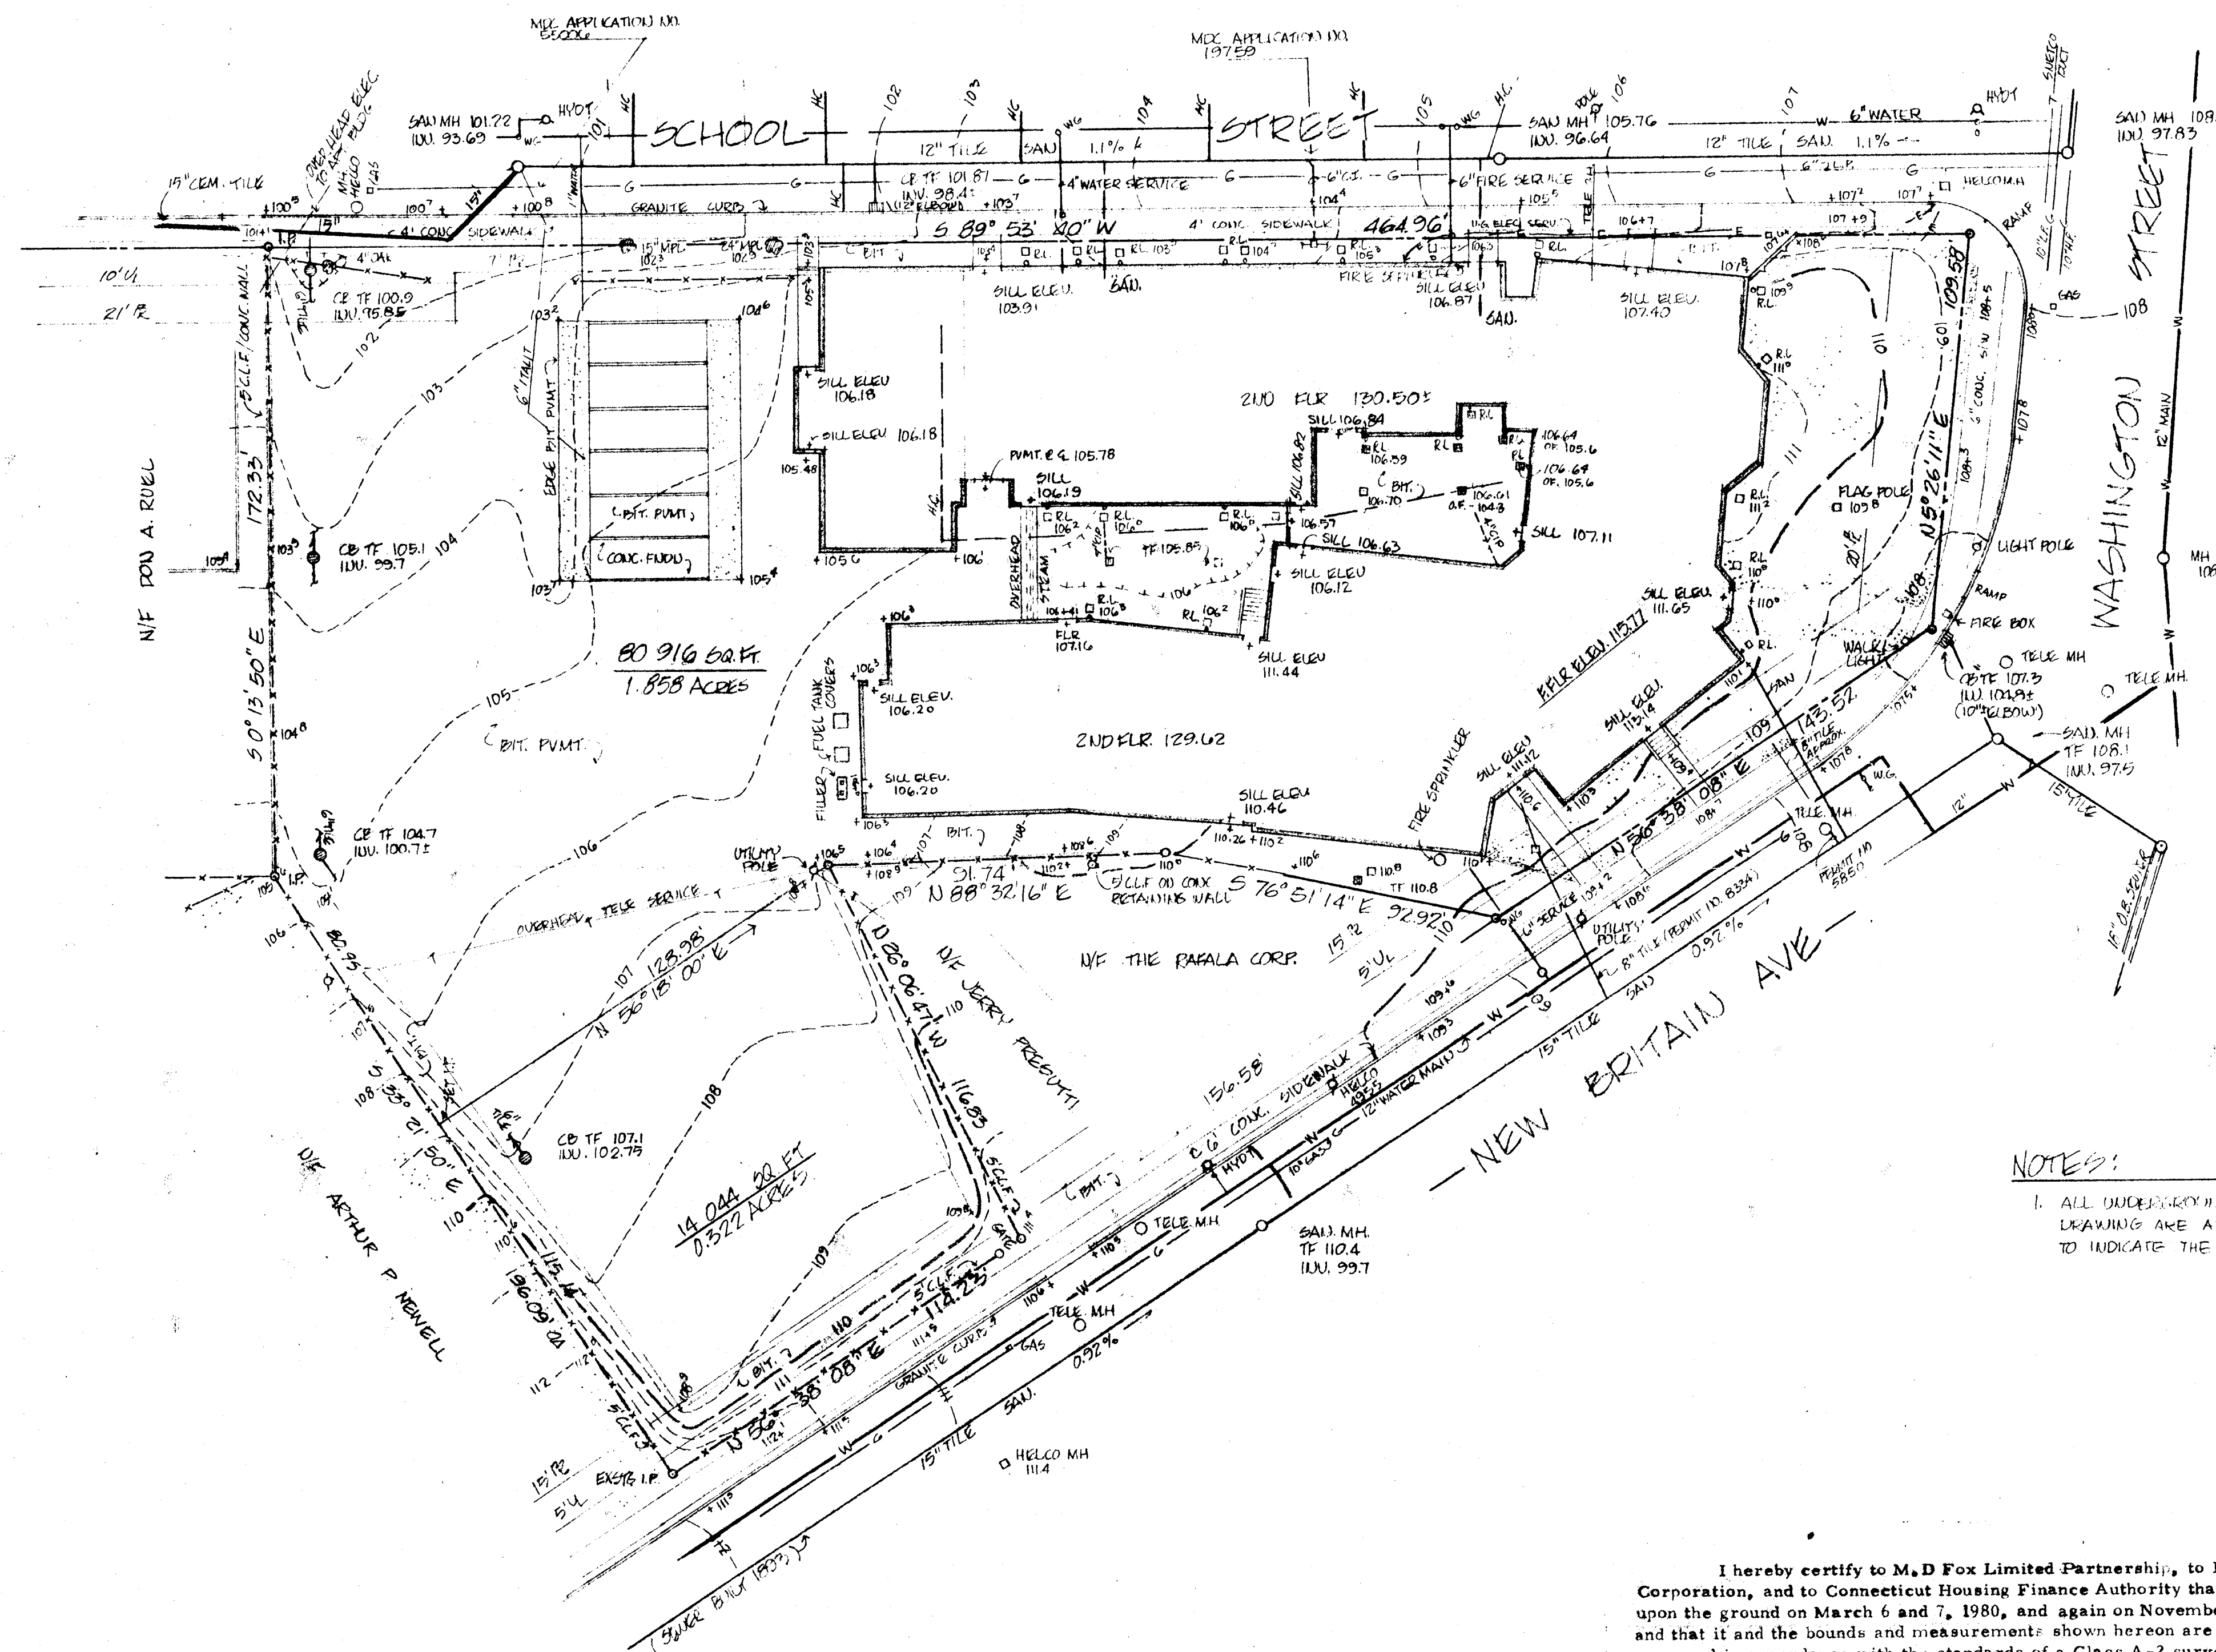

NOTES:

1. ALL UNDERGROUND UTILITY LOCATIONS SHOWN ON THIS DRAWING ARE APPROXIMATE AND NO WAY WARRANTED TO INDICATE THE TRUE CONDITIONS.

I hereby certify to M.D. Fox Limited Partnership, to Lawyers Title Insurance Corporation, and to Connecticut Housing Finance Authority that this survey was made upon the ground on March 6 and 7, 1980, and again on November 25, 1980, and that it and the bounds and measurements shown hereon are substantially correct and were prepared in accordance with the standards of a Class A-2 survey as defined in the code of practice for standards of accuracy of surveys and maps, adopted December 10, 1975, as amended by the Connecticut Association of Land Surveyors, Inc., and that unless otherwise shown, title lines and lines of actual possession are the same; that the building and improvements are located as shown and do not encroach over street, title or building lines; that there are no violations of building or zoning regulations as pertains to location of said building, except as shown; and that there are no apparent easements, encroachments or uses affecting this property that can be determined from a careful physical inspection thereof other than those shown or depicted hereon.

John J. Lawrence, Jr., P. E., L. S. OCT 20, 1980

LEGEND

CB	CATCH BASIN
MH	MANHOLE
RL	RAIN LEADER
HYD	HYDRAUNT
WG	WATERGATE
W	WATER
G	GAS
E	ELEC.
T	TELE
OF	OVER FLOW (G.R.O.)

NO.	REVISION	DATE

PROPERTY SURVEY TOPOGRAPHY SURVEY

MICHAEL D. FOX SCHOOL ELDERLY HOUSING PROJECT

461 WASHINGTON STREET
HARTFORD, CONN.

MARCH 1980
NOVEMBER 1980

SCALE: 1" = 30'

7	REVISION	NOVEMBER 25, 1980

NO.	REVISION	DATE

JOHN J. LAWRENCE & ASSOC., INC.
ENGINEERS
FARMINGTON, CONNECTICUT

DAYBOOK NO. 010742