
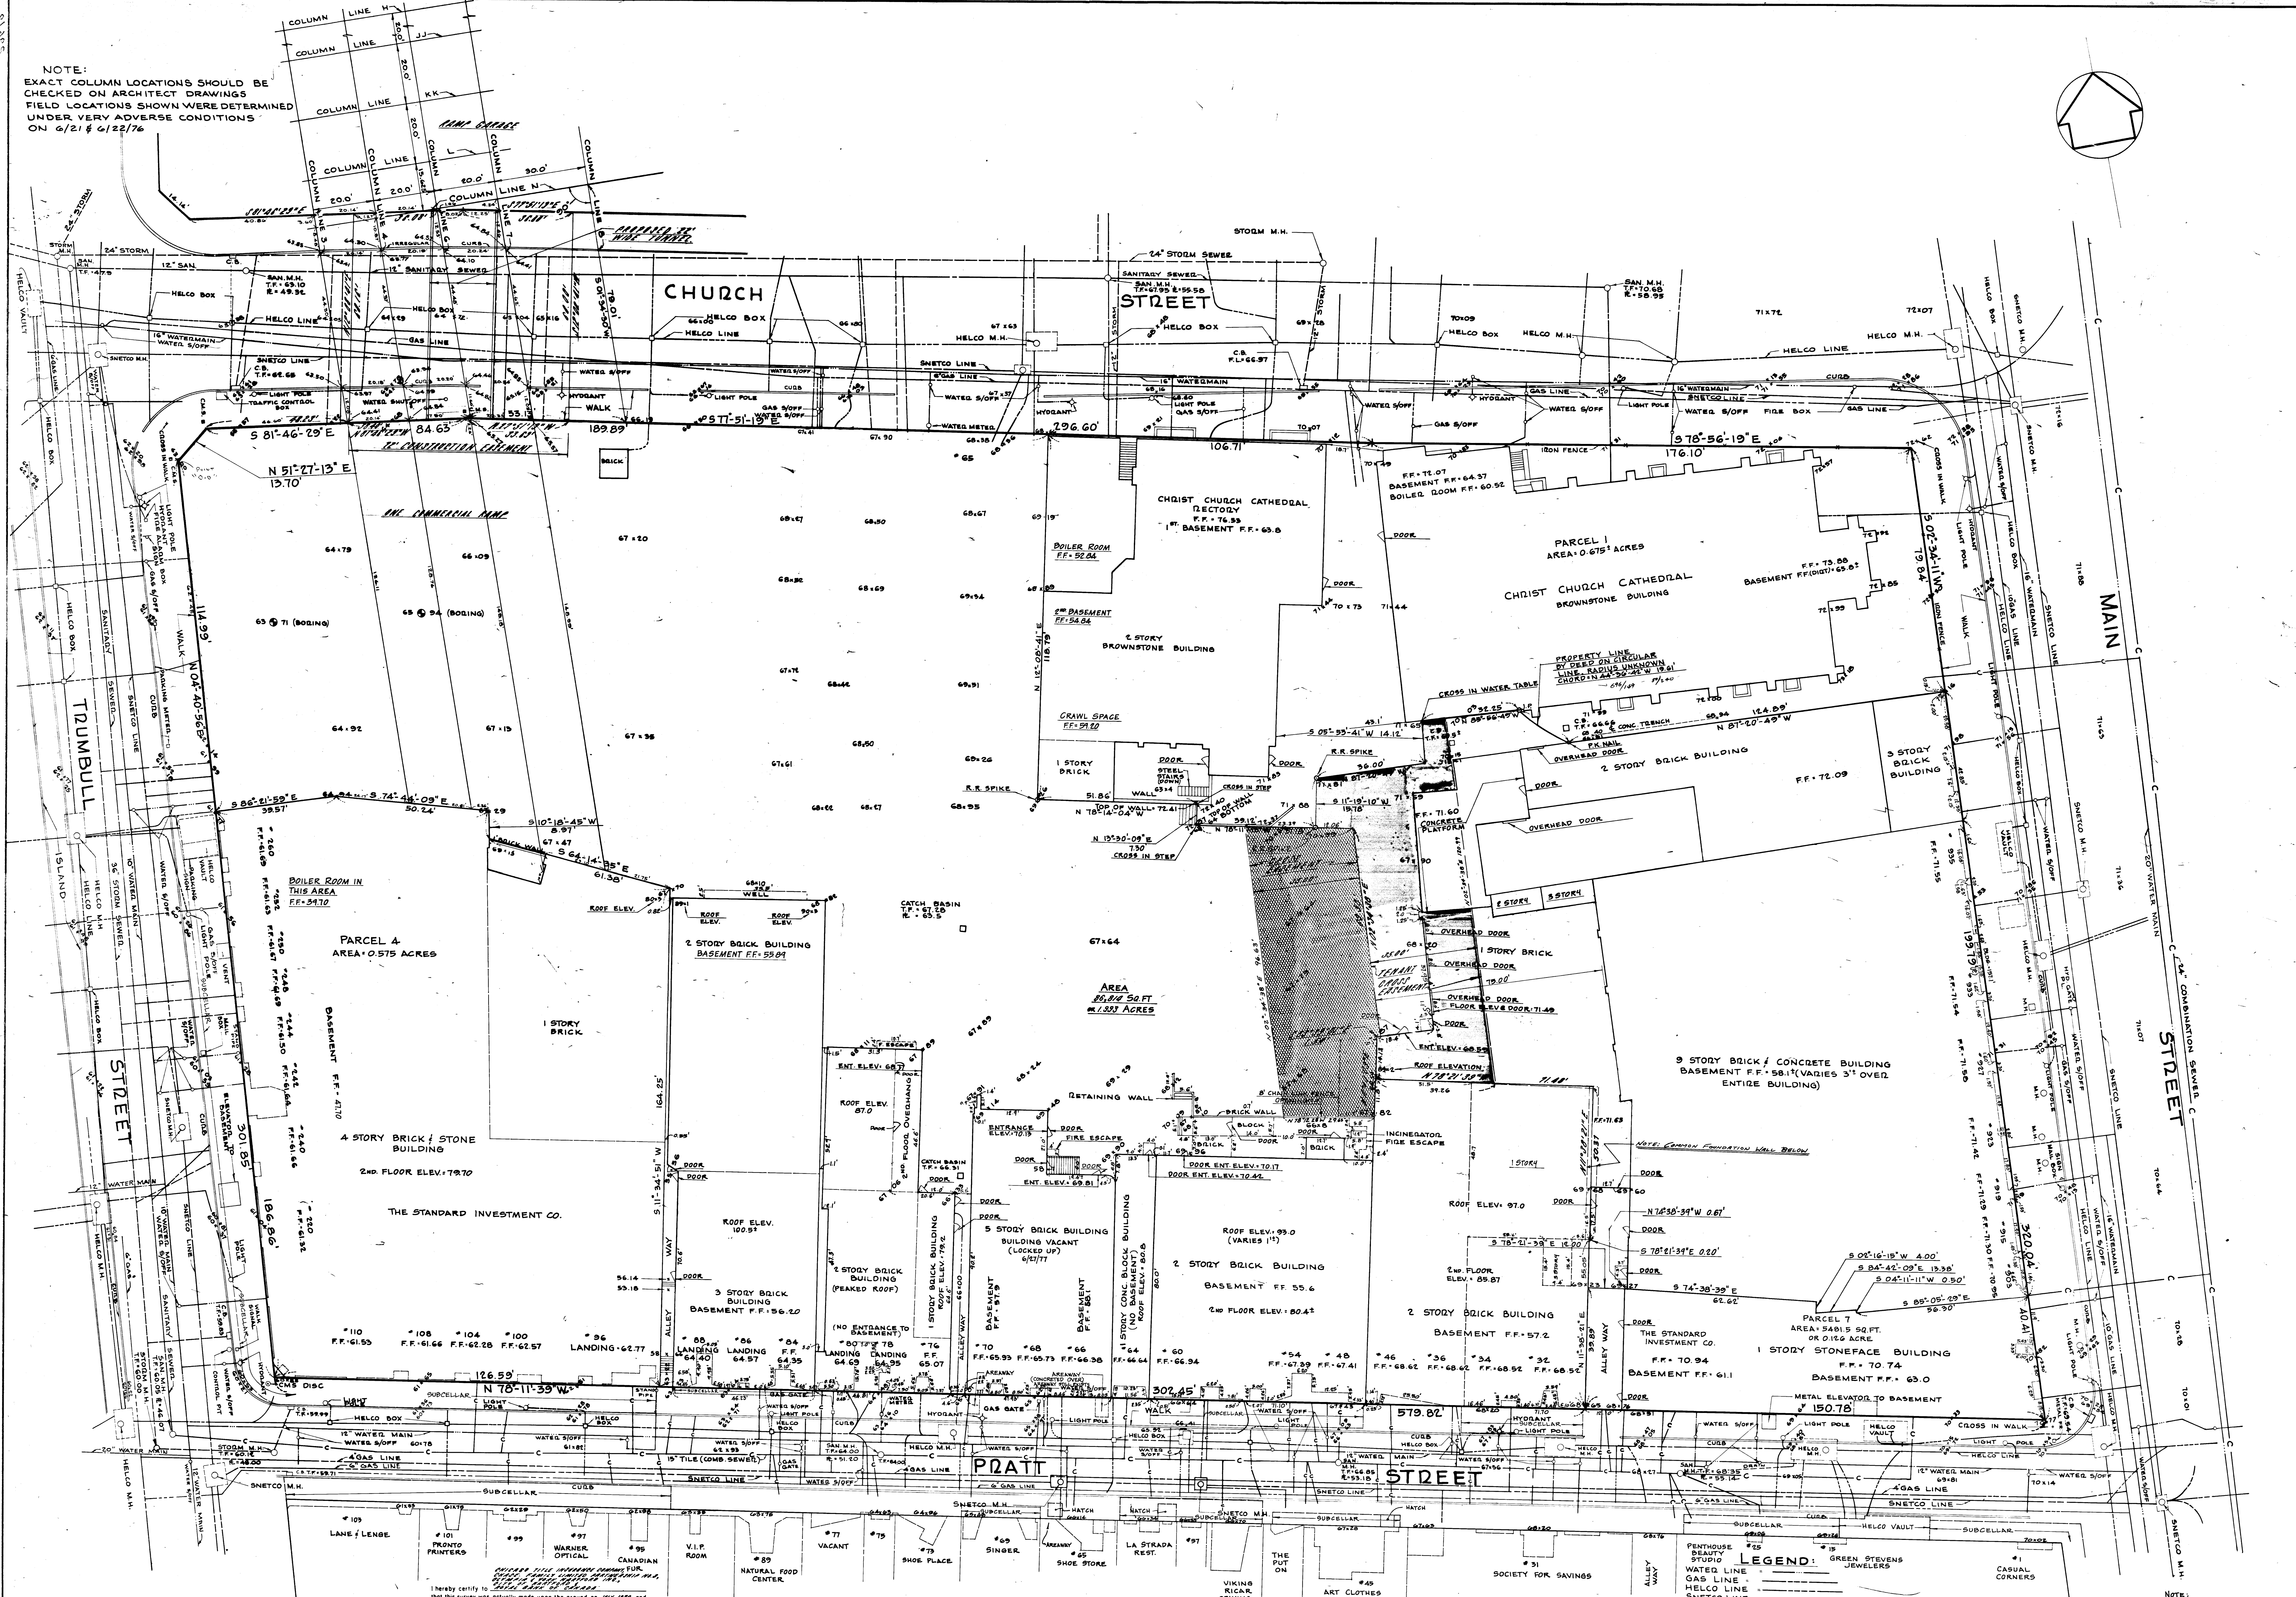


NOTE:
EXACT COLUMN LOCATIONS SHOULD BE
CHECKED ON ARCHITECT DRAWINGS
FIELD LOCATIONS SHOWN WERE DETERMINED
UNDER VERY ADVERSE CONDITIONS
ON 6/21 & 6/22/76

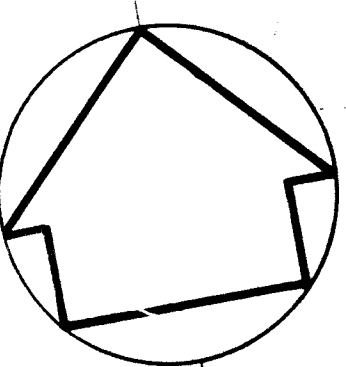

I hereby certify that this survey was actually made upon the ground on 6/22/76, and that it and the bounds and measurements shown hereon are correct within the standards of a Class C.E. survey as defined in the Code of Practice for Standards of Accuracy of Surveys and Maps, adopted December 31, 1965, and as amended by the Connecticut Association of Land Surveyors, Inc. and that, unless otherwise shown, dead lines and lines of actual possession are the same, buildings are located as shown and do not encroach over or upon street, road or building lines, there are no violations of zoning regulations with reference to the location of buildings, and there are no encroachments or encroachments affecting this property apparent from a careful inspection of the same, other than those noted and depicted hereon.

CLOSE, JENSEN & MILLER
Civil Engineers & Surveyors
59 John H. Miller

ADDITIONS DEC 29th 1981
ADDITIONS JAN 26th 1981
ADDITIONS DEC 4th 1980
ADDITIONS OCT 22nd 1980
ADDITIONS SEPT 17th 1977
ADDITIONS SEPT 17th 1977
ADDITIONS AUG 12th 1977
ADDITIONS JULY 22, 1976

Drawn R.B.B.
Checked J.H.M.
Date July 1976
Scale 1" = 16'

CLOSE, JENSEN & MILLER
CONSULTING ENGINEERS, LAND PLANNERS & SURVEYORS
449 SILAS DEANE HIGHWAY
WETHERSFIELD, CONNECTICUT 06095



PROJECT BY
CITY OF HARTFORD
CHURCH STREET, PRATT STREET, CHURCH STREET & TRUMBULL STREET
HARTFORD, CONNECTICUT
#1985

THE LOCATION OF THE UNDERGROUND UTILITIES SHOWN ON THIS PLAN HAVE BEEN OBTAINED FROM THE BEST AVAILABLE SOURCES. THE ACTUAL LOCATION OF THESE UTILITIES SHOULD BE VERIFIED IN THE FIELD BY THE CONTRACTOR.

NOTE:
REFERENCE IS MADE TO A MAP ENTITLED "BLOCK 3 PROPERTY MAP, BOUNDED BY MAIN, PRATT, TRUMBULL, CHURCH STREETS, MAIN, AVENUE, TRUMBULL PROJECT BY CITY OF HARTFORD PUBLIC WORKS AND ENGINEERING DEPARTMENT, SCALE 1"=50', DATE JUNE 1976.