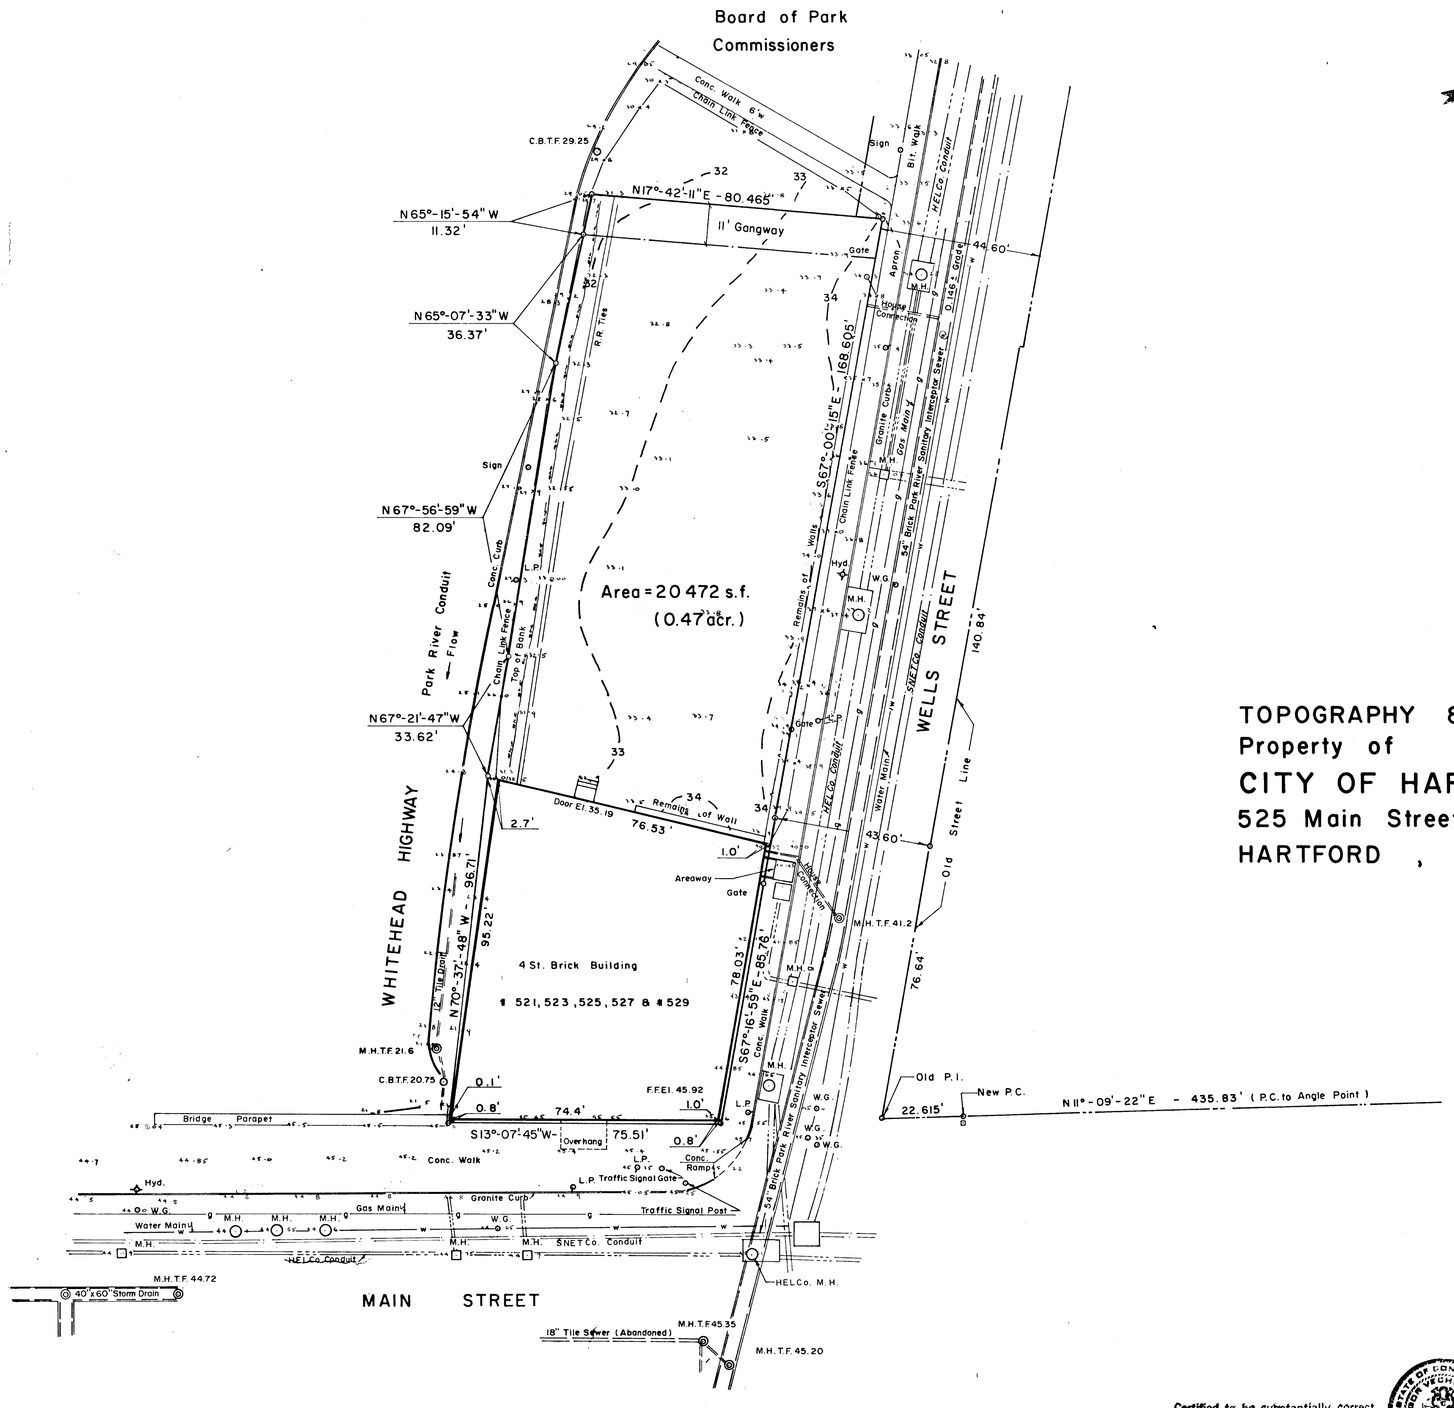

TOPOGRAPHY & PROPERTY SURVEY MAP

Property of

CITY OF HARTFORD

525 Main Street

HARTFORD, CONNECTICUT

NOTE:
Elev. Based on M.D.C. Datum B.M. # R-1

Certified to be substantially correct within the standards of Class A-1 of the Technical Council, Inc.

STATE OF CONNECTICUT — IGOR VECHESLOFF — No. 5756 — REGISTERED LAND SURVEYOR

IGOR VECHESLOFF
PROFESSIONAL ENGINEER & LAND SURVEYOR
51 LORRAINE STREET
HARTFORD, CONNECTICUT

SCALE 1" = 20'	DATE 9 - 23 - 77
	DRAWING NO. 1657

© JOSEPH MERRITT & CO. 30 7155