



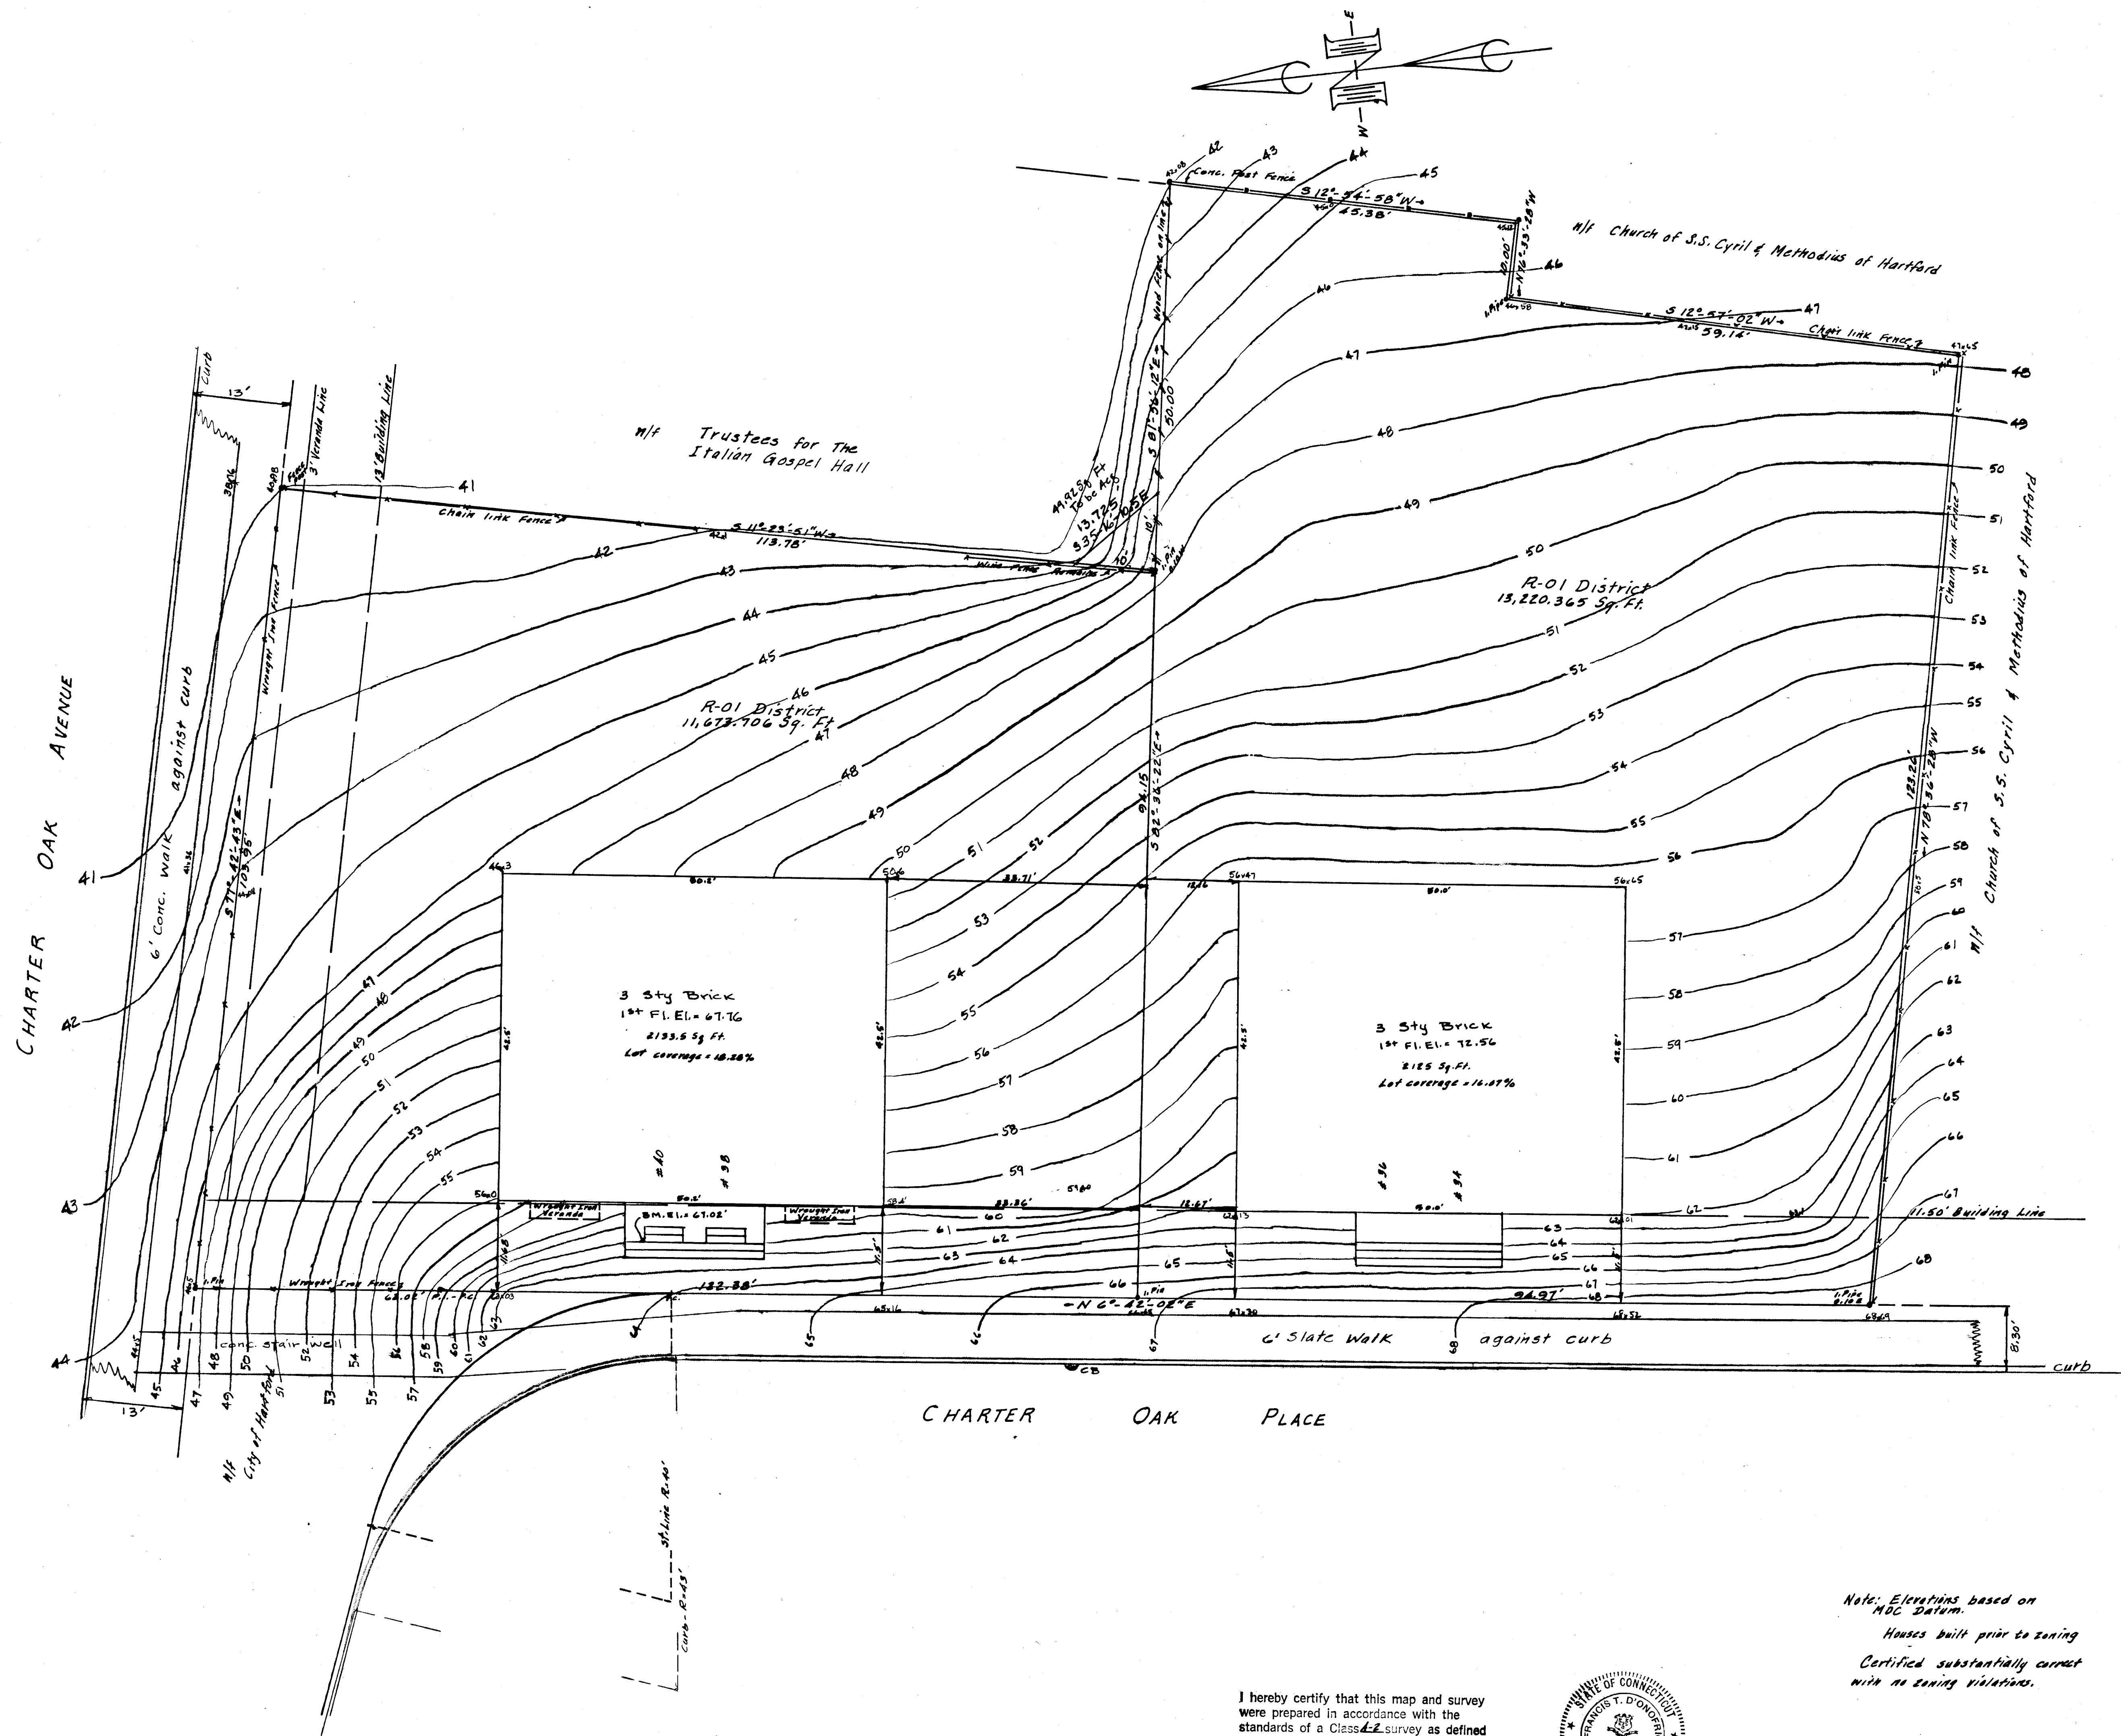

I hereby certify that this map and survey were prepared in accordance with the standards of a Class LE survey as defined in the Code of Practice for Standards of Accuracy of Surveys and Maps, adopted December 10, 1975, as amended by the Connecticut Association of Land Surveyors, Inc.
Francis J. D'Onofrio, L.S. 8493

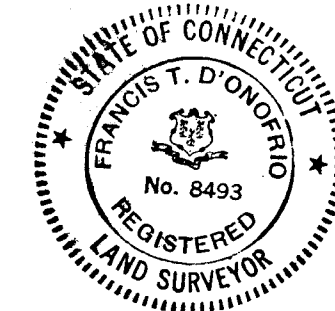

Note: Elevations based on M.C. Datum.
Houses built prior to zoning
Certified substantially correct
with no zoning violations.

CHARTER OAK - SOUTH GREEN
PROJECT
Map Showing Land
Known as
34-36 and 38-40 CHARTER OAK
PLACE
in
Hartford, Connecticut
Scale: 1"=10' Mar., 1981
Daybook # 010140