


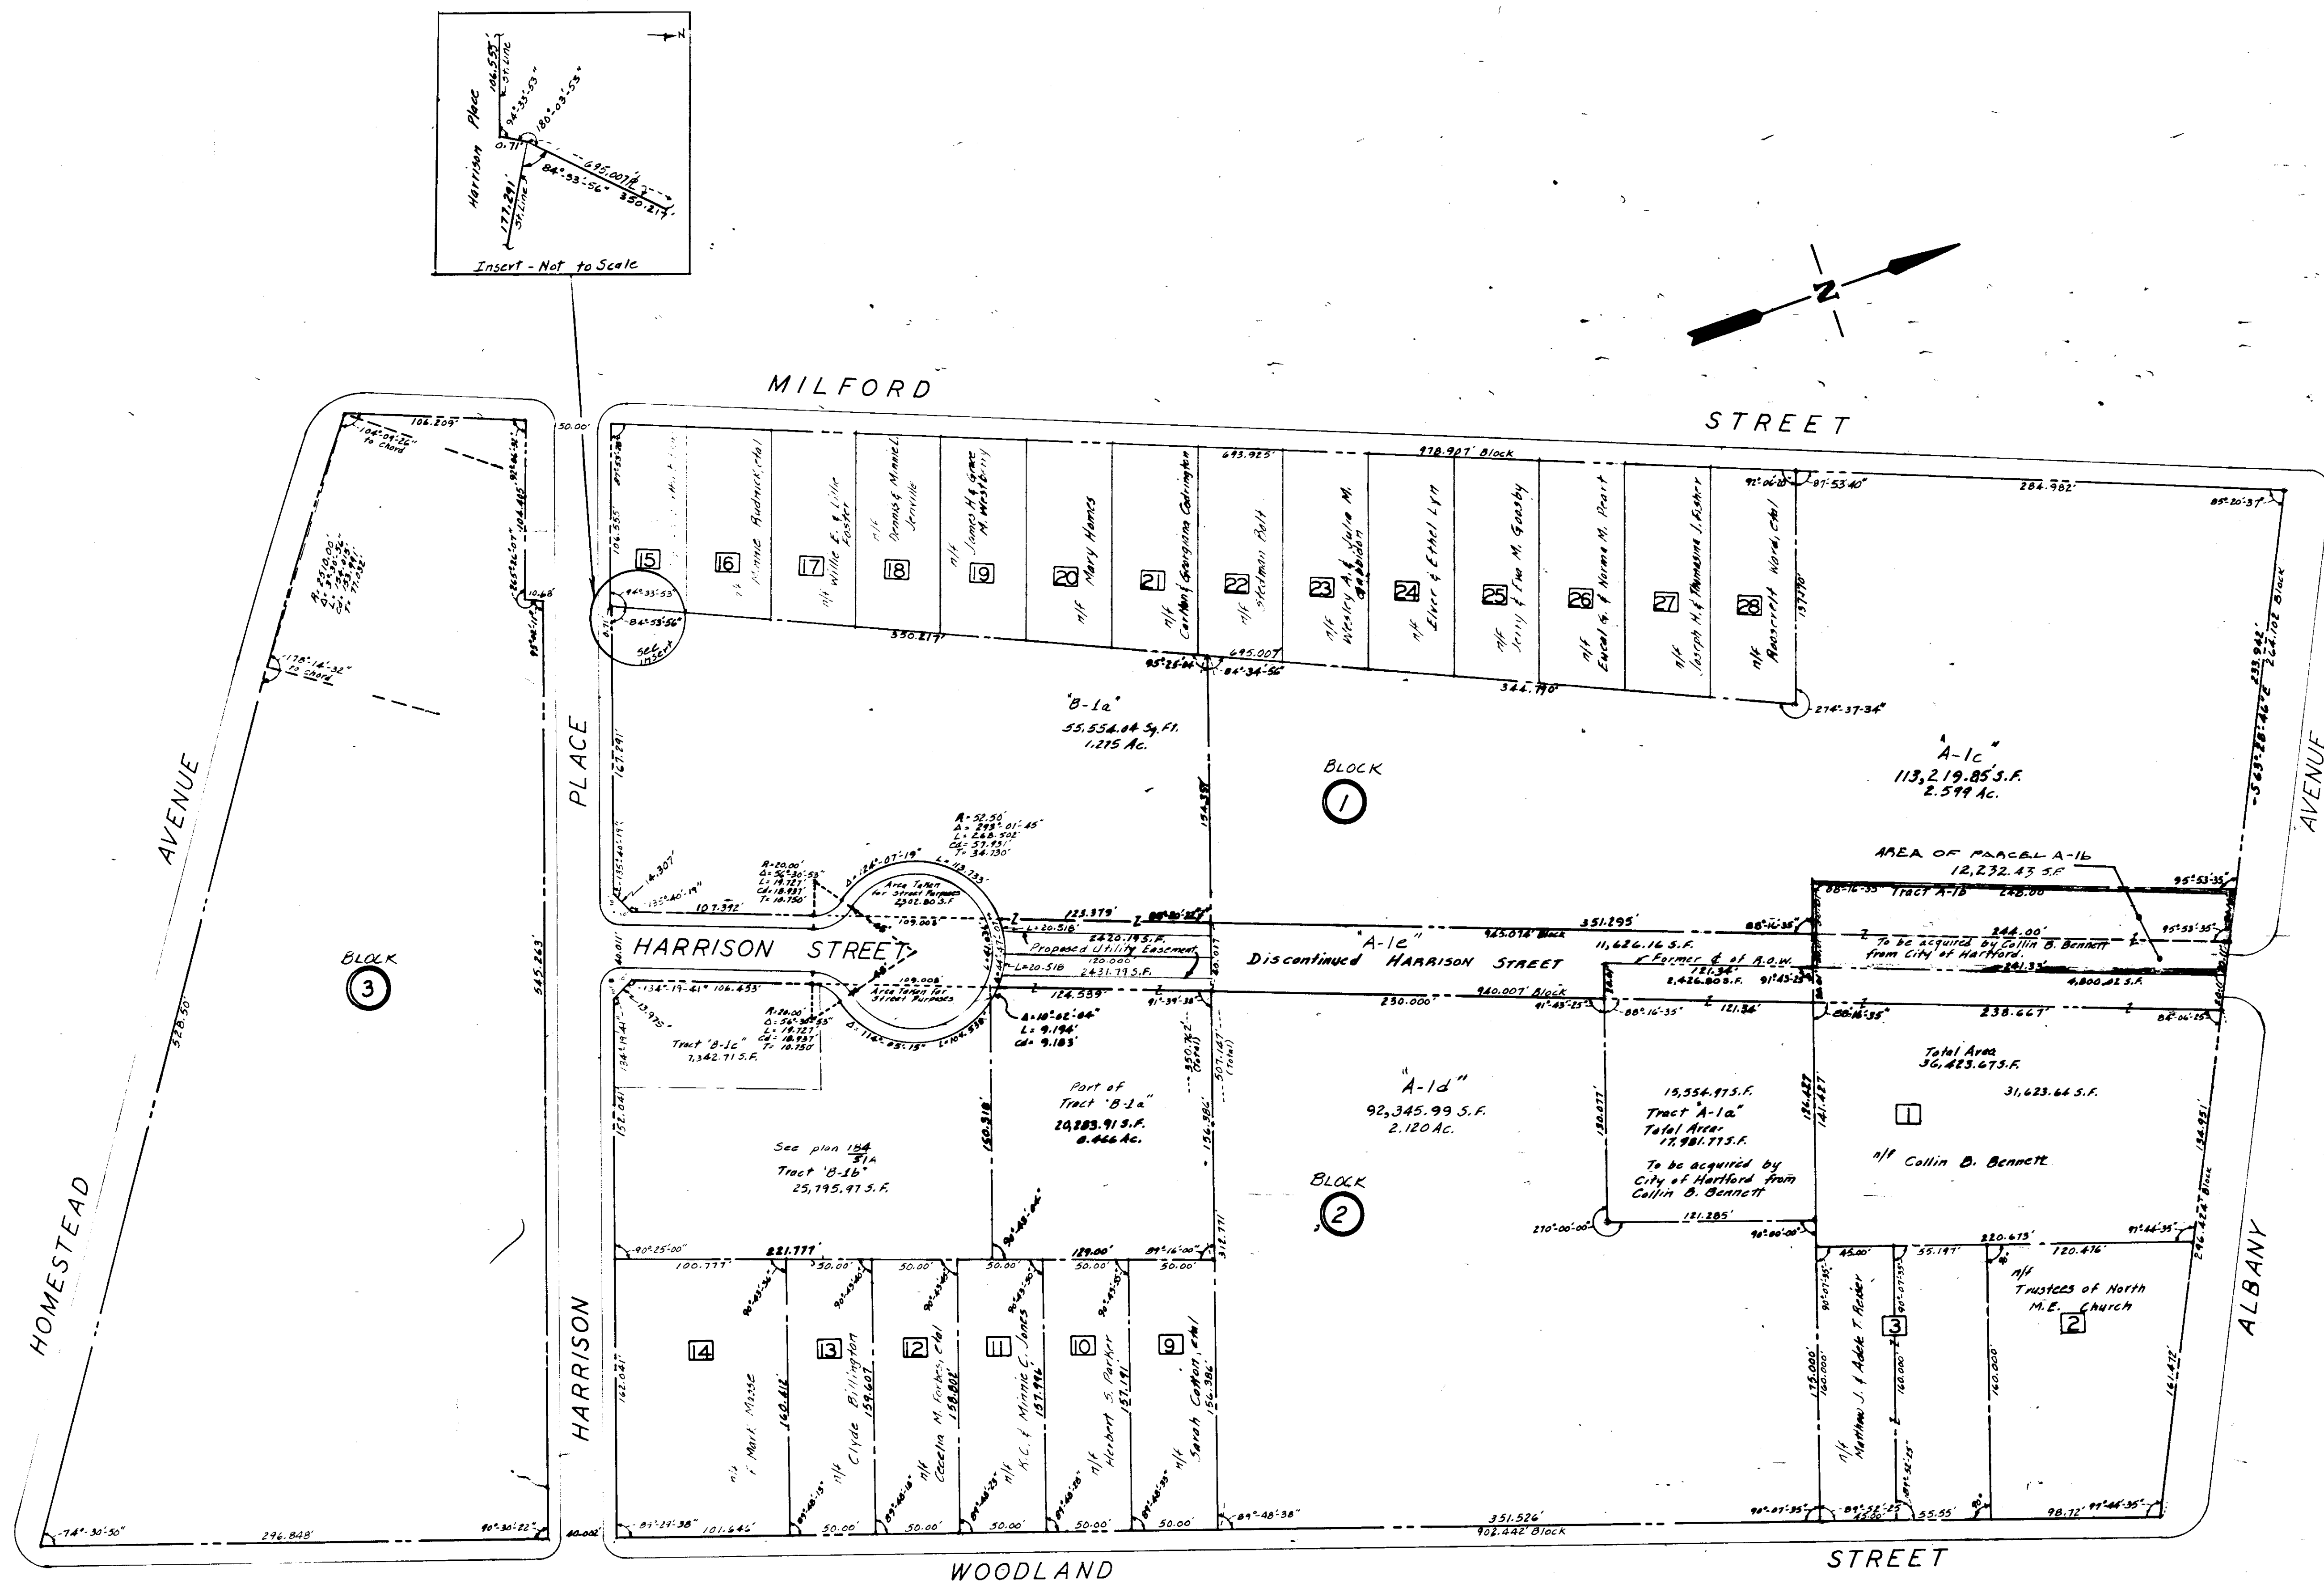

Revised 6-3-83 by F.T.D. REV. 12.12.84 ORB.

CITY OF HARTFORD, CONNECTICUT
DEPARTMENT OF PUBLIC WORKS
BUREAU OF ENGINEERING SERVICES

UPPER ALBANY PROJECT
BLOCK BOUNDED BY

WOODLAND HOMESTEAD AVENUE

MILFORD ST. ALBANY AREA

SUBJECT: [Illegible]

DN 150

BRASIN 100

1-2-51
CHECKED 772
DATE 10/13/50
FILE 10/13/50

I hereby certify that this map and survey were prepared in accordance with the standards of **Class A-2** survey as defined in the Order of the National Standards of Accuracy of Surveys and Maps adopted December 10, 1928 as amended by the Connecticut Association of Land Surveyors.

Francis J. O'Grady LWS 8493
6/3/83 Addition of Tracts B-1a, B-1b, B-1c & Beryl Curs.
Addition of Tracts A-1a & A-1b Nov, 1982 by F.J.O.