


298/20A

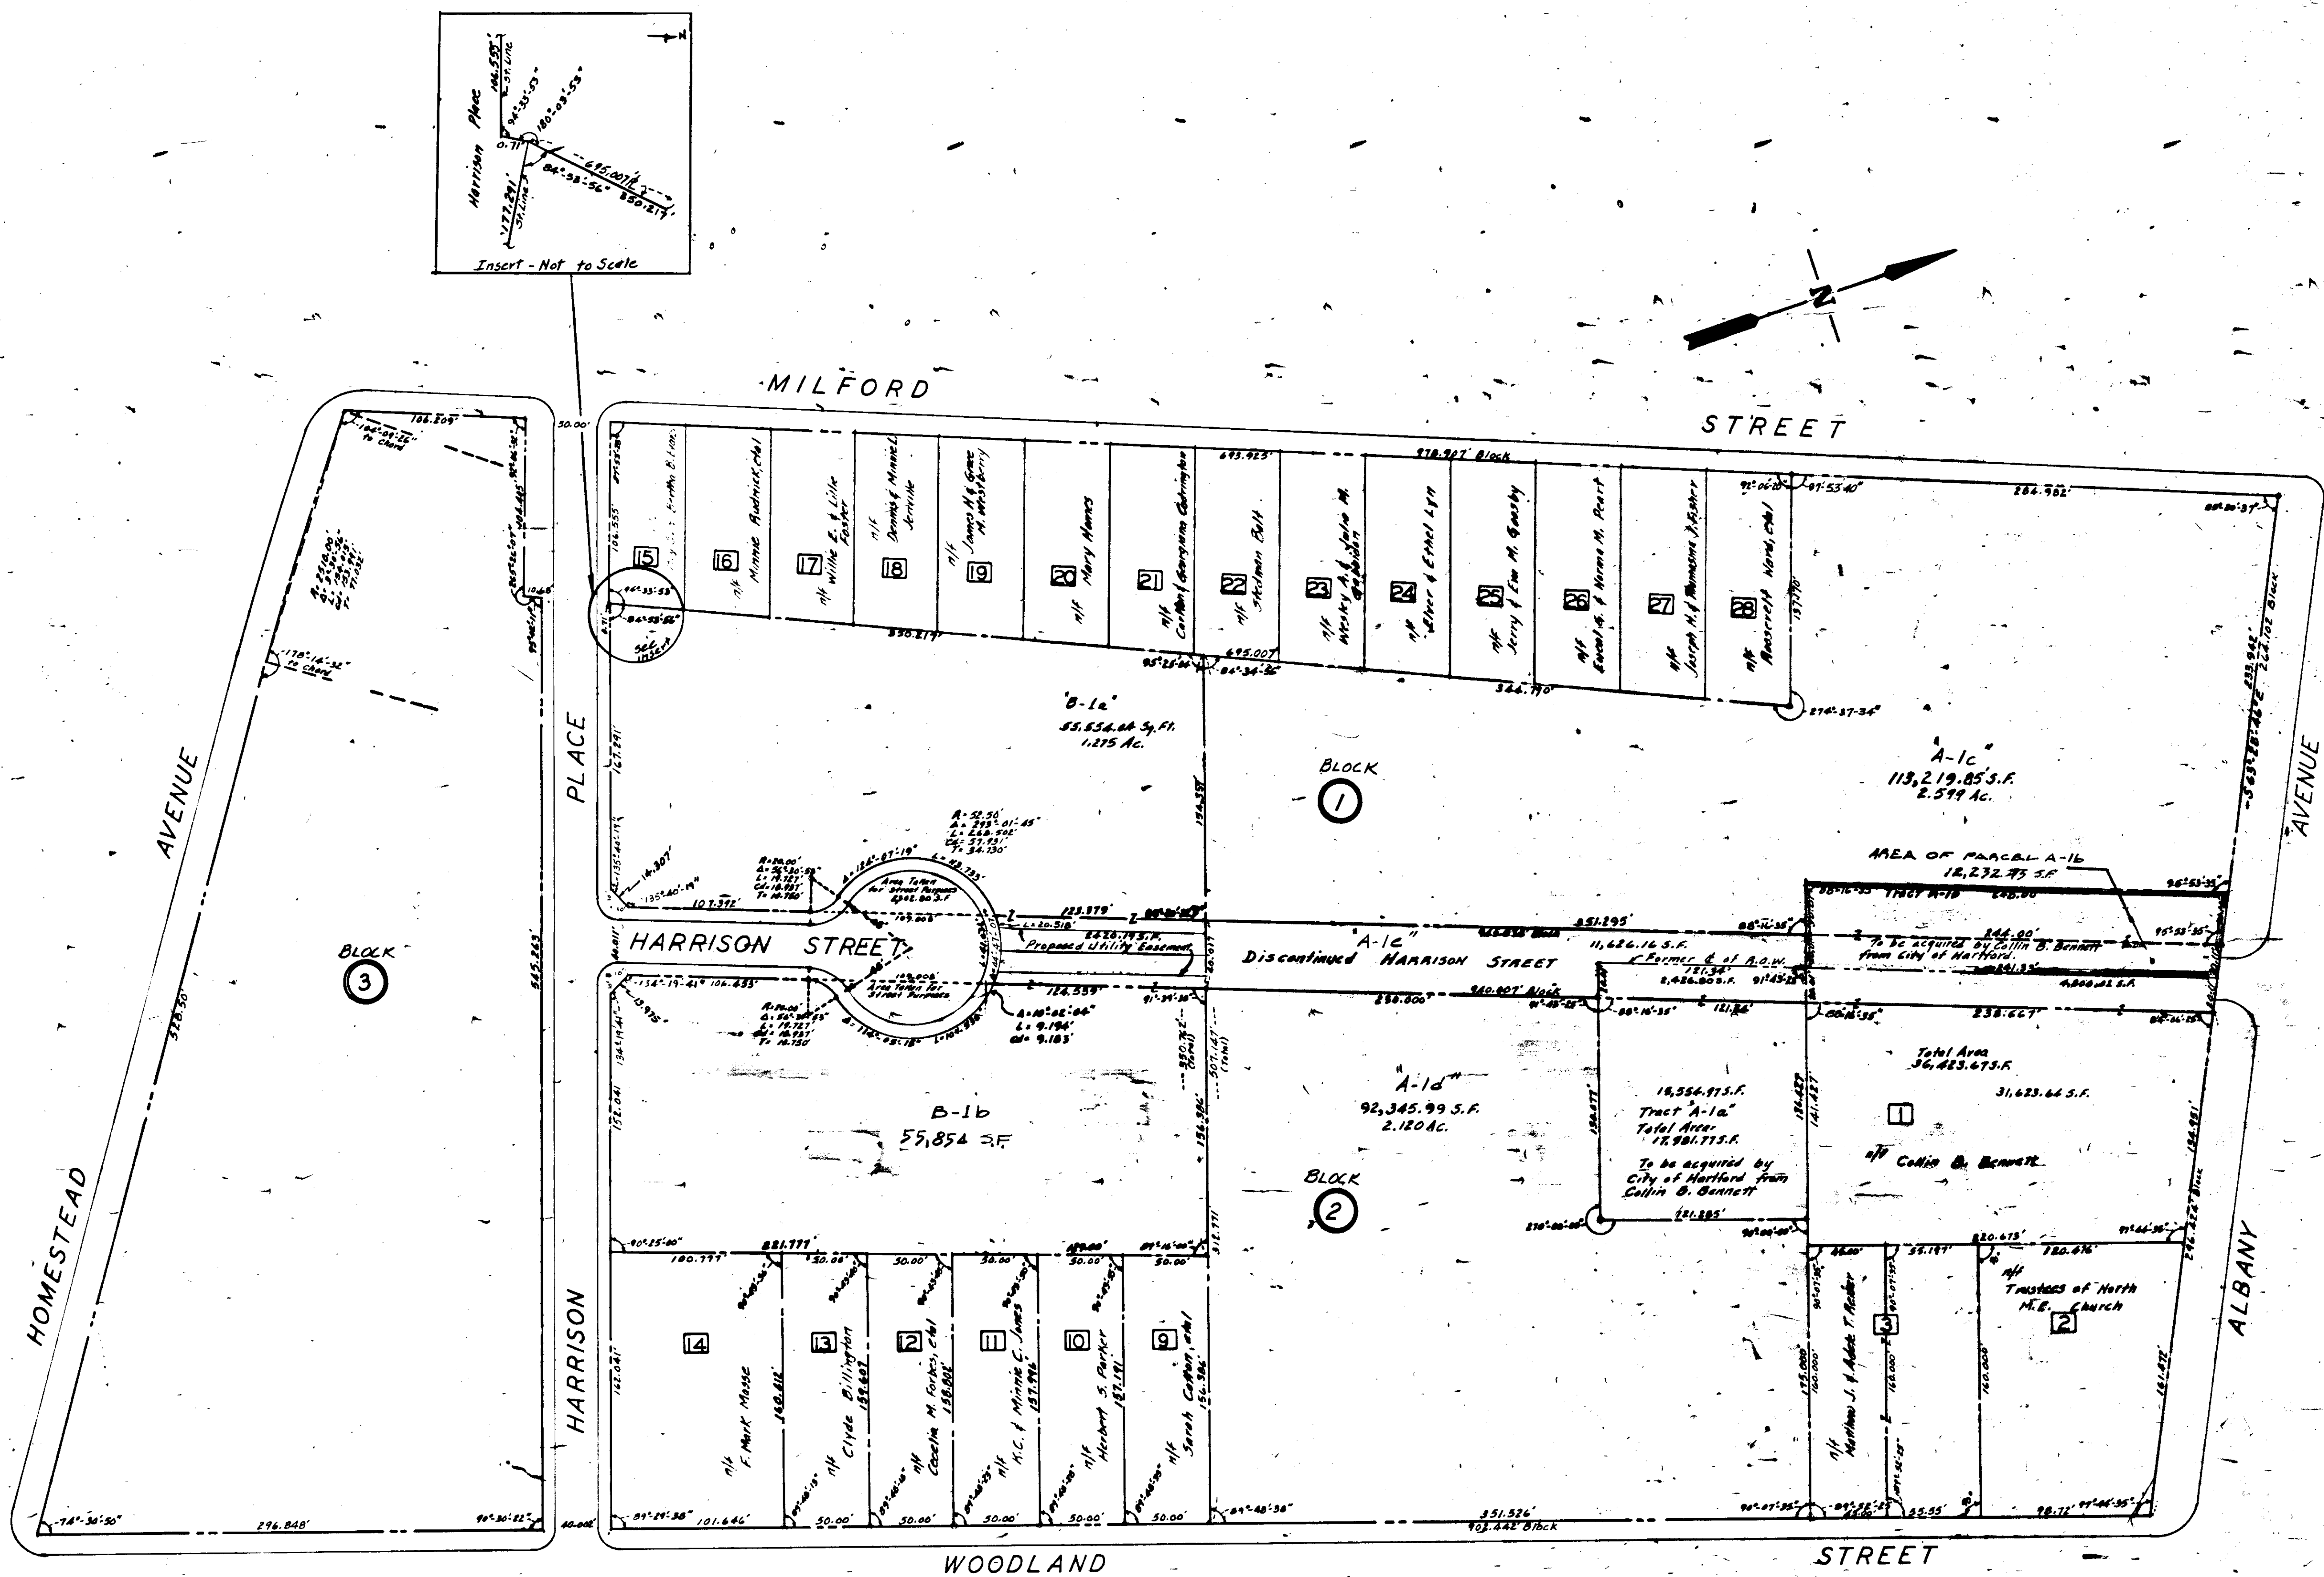

55,854.38
A-16
55,853 - 1.38

298/20A

I hereby certify that the map and survey
were prepared by me or under my direct
supervision and that the same comply with the
standards of the State of Connecticut as defined
Francis J. O'Donoghue L.S. 8493

6/10/83 Addition of Tracts B-1a, B-1b, B-1c & B-1d
Addition of Tracts A-1a & A-1b Nov. 1982 by R.D.

298/20A

Revised 6-3-83 by E.T.D. Rev. 12/12/84 O.A.D.

CITY OF HARTFORD, CONNECTICUT		
DEPARTMENT OF PUBLIC WORKS		
BUREAU OF ENGINEERING SERVICES		
UPPER ALBANY PROJECT		
BLOCK BOUNDED BY		
WOODLAND STREET, HOMESTEAD AVENUE		
MILFORD ST & ALBANY AVENUE		
SUBMITTED	RECOMMENDED	APPROVED
ENGINEER	CHIEF OF ENG. SERV.	ASST. DIR. & CITY ENG.
DATE	SCALE	DAYBOOK NO.
7-72	1"=50'	010799
		DATE
		APRIL 14, 1983