


Curbs and gutters
Conn Boulevard

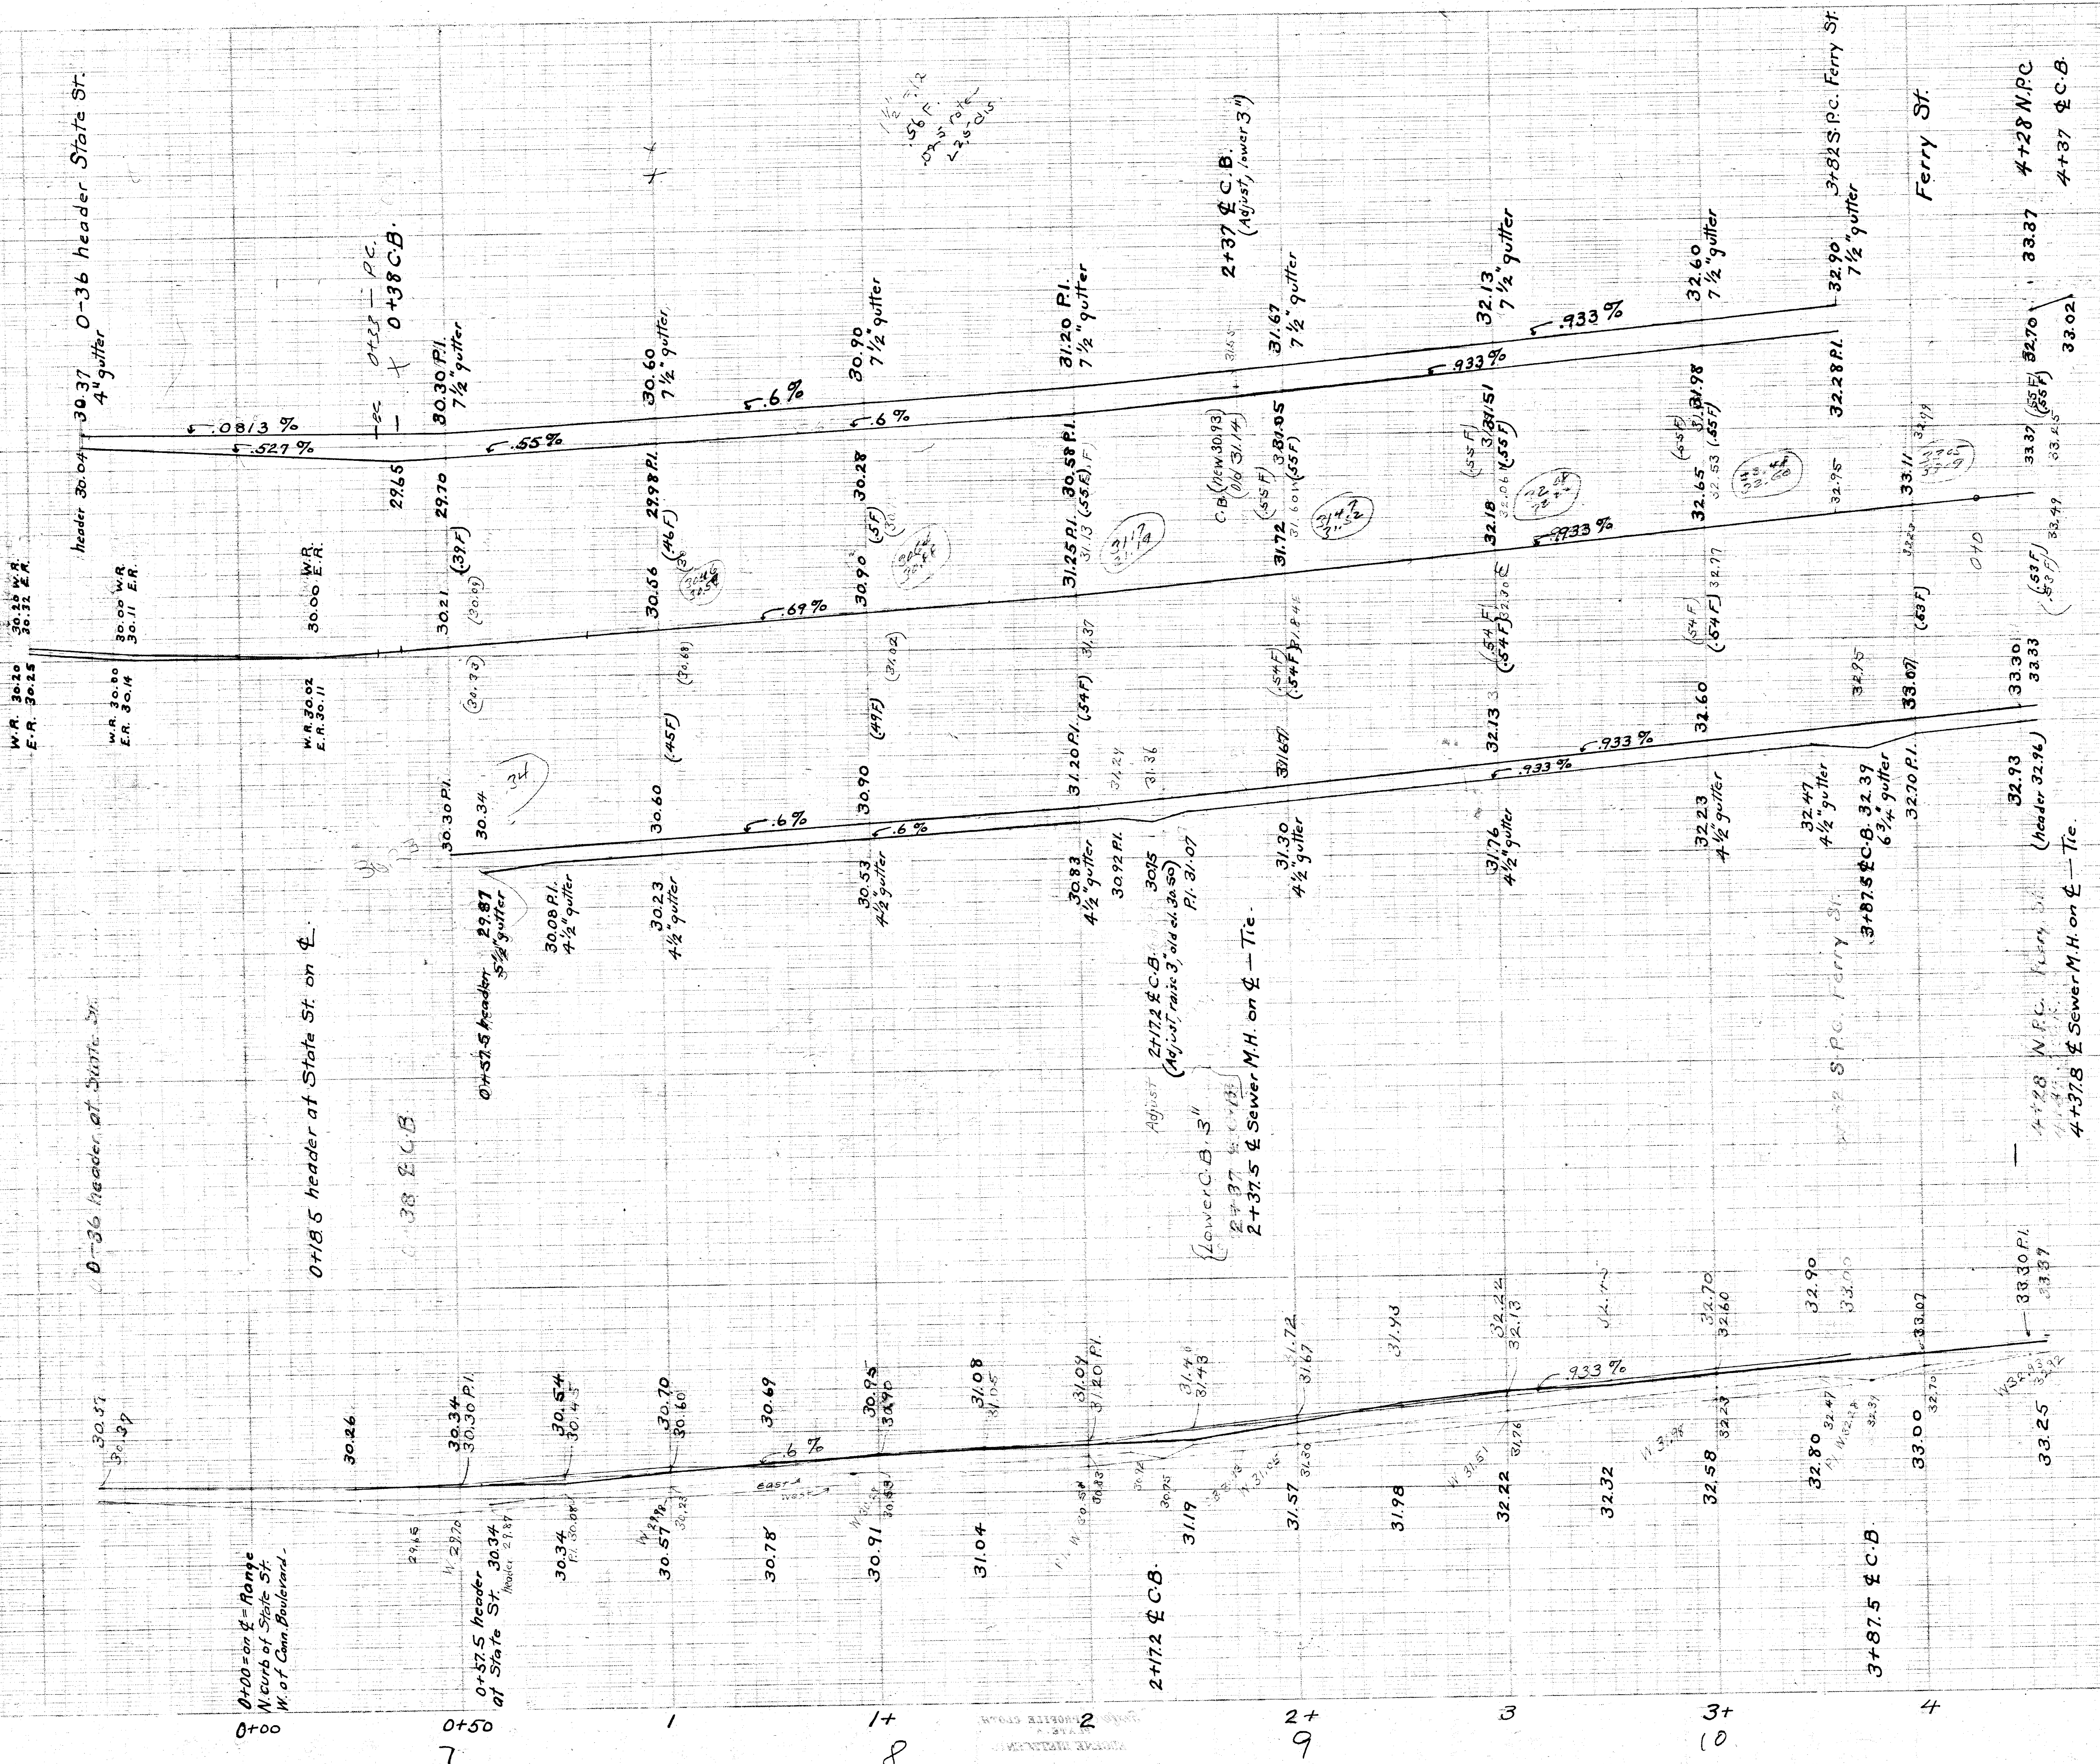

CONNECTICUT BOULEVARD
STATE ST. TO FERRY ST.
CURB AND PAVING PROFILE
HOR. SCALE 1" = 20'
VER. SCALE 1" = 2'
Stations measured on center line, 25' chords
Day book No 04056 Note book 430

Department of Engineering
Hartford Conn.
April 1916.

In horizontal curve make the dummy
rails of tracks level + to grade
1/2" super elevation in each track.

60
15
45
22 1/2
33.25
33.37
33.50
33.63

Curbs and gutters
Conn Boulevard