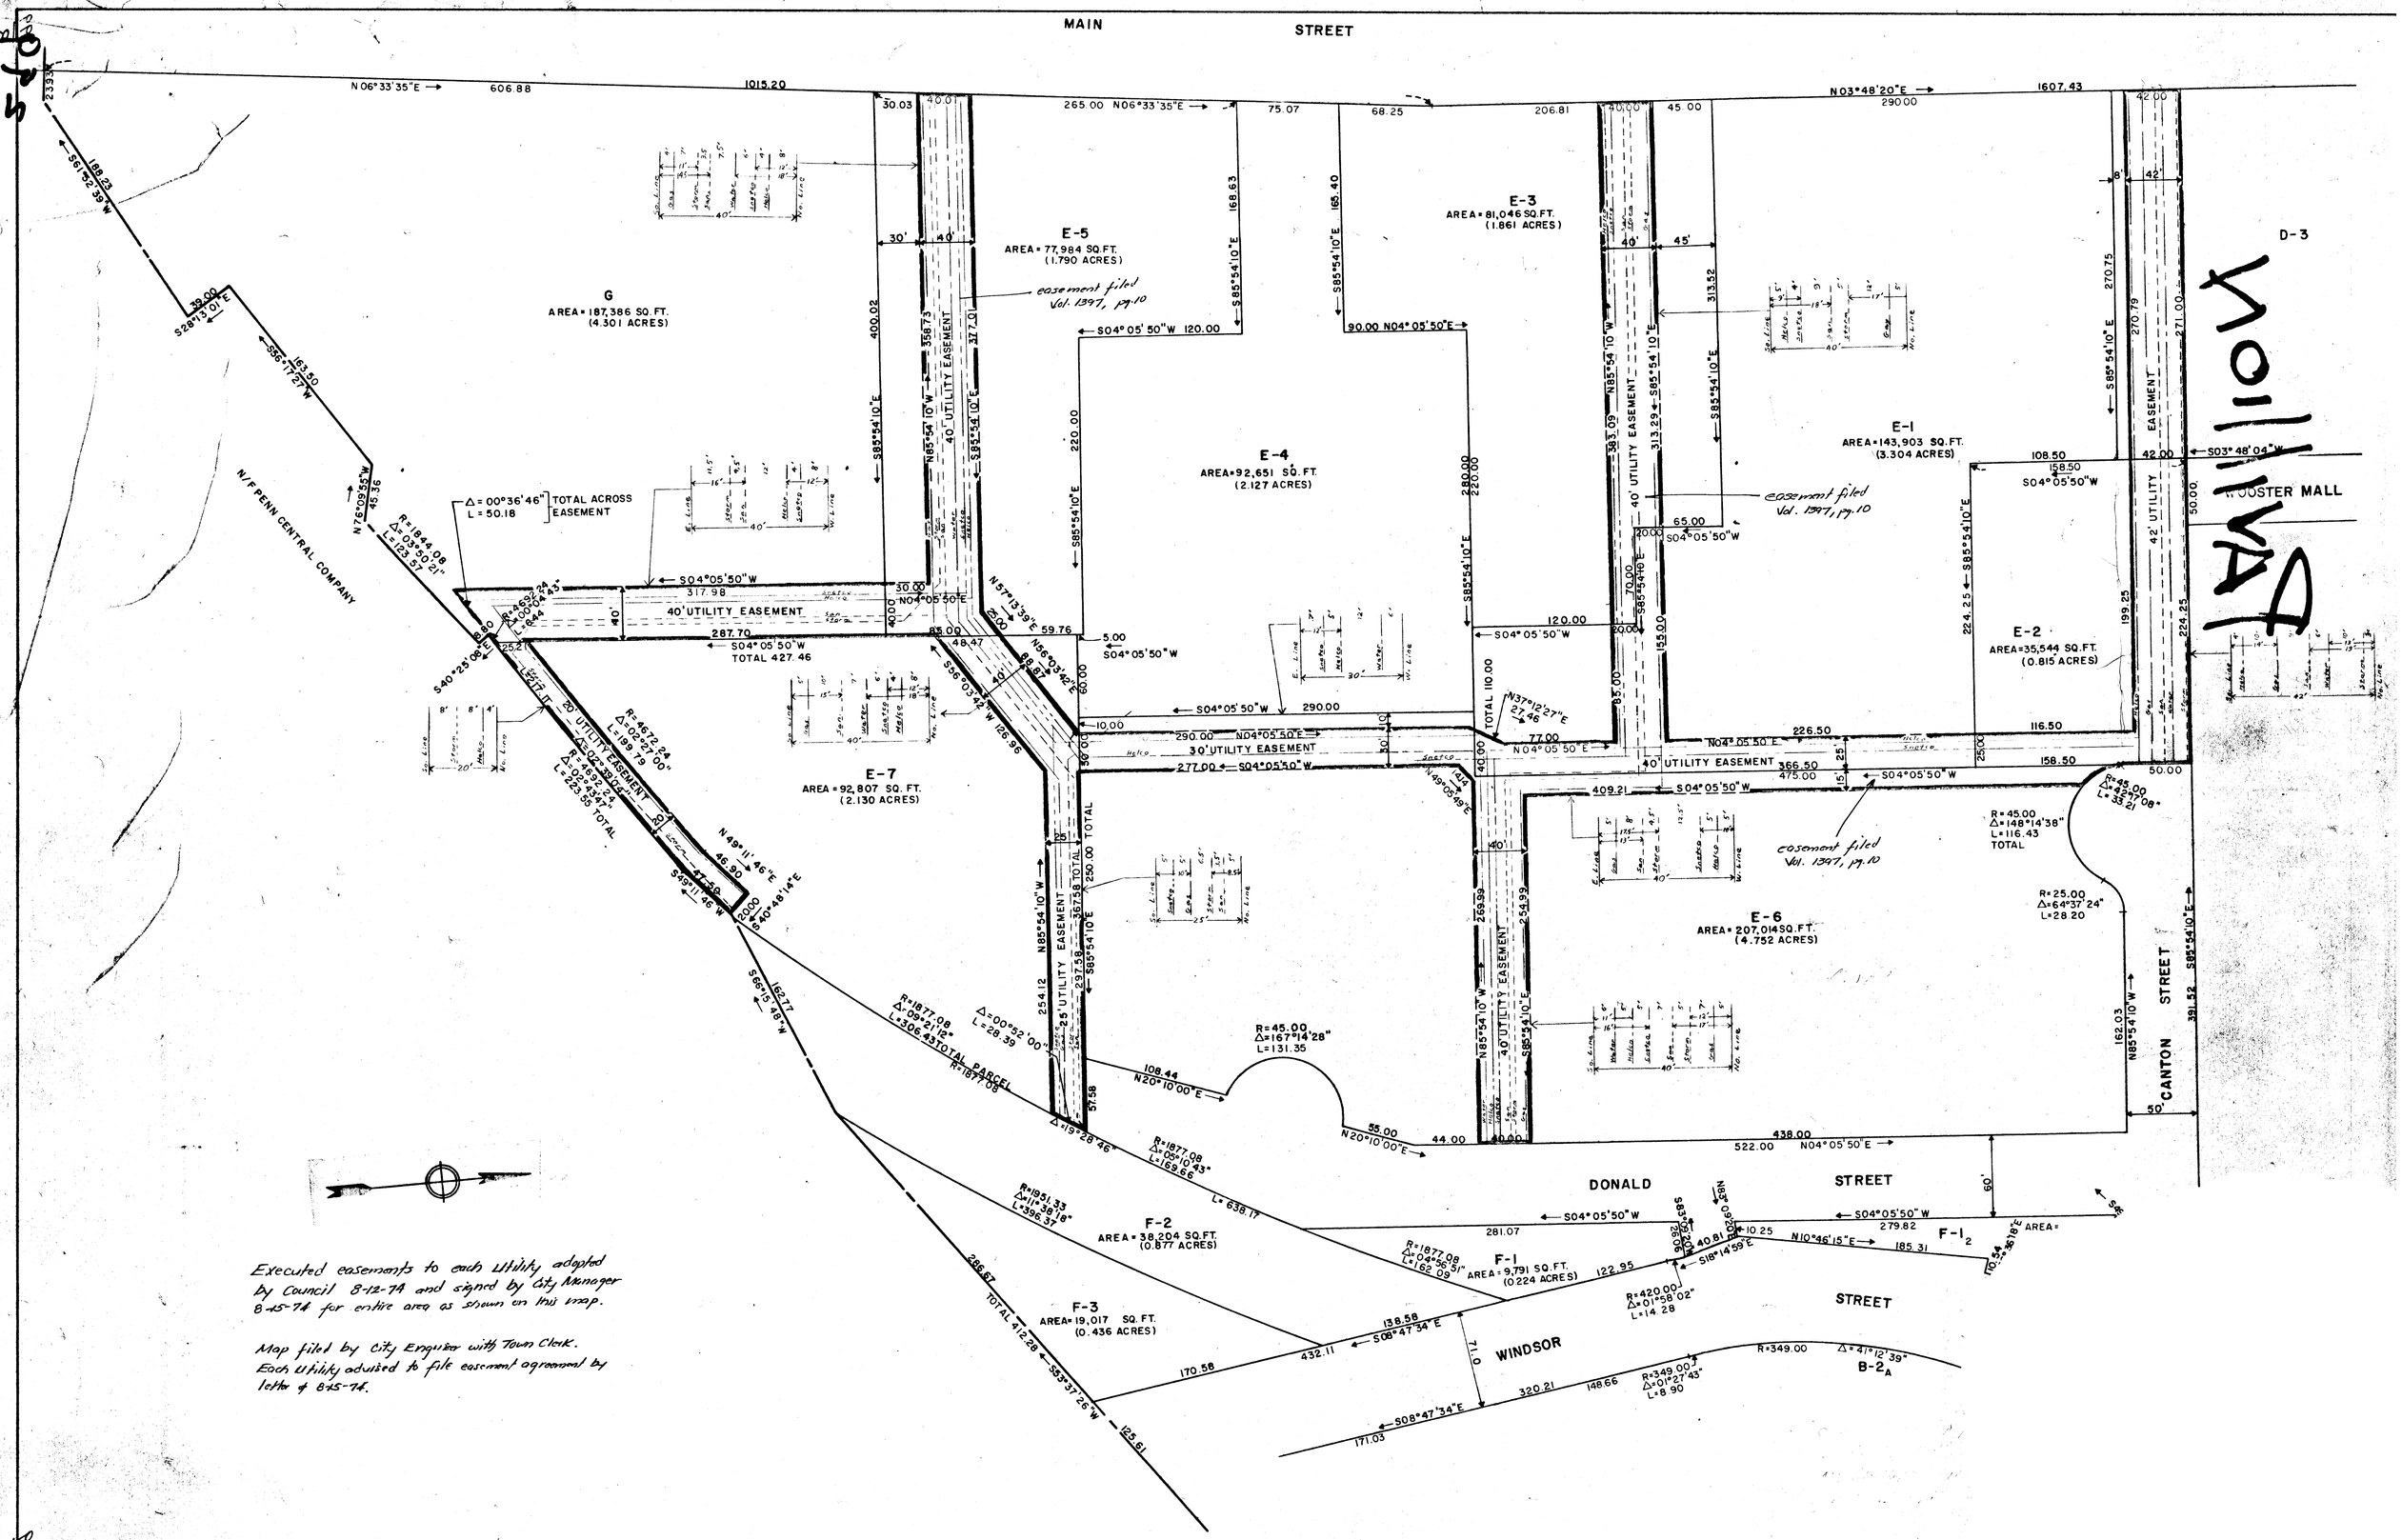

Executed easements to each utility adopted by Council 8-12-74 and signed by City Manager 8-15-74 for entire area as shown on this map.

Map filed by City Engineer with Town Clerk. Each utility advised to file easement agreement by letter of 8-15-74.

Revised - 8/6/74 - Snetco and Helco interch 40' easement west of Donald Street