


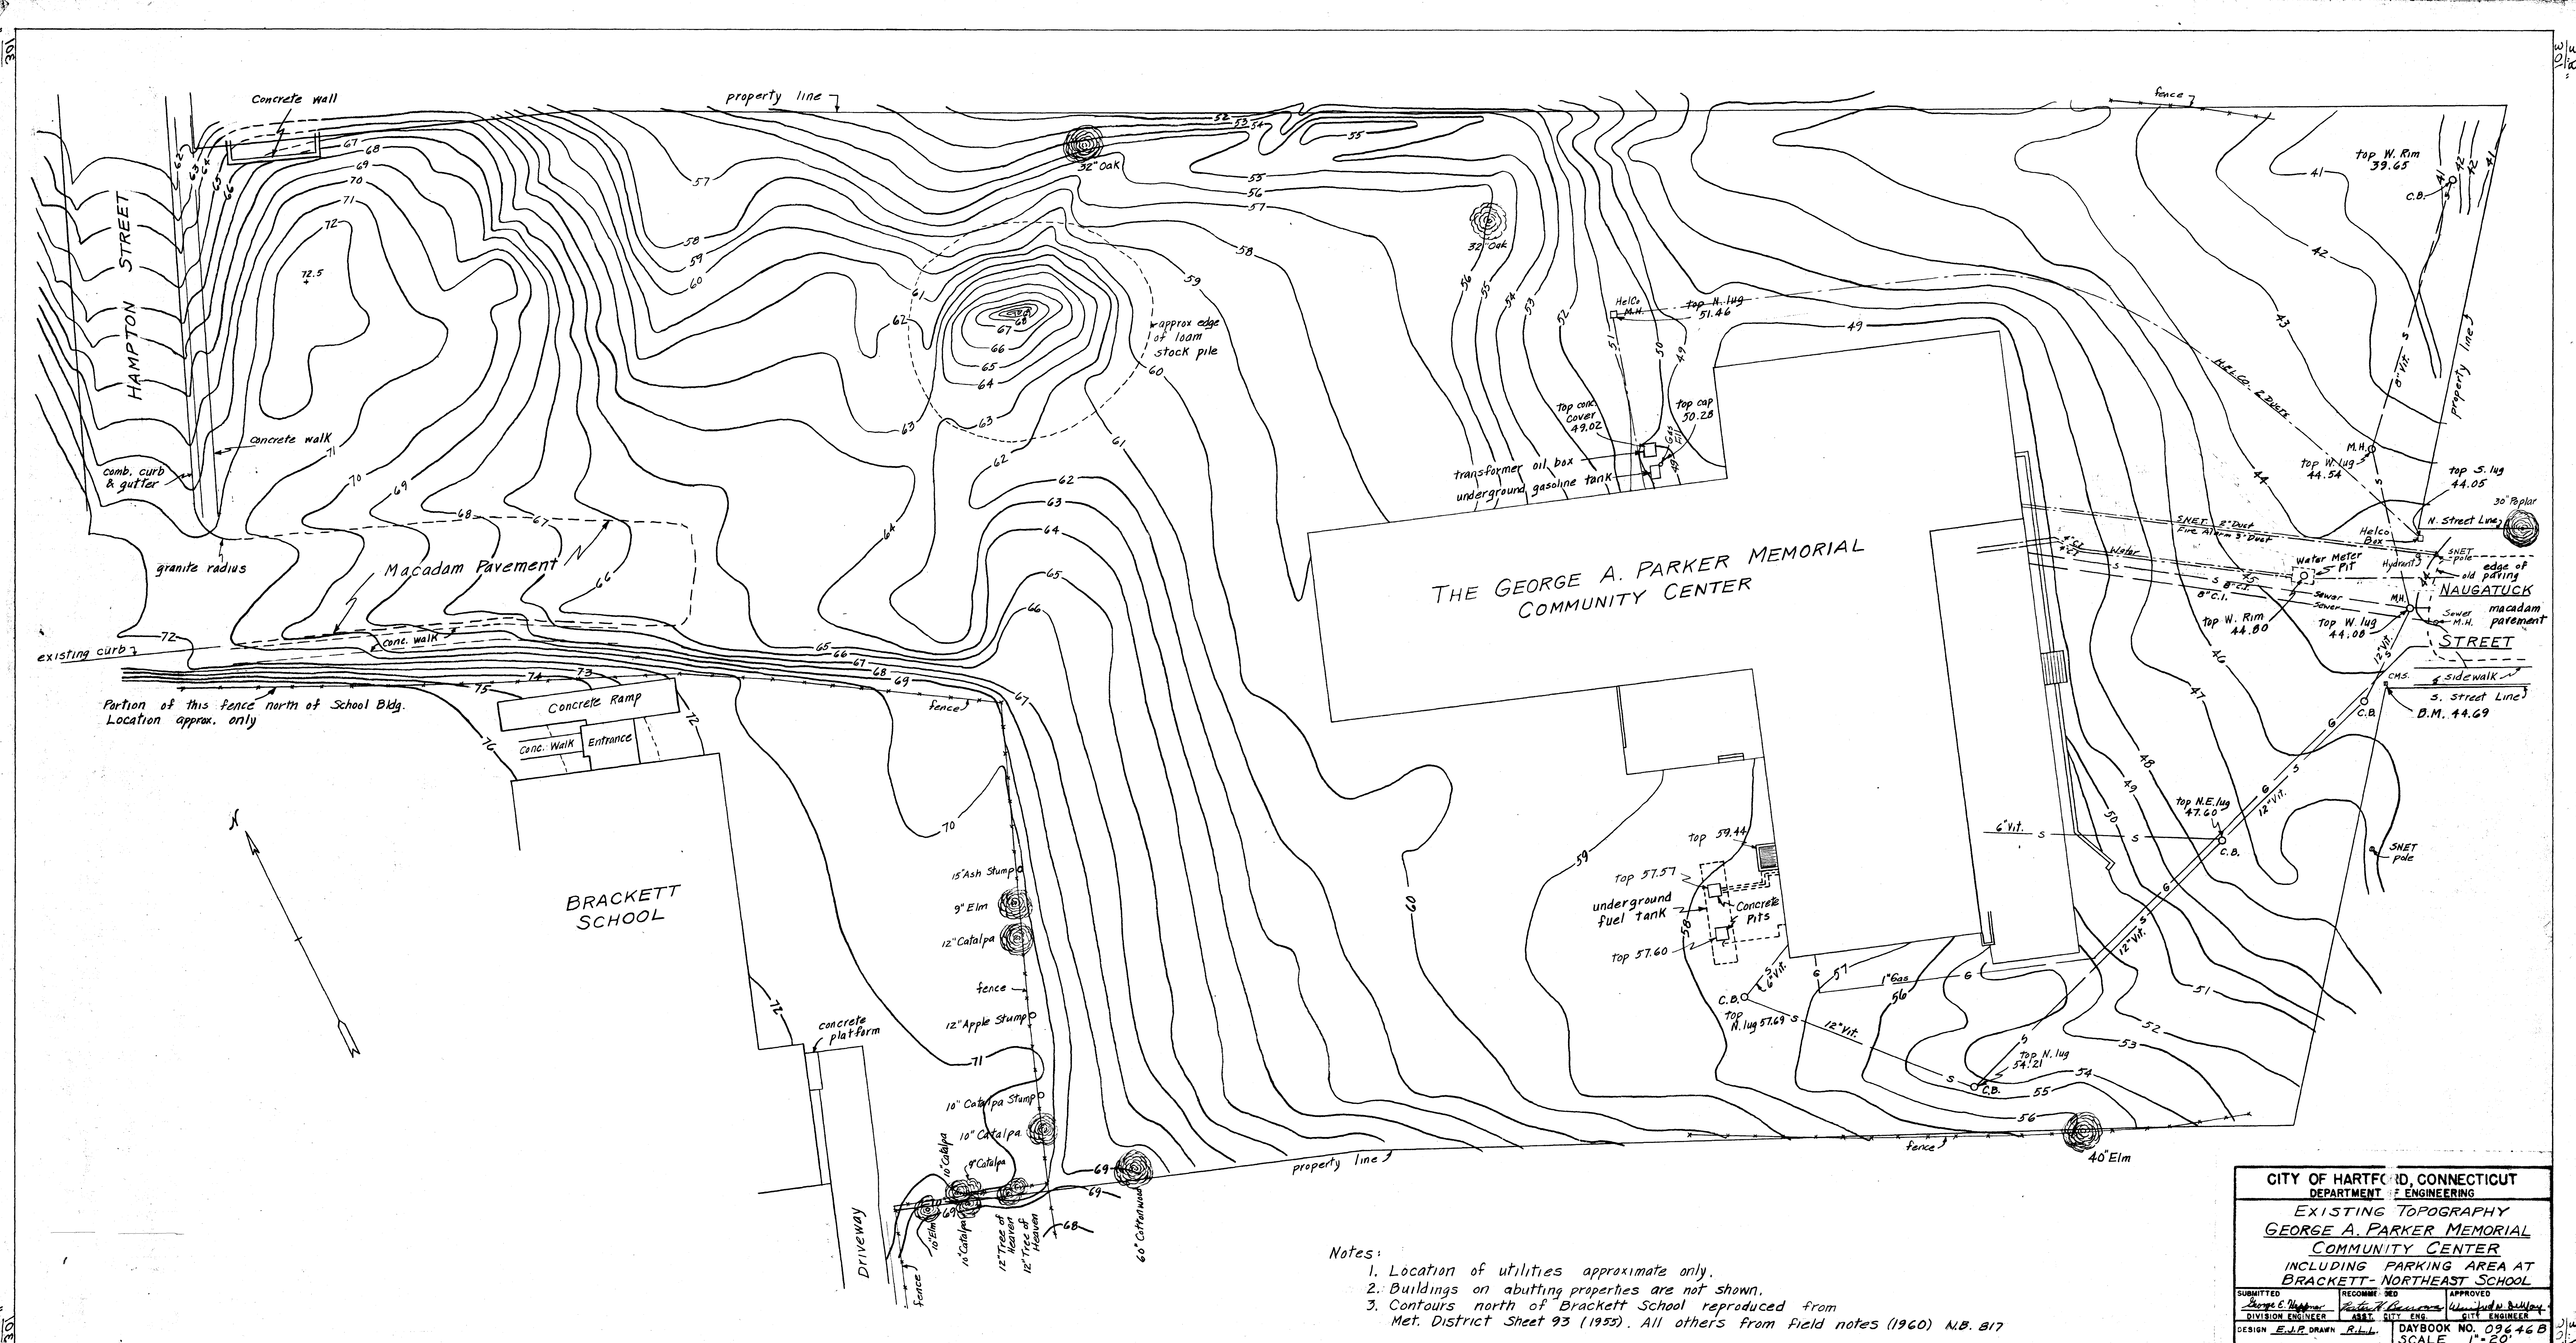

Notes:
1. Location of utilities approximate only.
2. Buildings on abutting properties are not shown.
3. Contours north of Brackett School reproduced from Met. District Sheet 93 (1955). All others from field notes (1960) N.B. 817

CITY OF HARTFORD, CONNECTICUT DEPARTMENT OF ENGINEERING			
EXISTING TOPOGRAPHY GEORGE A. PARKER MEMORIAL COMMUNITY CENTER INCLUDING PARKING AREA AT BRACKETT-NORTHEAST SCHOOL			
DESIGN E.J.P. DRAWN R.L.L. CHECK E.J.P.		DAYBOOK NO. 09646B SCALE 1"=20' DATE OCTOBER 1960	