


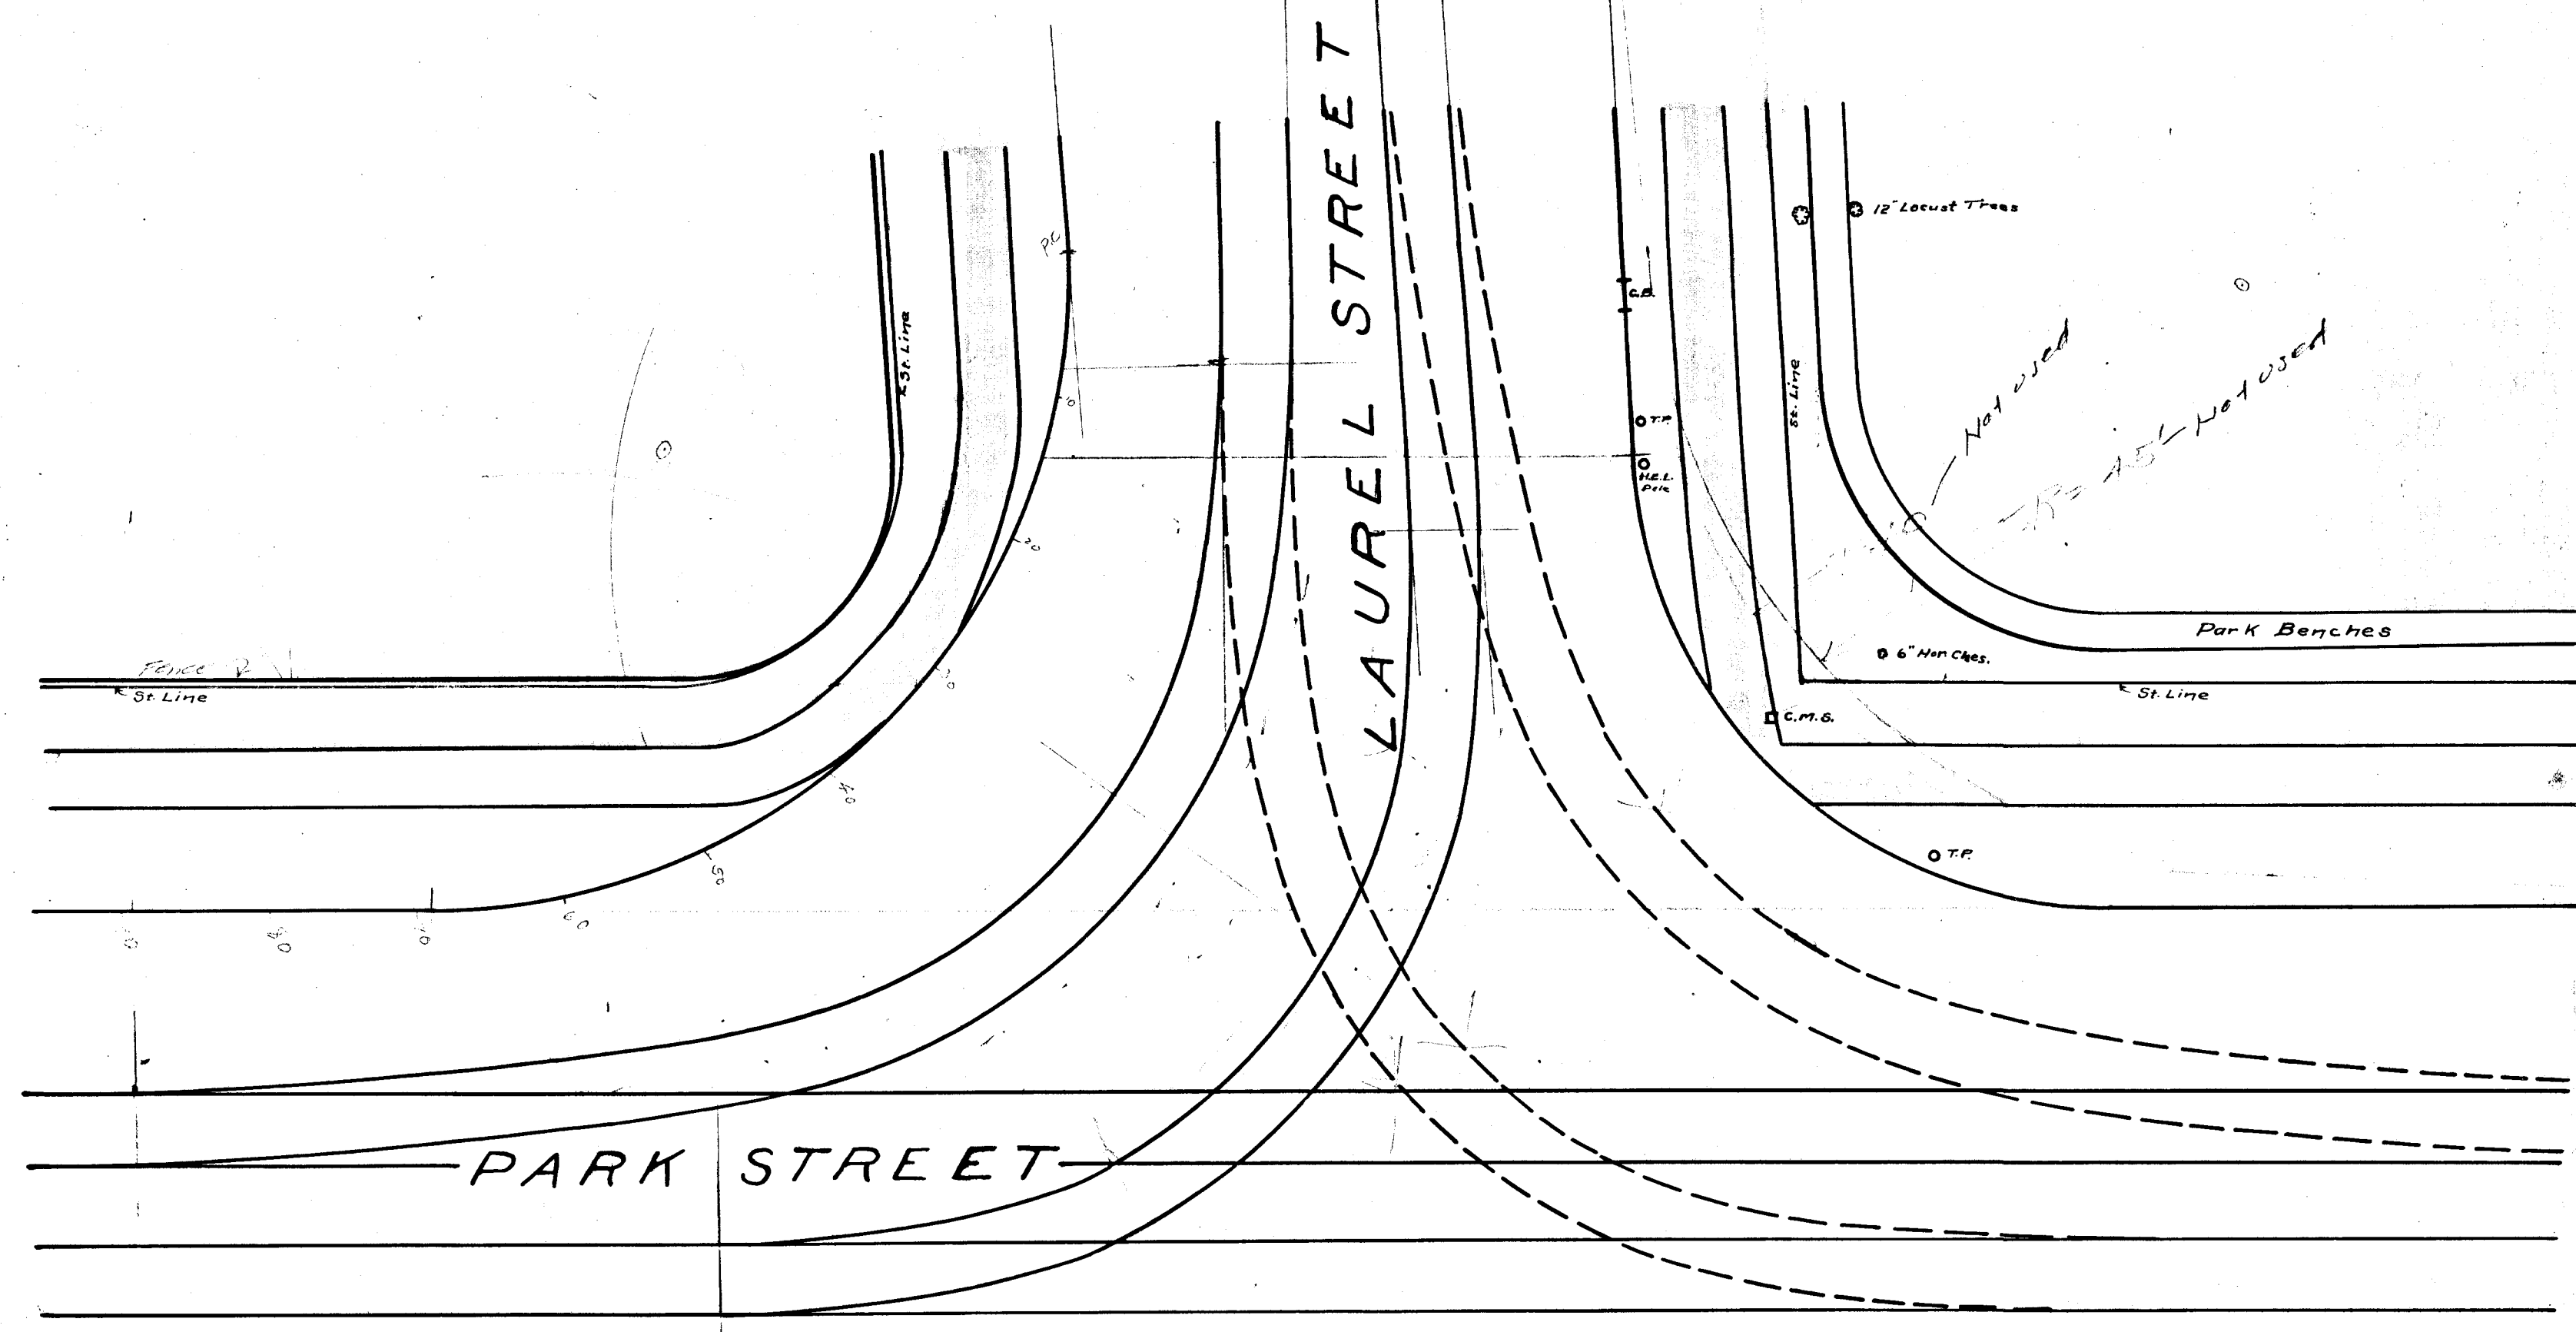

POPE PARK DRIVE

Department of Engineering
 Hartford, Conn.
 Plan of Proposed Location of Tracks
 at the
 Intersection of Laurel and Park Streets
 Scale 1"=10' June 1916