


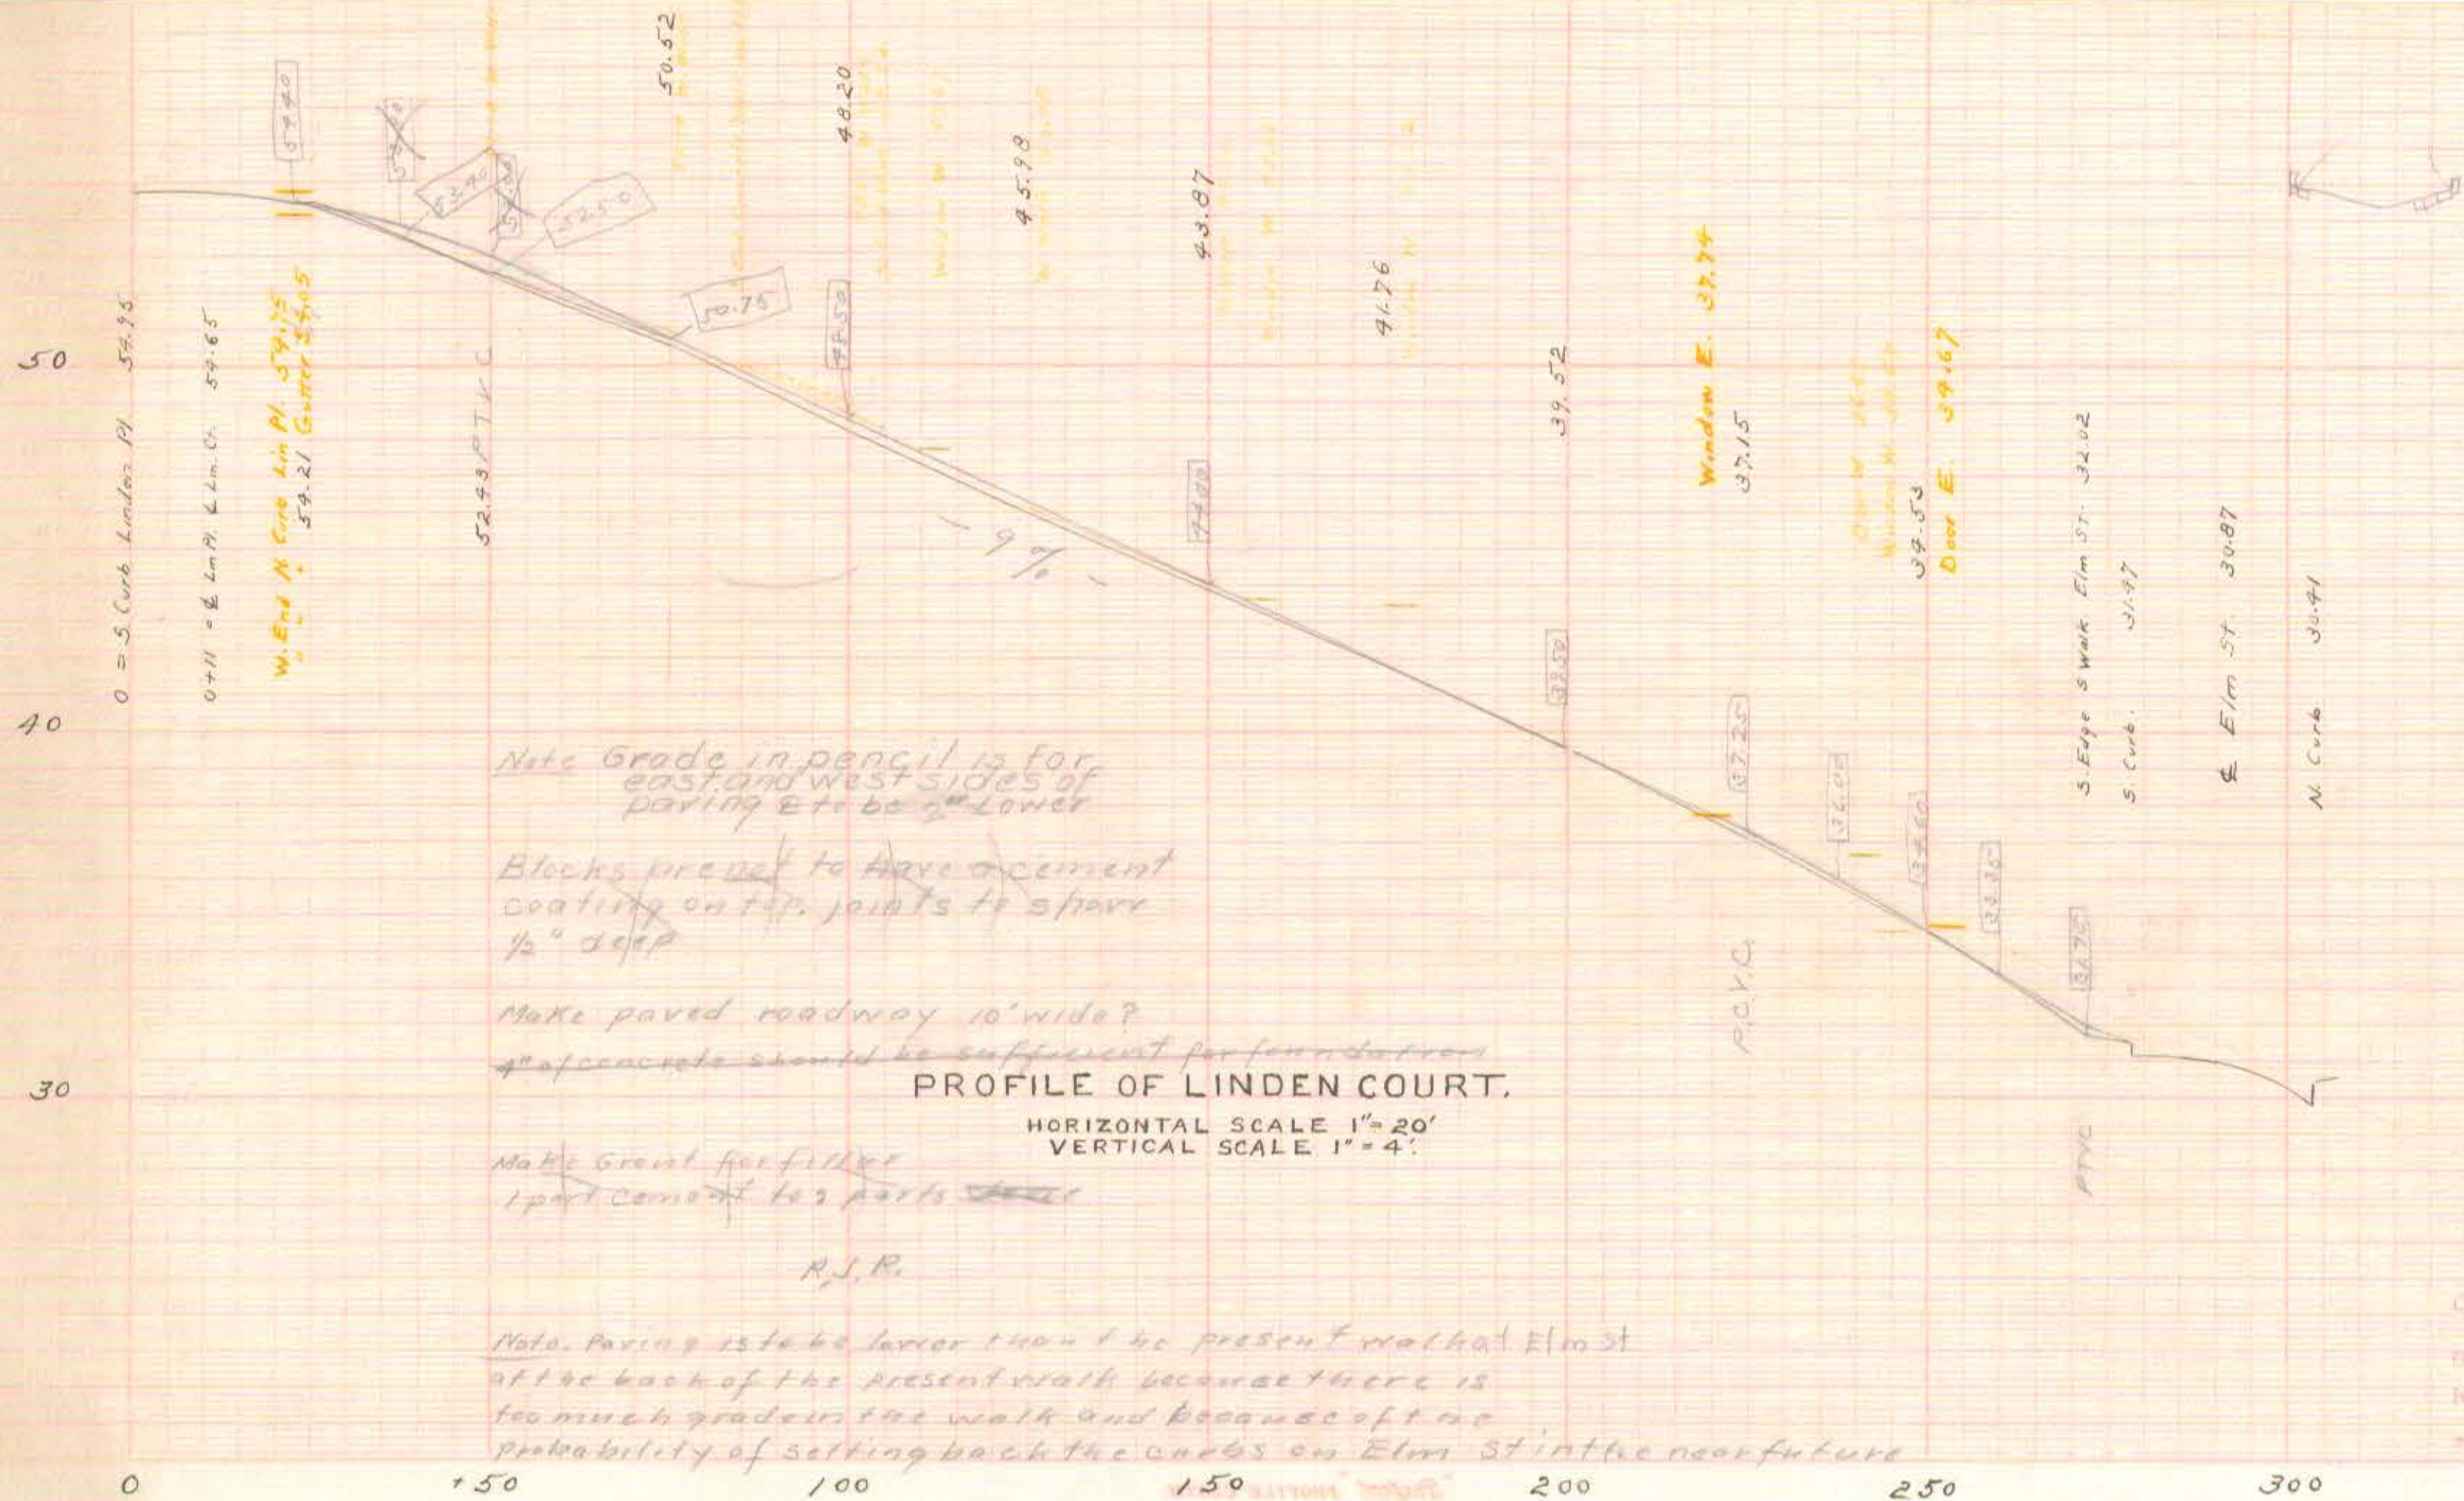

Note Grade in pencil is for east and west sides of paving etc to be 2" lower

Blocks prepared to have a cement coating on top. joints to spave 1/2" deep

Make paved roadway 10' wide?

4" of concrete should be sufficient for foundations

PROFILE OF LINDEN COURT.

HORIZONTAL SCALE 1" = 20'
VERTICAL SCALE 1" = 4'

Make Gravel for filler
1 part cement to 3 parts ~~stone~~

R.J.R.

Note. Paving is to be lower than the present walk at Elm St at the back of the present walk because there is too much grade in the walk and because of the probability of setting back the curbs on Elm St in the near future

OFFICE OF CITY ENGINEER
Sept. 1912
360-87
R.N. Clark

03061