


Village St.
Scale 1" = 20'
PROGRESS MAP
PAVING
1915

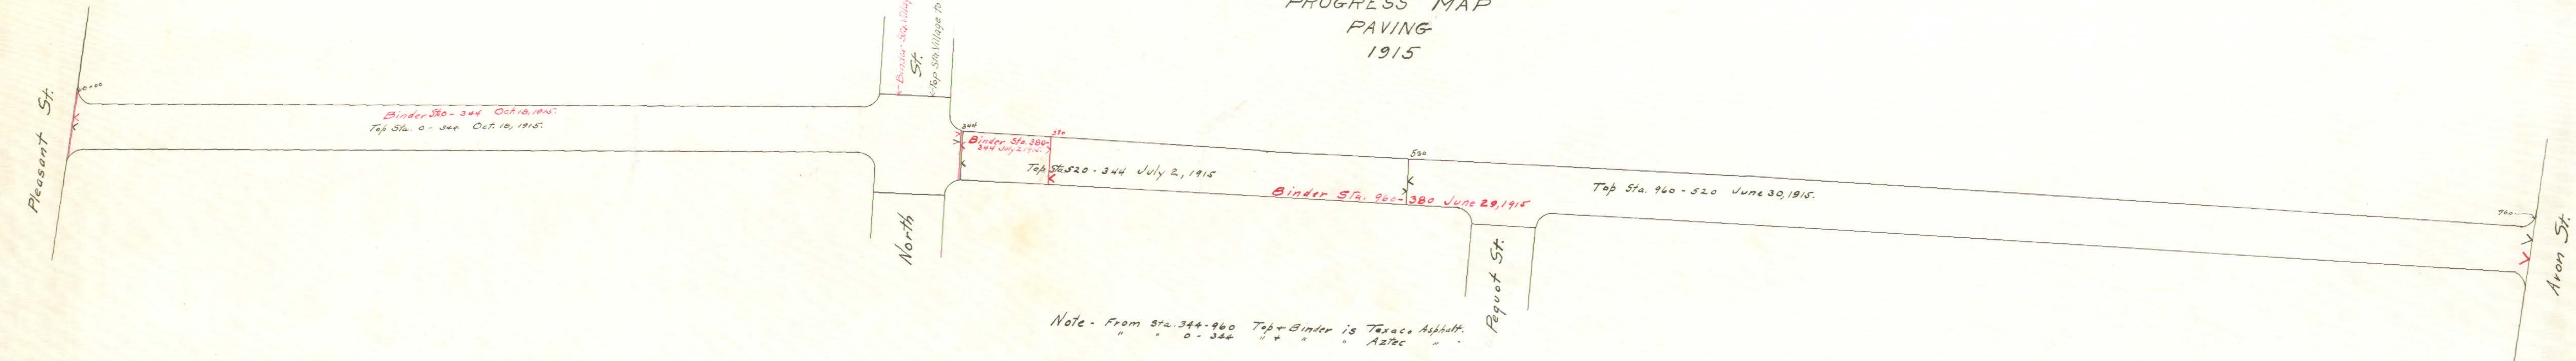

Note - From Sta. 344 - 960 Top + Binder is Texaco Asphalt.
" " 0 - 344 " + " " Aztec "