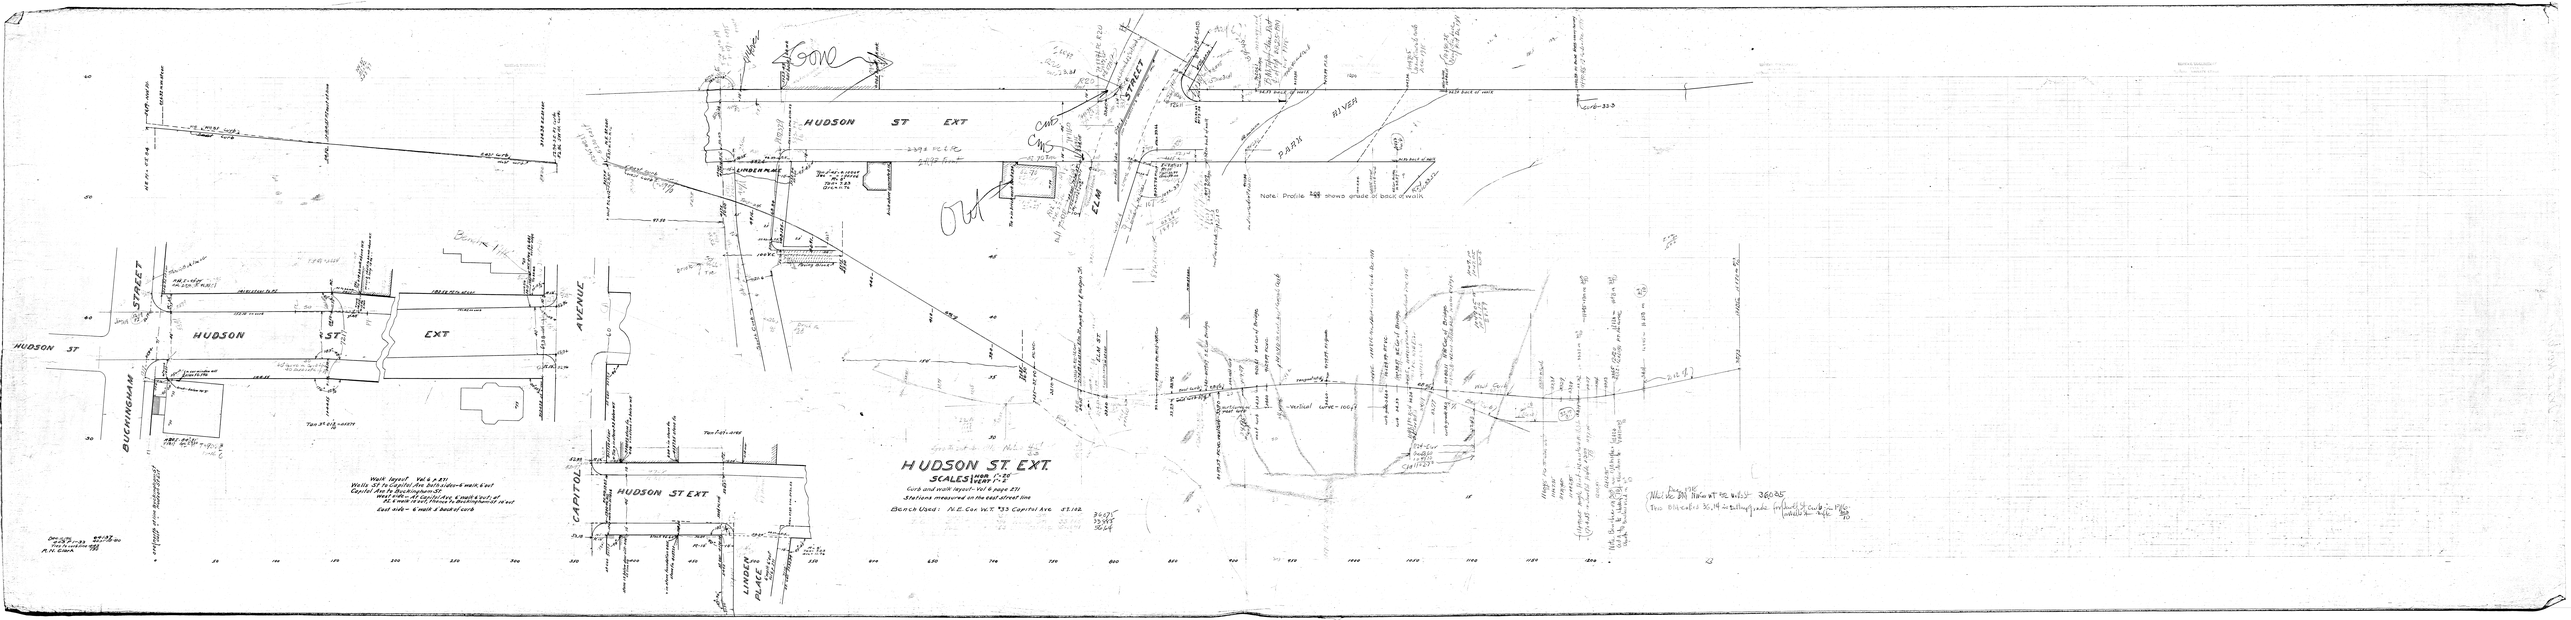
HUDSON ST EXT
HUDSON ST
BUCKINGHAM STREET
CAPITOL AVENUE
LINDEN PLACE
ELM STREET
PARK RIVER
Note: Profile shows grade at back of walk.
Walk layout Vol 2 p 231
Walks 33' to Capitol Ave. Setback on 4 walk, East
Capitol Ave. to Buckingham St.
Walks 33' to Buckingham St. Ave. 4 walk West of
Elm 4 walk East of Elm to Buckingham St. ave.
East side - 4 walk 4 back of curb
HUDSON ST EXT
SCALES: HOR. 1" = 20'
VERT. 1" = 2'
Curb and walk layouts Vol 2 page 231
Stations measured on the east street line
Bench Used: N.E. Cor. W.T. #33 Capitol Ave. 37.182
Vertical curve - 1067'
Wall Curb
Wall Curb