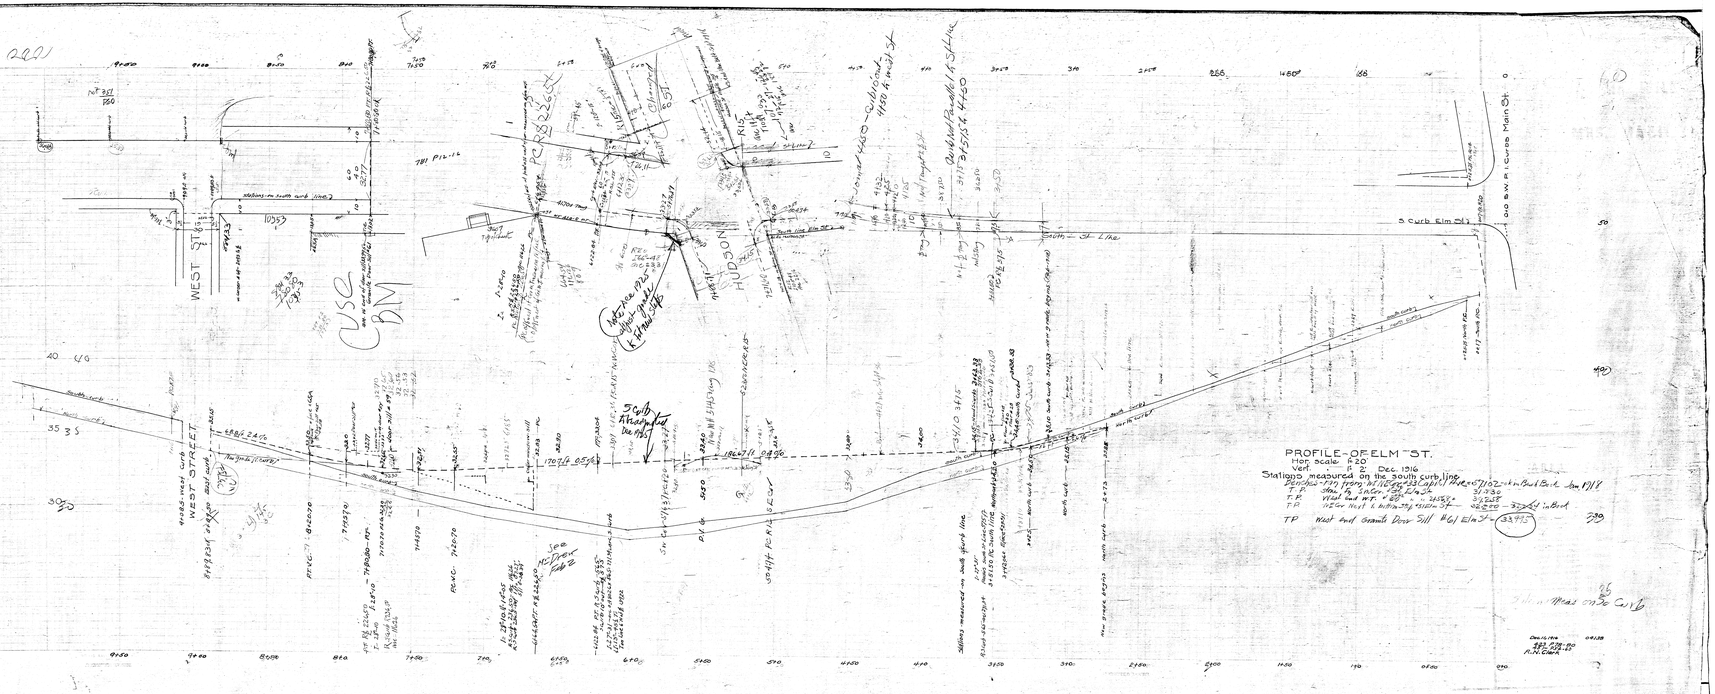
PROFILE OF ELM ST.
Hor. scale: 1:20
Vert. " 1:2 Dec 1916
Stations measured on the south curb line
WEST STREET
HUDSON
S. Curb Elm St.
S. & N. R. Curbs Main St.