


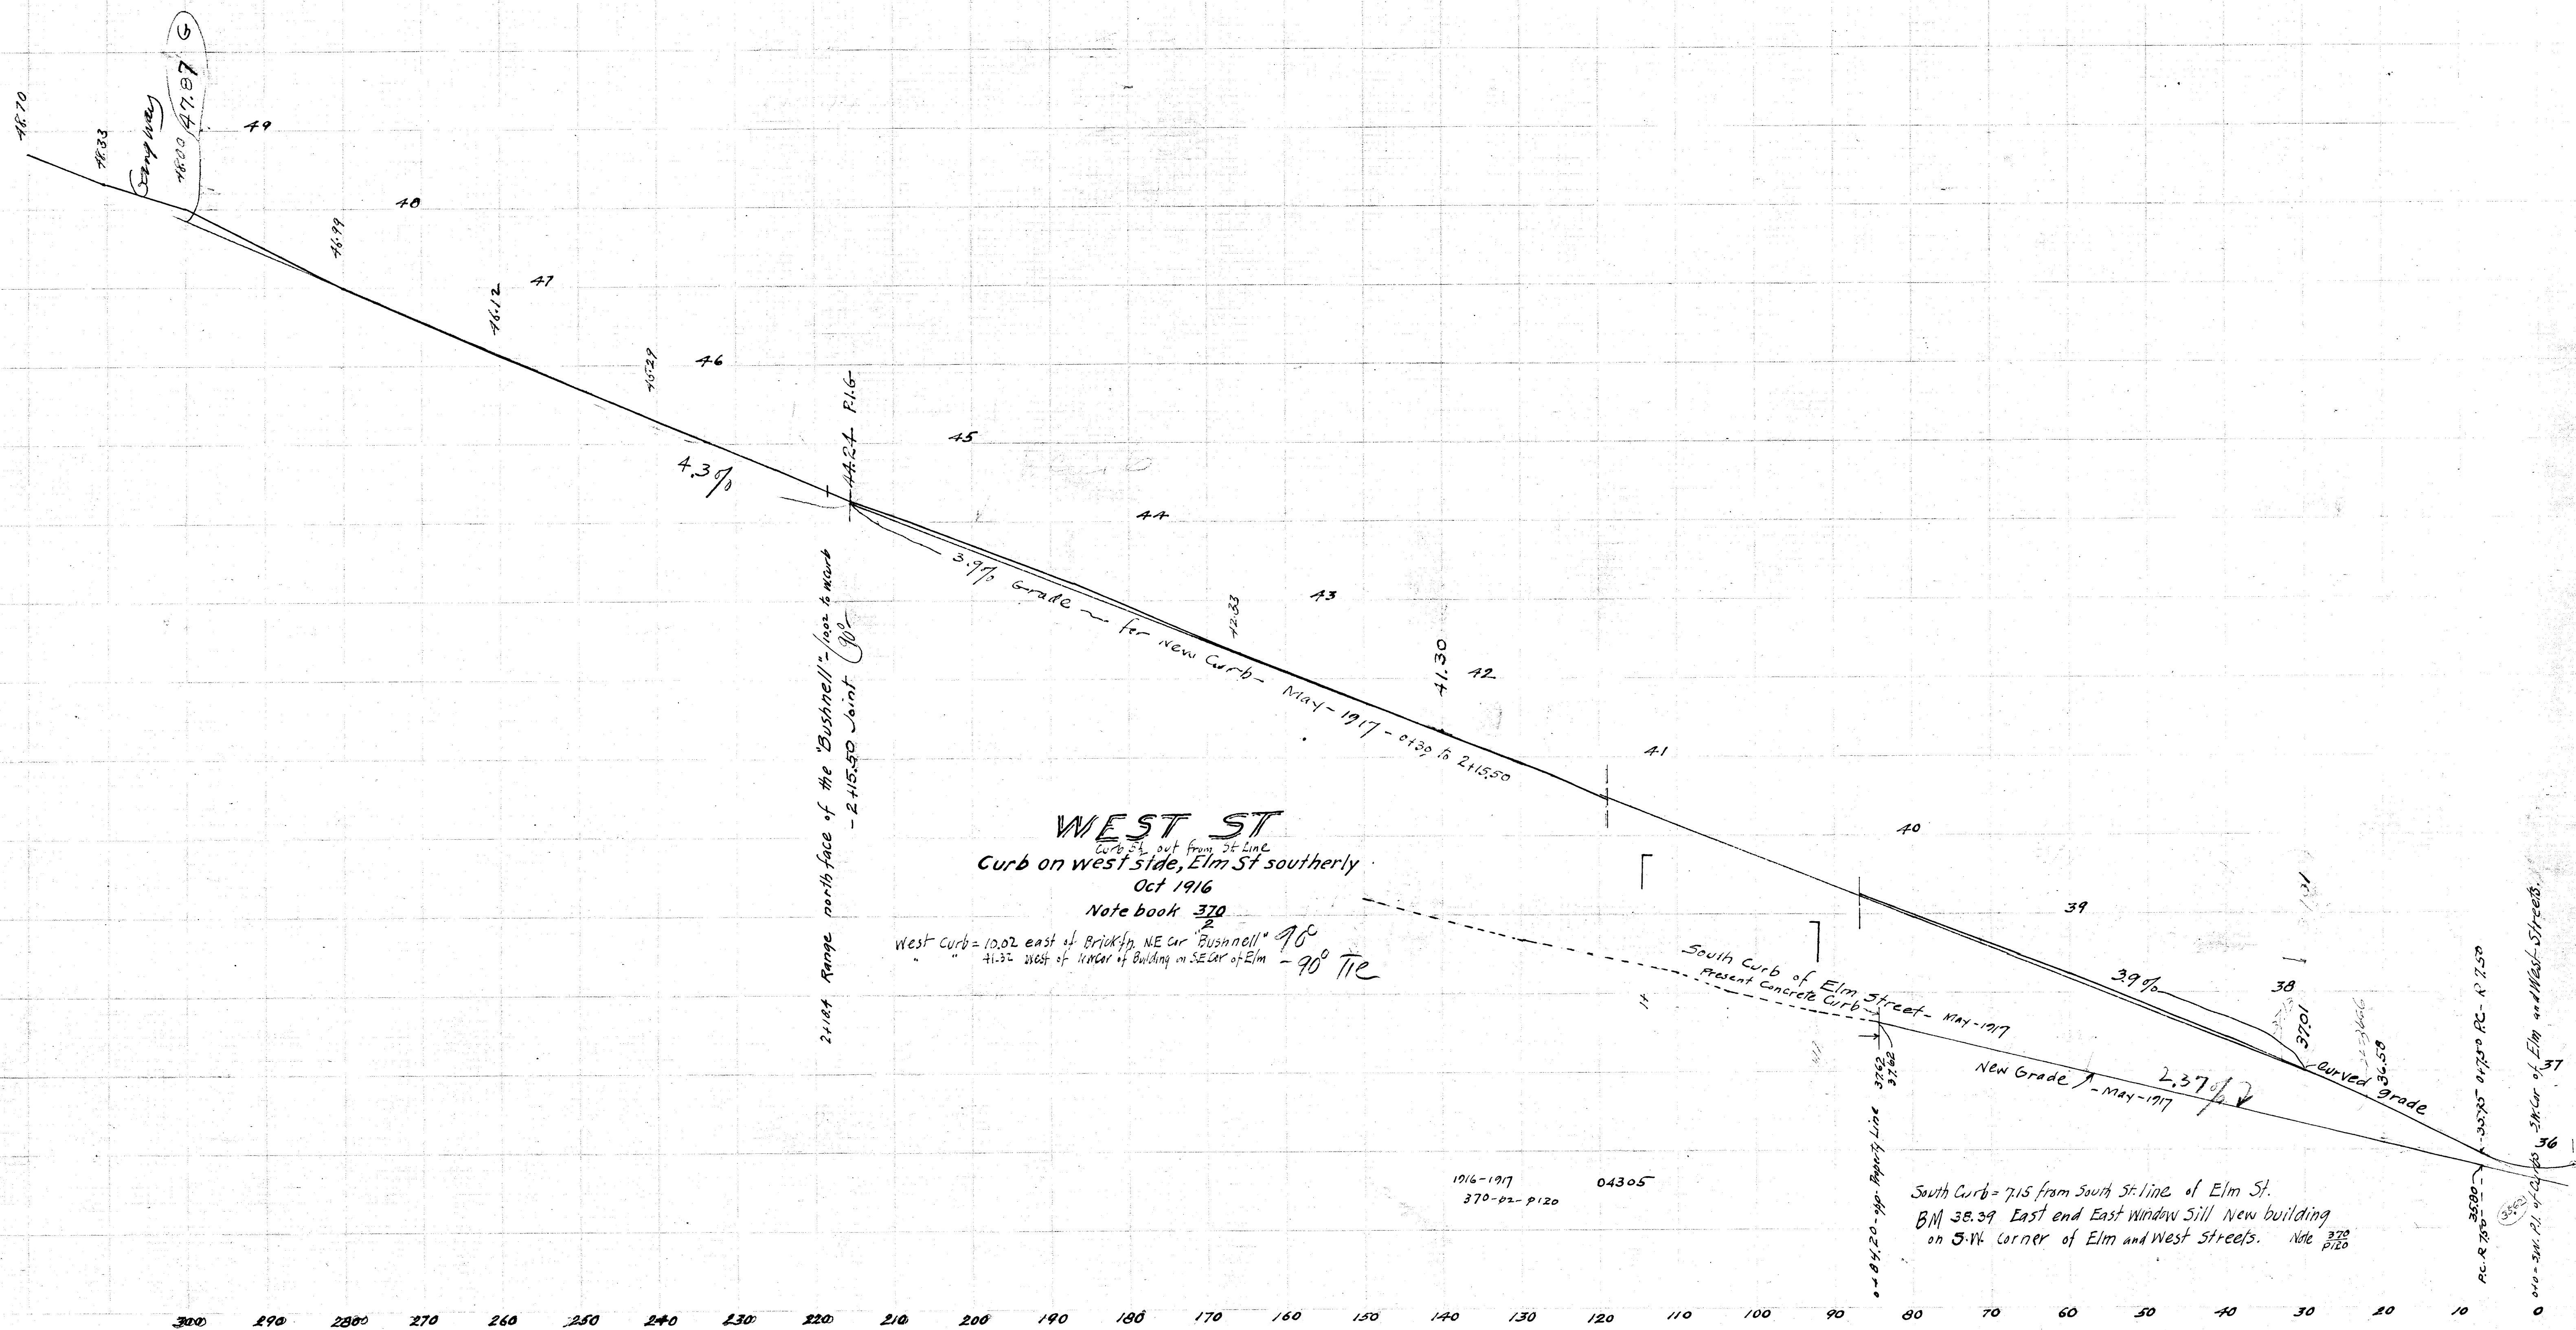

WEST ST
Curb on west side, Elm St southerly
Oct 1916

Note book 370
West Curb = 10.02 east of Brick St. NE cor. Bushnell
41.32 West of 1/4 sec. of Building on SE cor. of Elm - 90° Tie

2.184 Range north face of the "Bushnell" - 1000 ft. west
- 2415.50 Joint

3.9% grade for new curb - May - 1917 - 0130 to 2415.50

South Curb of Elm Street - May - 1917
Present Concrete Curb

New Grade - May - 1917

South Curb = 7.15 from South St. line of Elm St.
BM 38.39 East end East Window Sill New building
on S.W. corner of Elm and West Streets. Note p. 120

PC R 7500 - 1-35750 04750 R2 - R 750
040-200 PL 042000 - 3/4 cor. of Elm and West Streets

300 290 280 270 260 250 240 230 220 210 200 190 180 170 160 150 140 130 120 110 100 90 80 70 60 50 40 30 20 10 0