NOTE: For sidewalk details on north side of street see sheet 2 of 2.

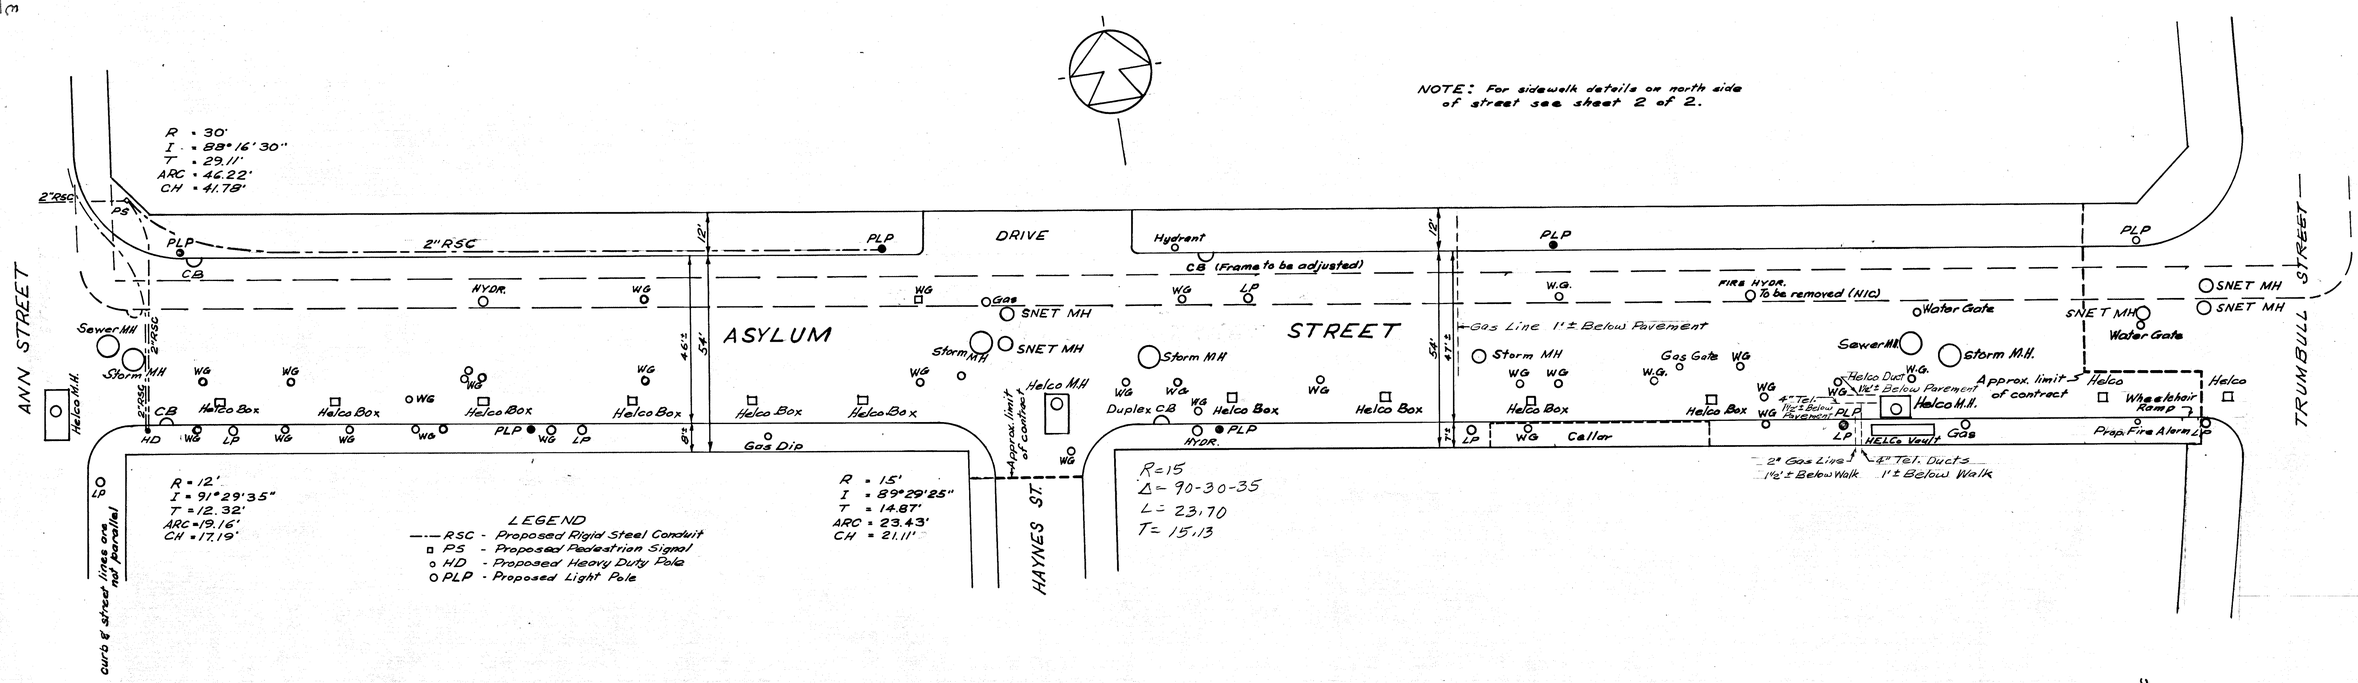

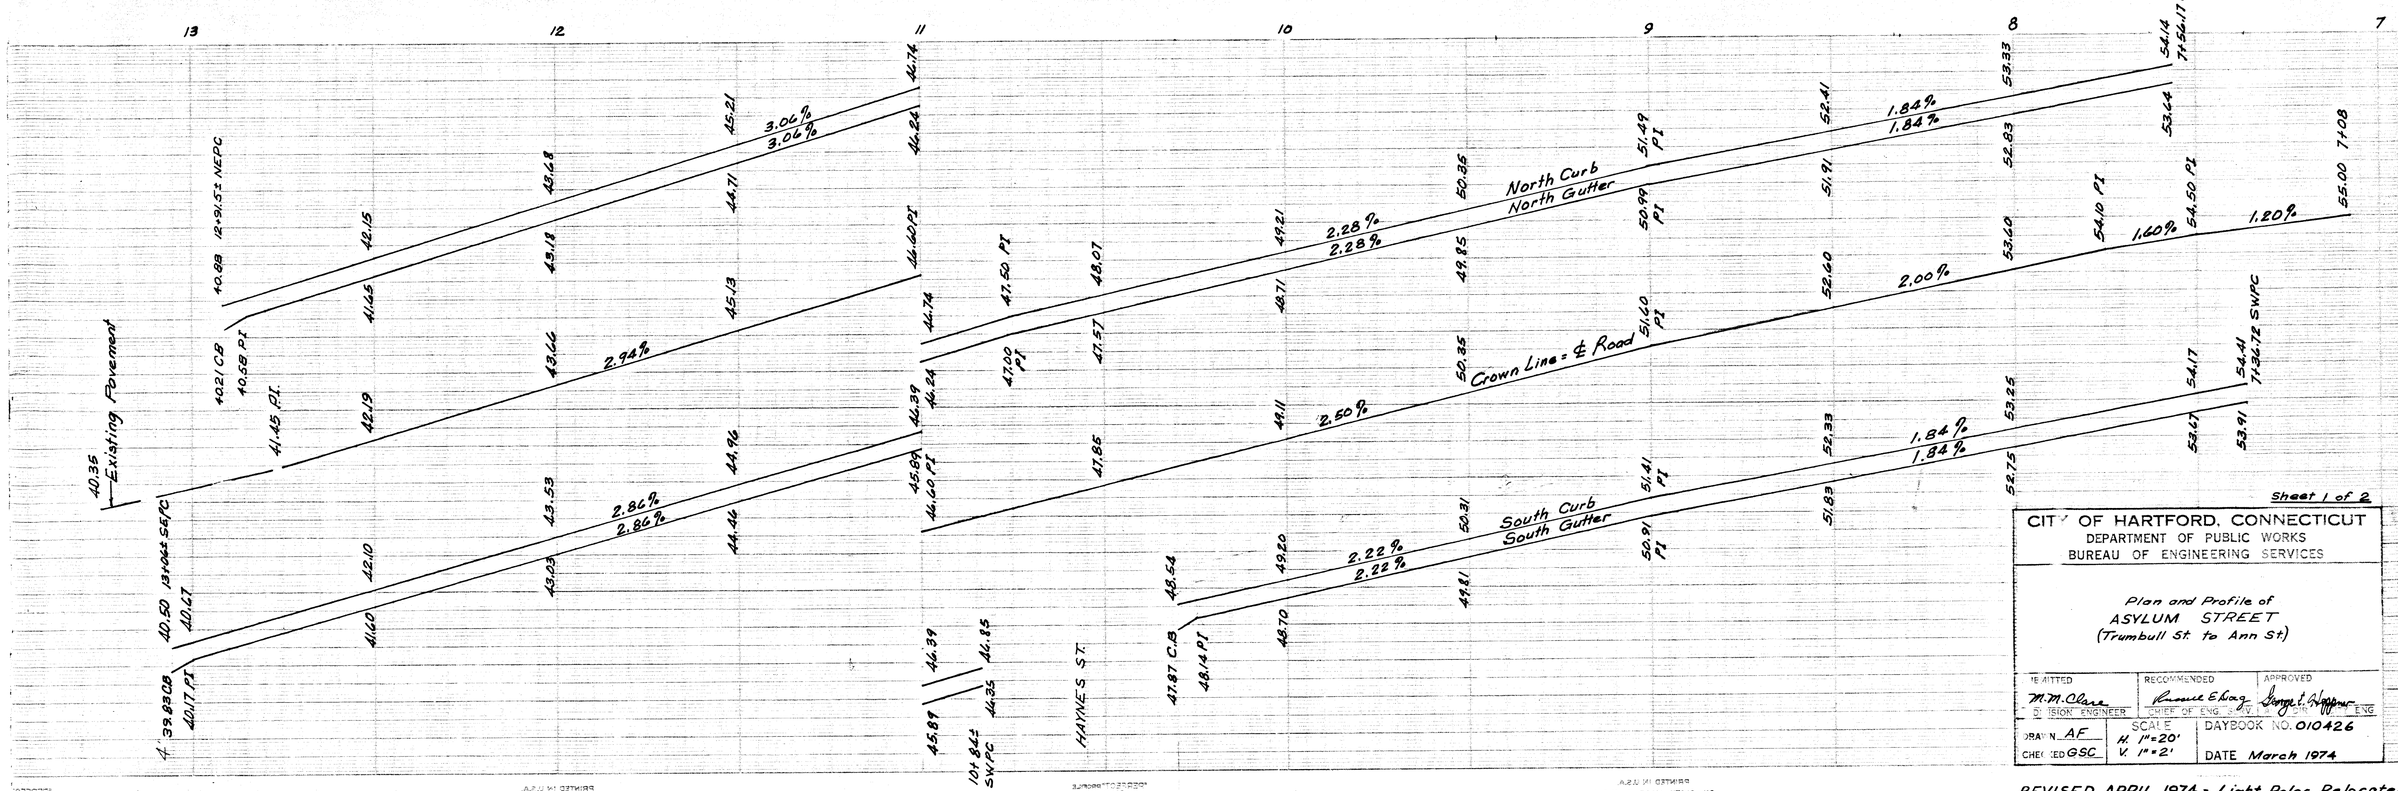

Sheet 1 of 2

CITY OF HARTFORD, CONNECTICUT
DEPARTMENT OF PUBLIC WORKS
BUREAU OF ENGINEERING SERVICES

Plan and Profile of
ASYLUM STREET
(Trumbull St. to Ann St.)

SUBMITTED	RECOMMENDED	APPROVED
M.M. Clare	Russell E. Haag	George T. Hoffman
DIVISION ENGINEER	CHIEF OF ENG. SVS.	CITY ENGINEER

DRAWN AF	SCALE H 1"=20' V 1"=2'	DAYBOOK NO. 010426
CHECKED GSC		DATE March 1974

REVISED APRIL 1974 - Light Poles Relocated