


OFFICE OF CITY ENGINEER
HARTFORD CONN.
VAN DYKE AVE.
Showing
Proposed Catch Basin Drains.
Scale 1"=40 Ft. June 1917.
Day Book No. 04333.

Note: This basin may be connected
to present sewer.

MASSEK ST.

SEQUASSEN ST.

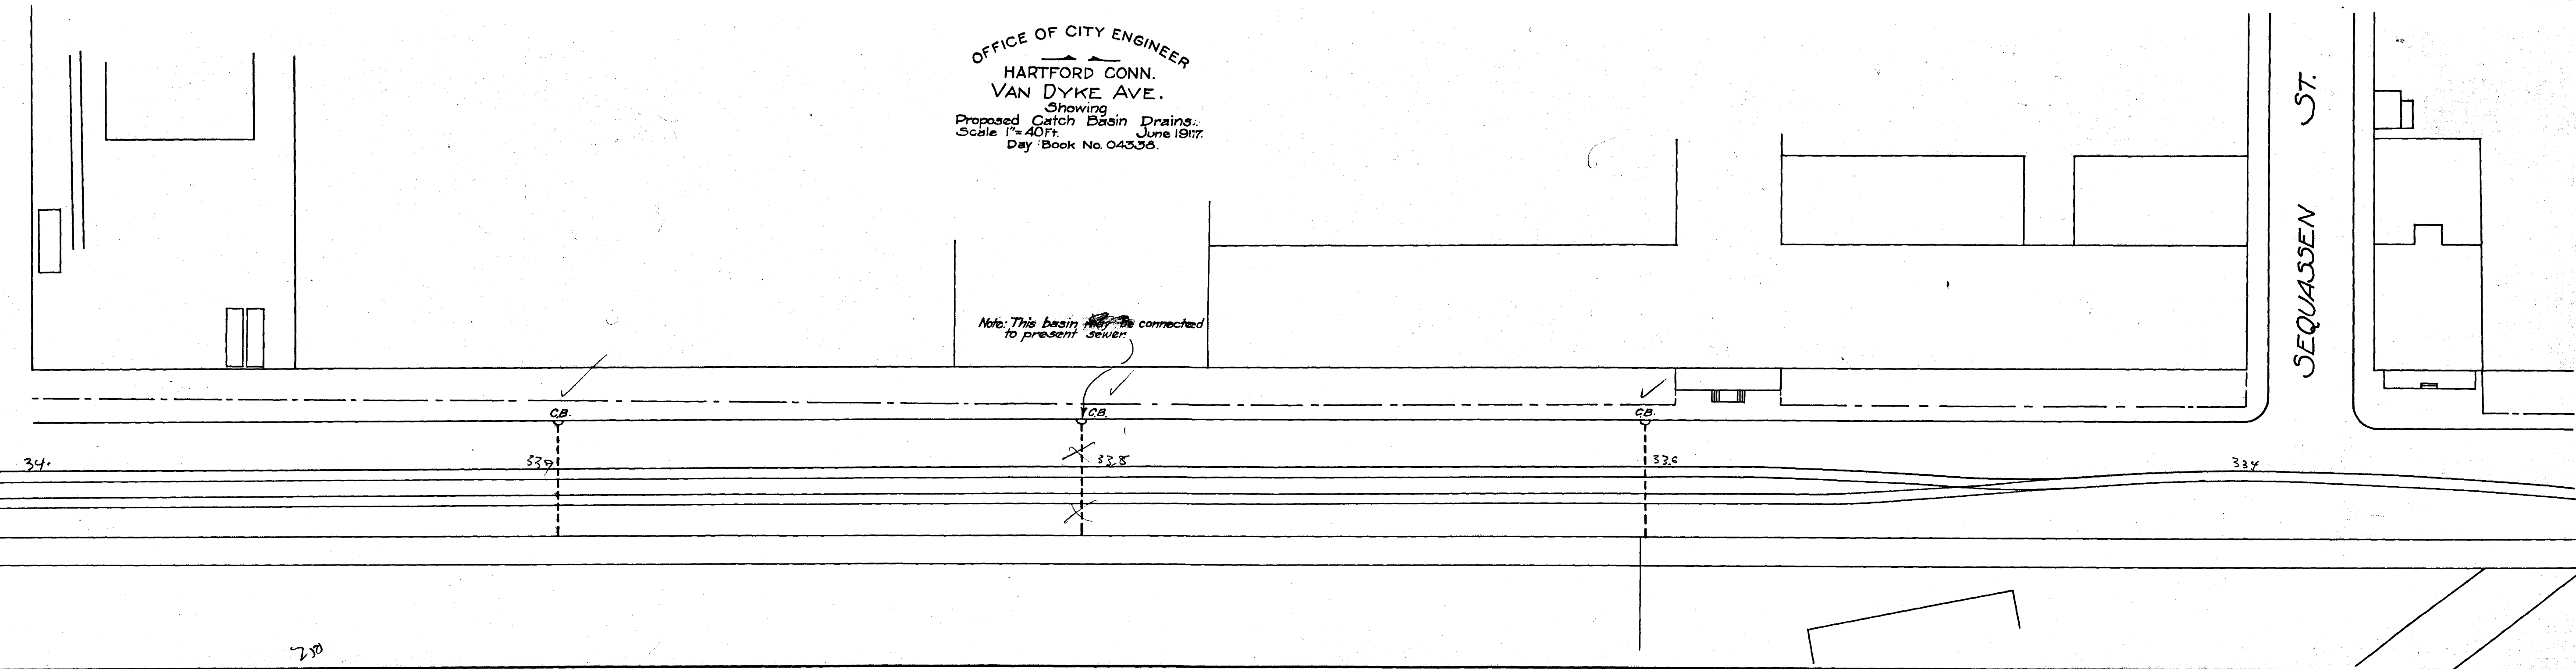

34.0

33.9

33.8

33.6

33.4

250

450

1150

940

60