


Mr. Cook:-

June 3, 1918.

DEPRESSION NORTH WEST CORNER
CHURCH AND HIGH STREET

Police Dept. reported this depression on April 29, 1918, it was referred to Foreman Watson District #1 who immediately cut out the asphalt and made temporary repair with bituminous material. It was about a foot and a half in diameter saucer shaped to a depth of about four inches according to Foreman's memory. He did not cut through the concrete base. It is within two or three feet of a Hfd.Elec.Lt.Co. manhole which may mean that the settlement was over some of their underground work. Permanent repairs have not yet been made. The temporary patch is still in place and in good safe condition. We have no other information.

(Signed) Leon F. Peck, Supt.

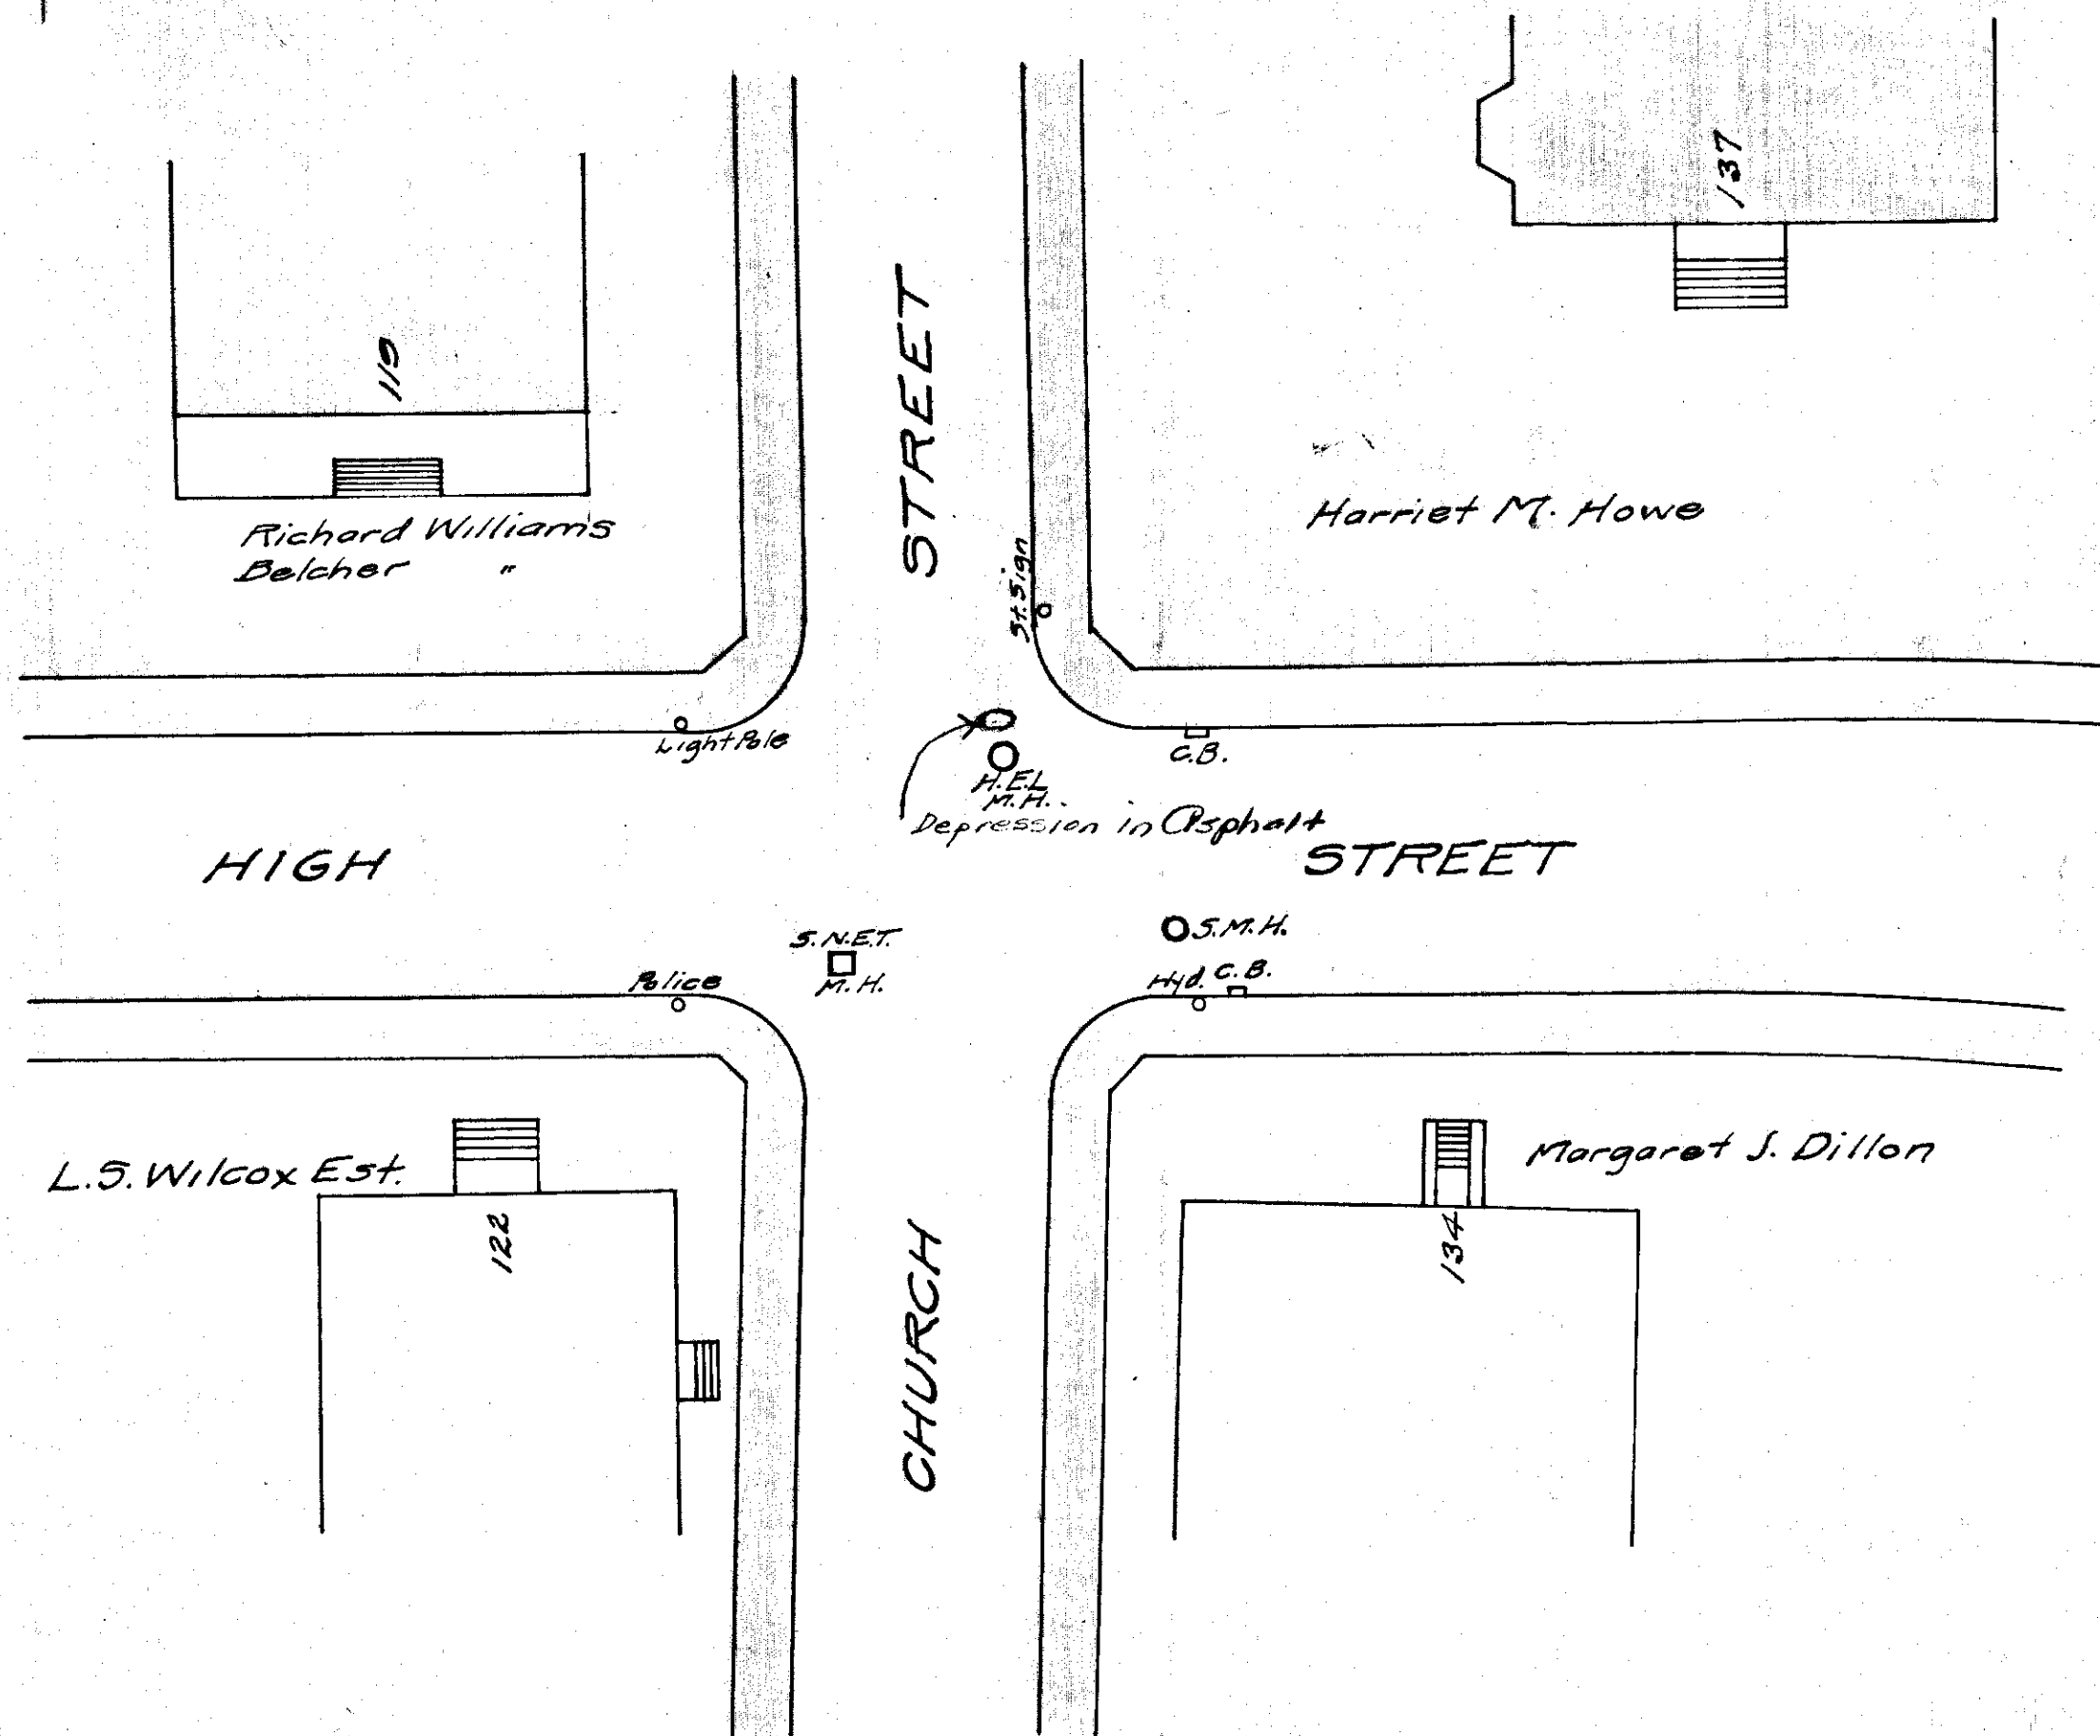

June 1918

04573

R.N.C.