


See profile 361
Pearl St to Jewell St

42
41
40
39
38
37
36
35

STREET
PEARL

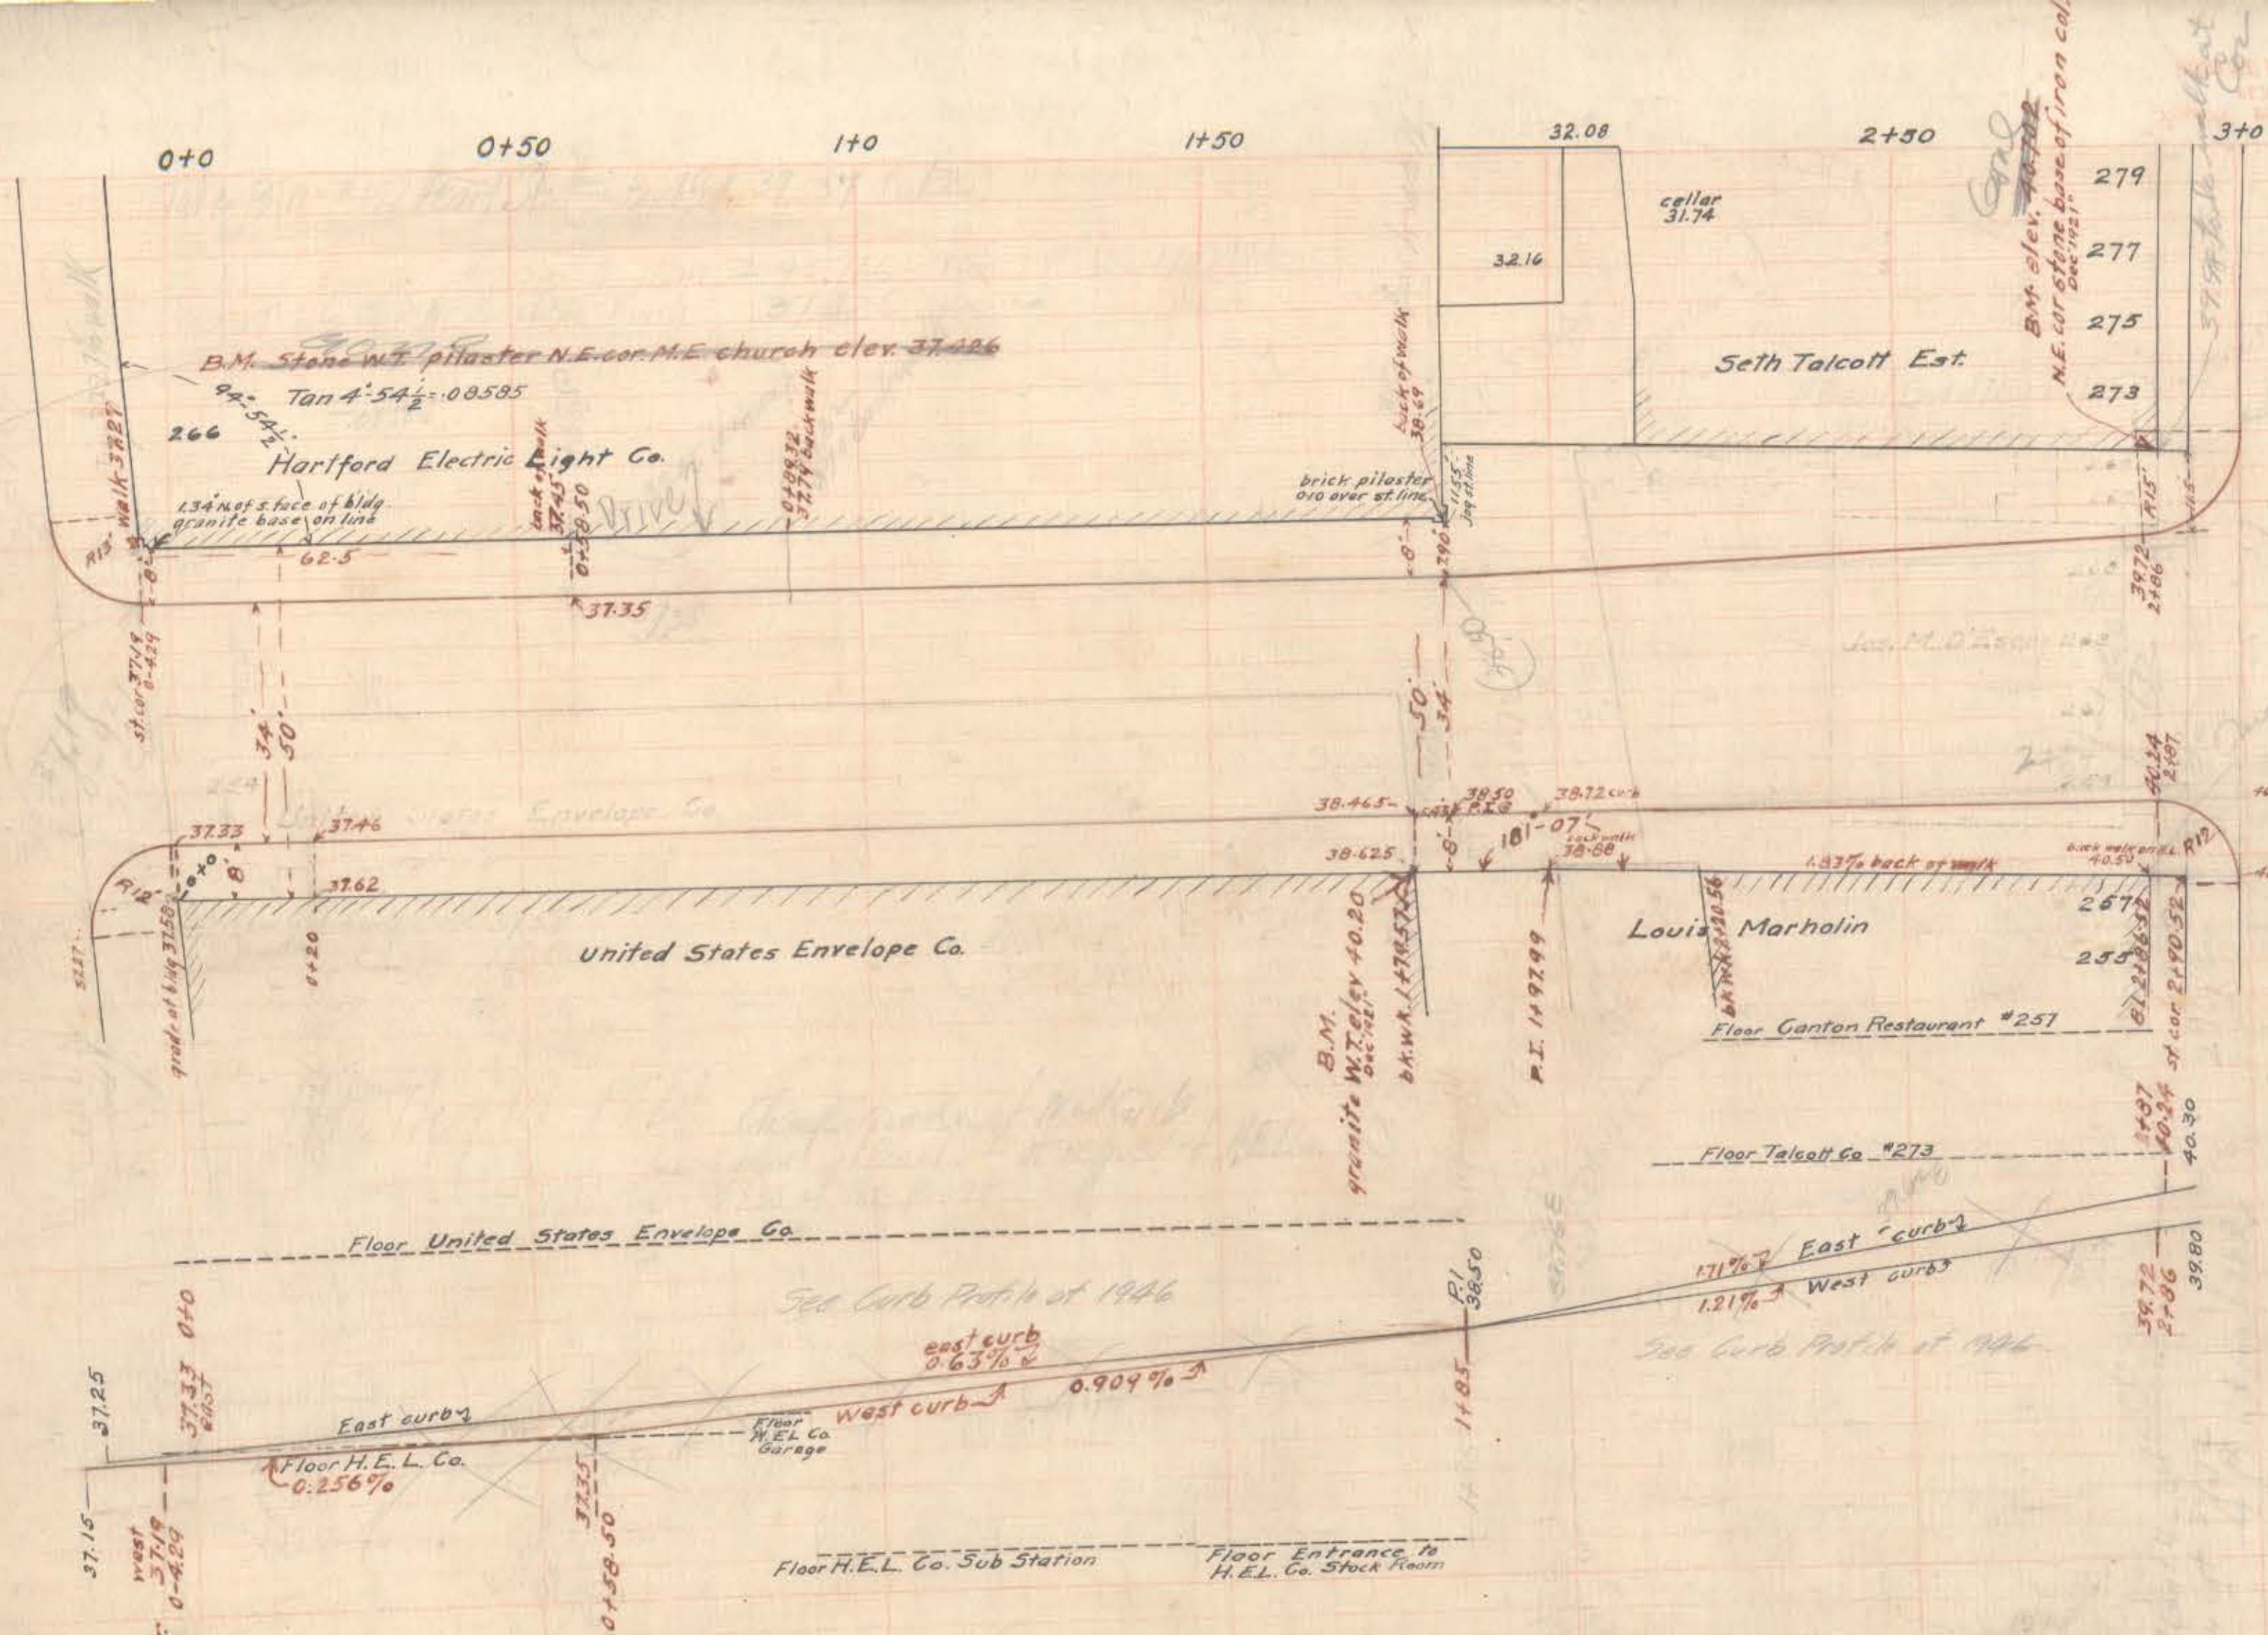

STREET
ASYLUM

ANN STREET

VERTICAL SCALE 1"=2'
HORIZONTAL SCALE 1"=20'