

4 3 2 1 0 0 1 2 3 4 5

90

80

70

90



80

70

90

80



70

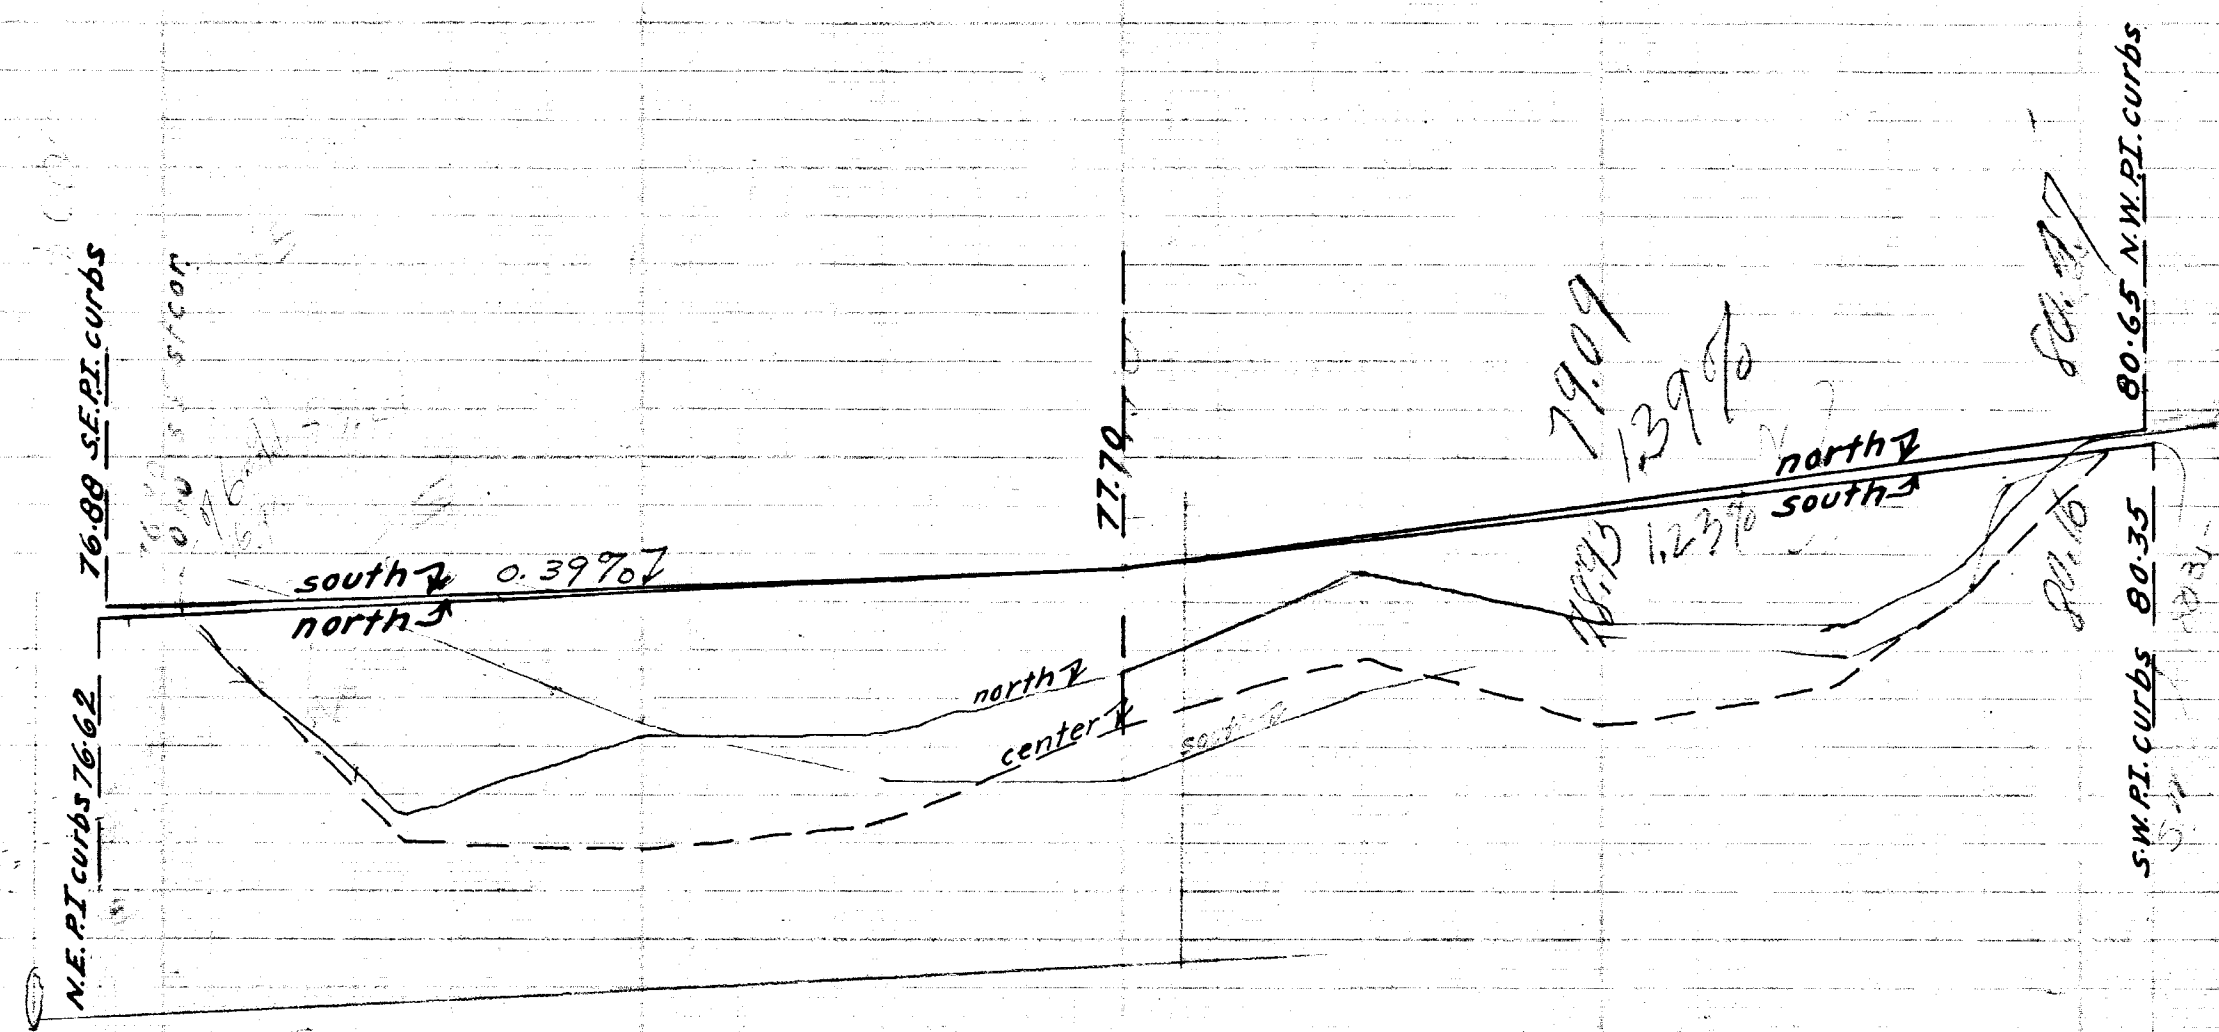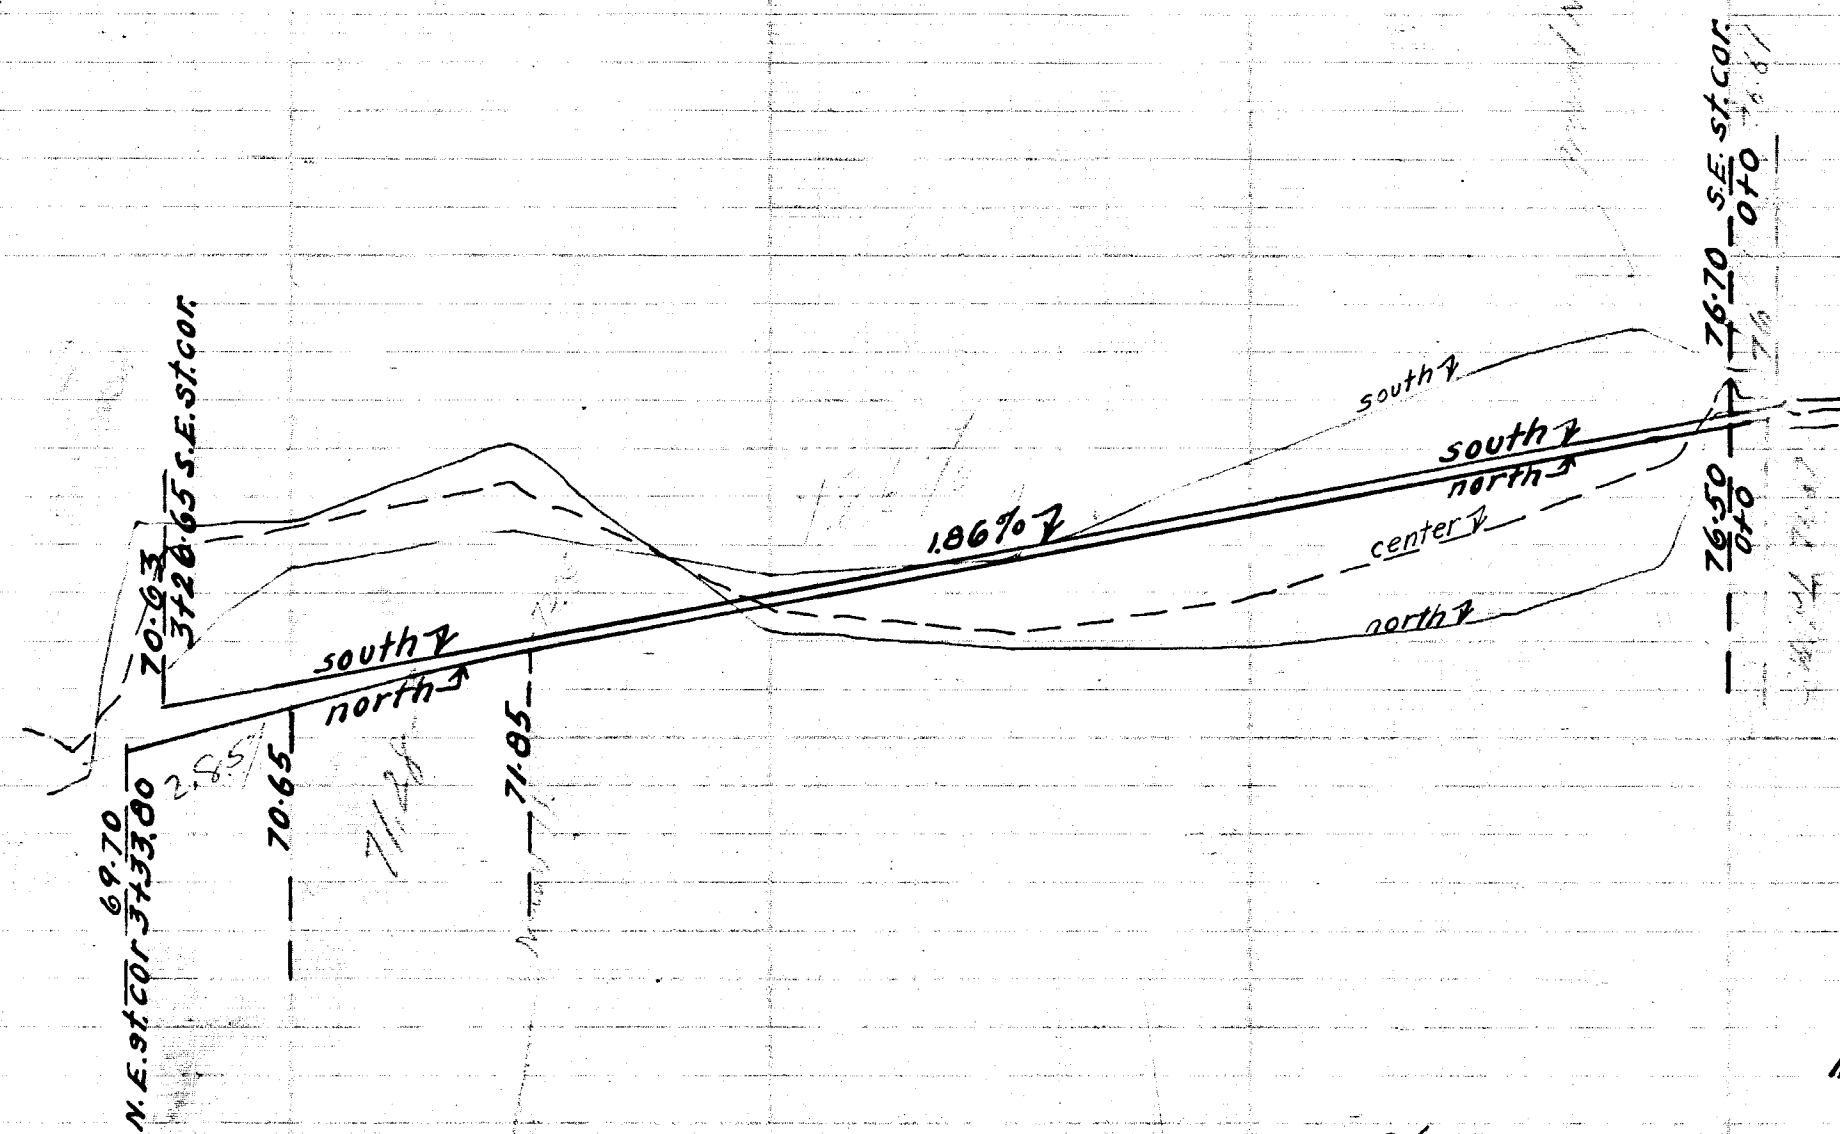

NELSON STREET

SCALE { HORIZ. 1" = 40'
VERT. 1" = 4'
April 1917

26
10
36

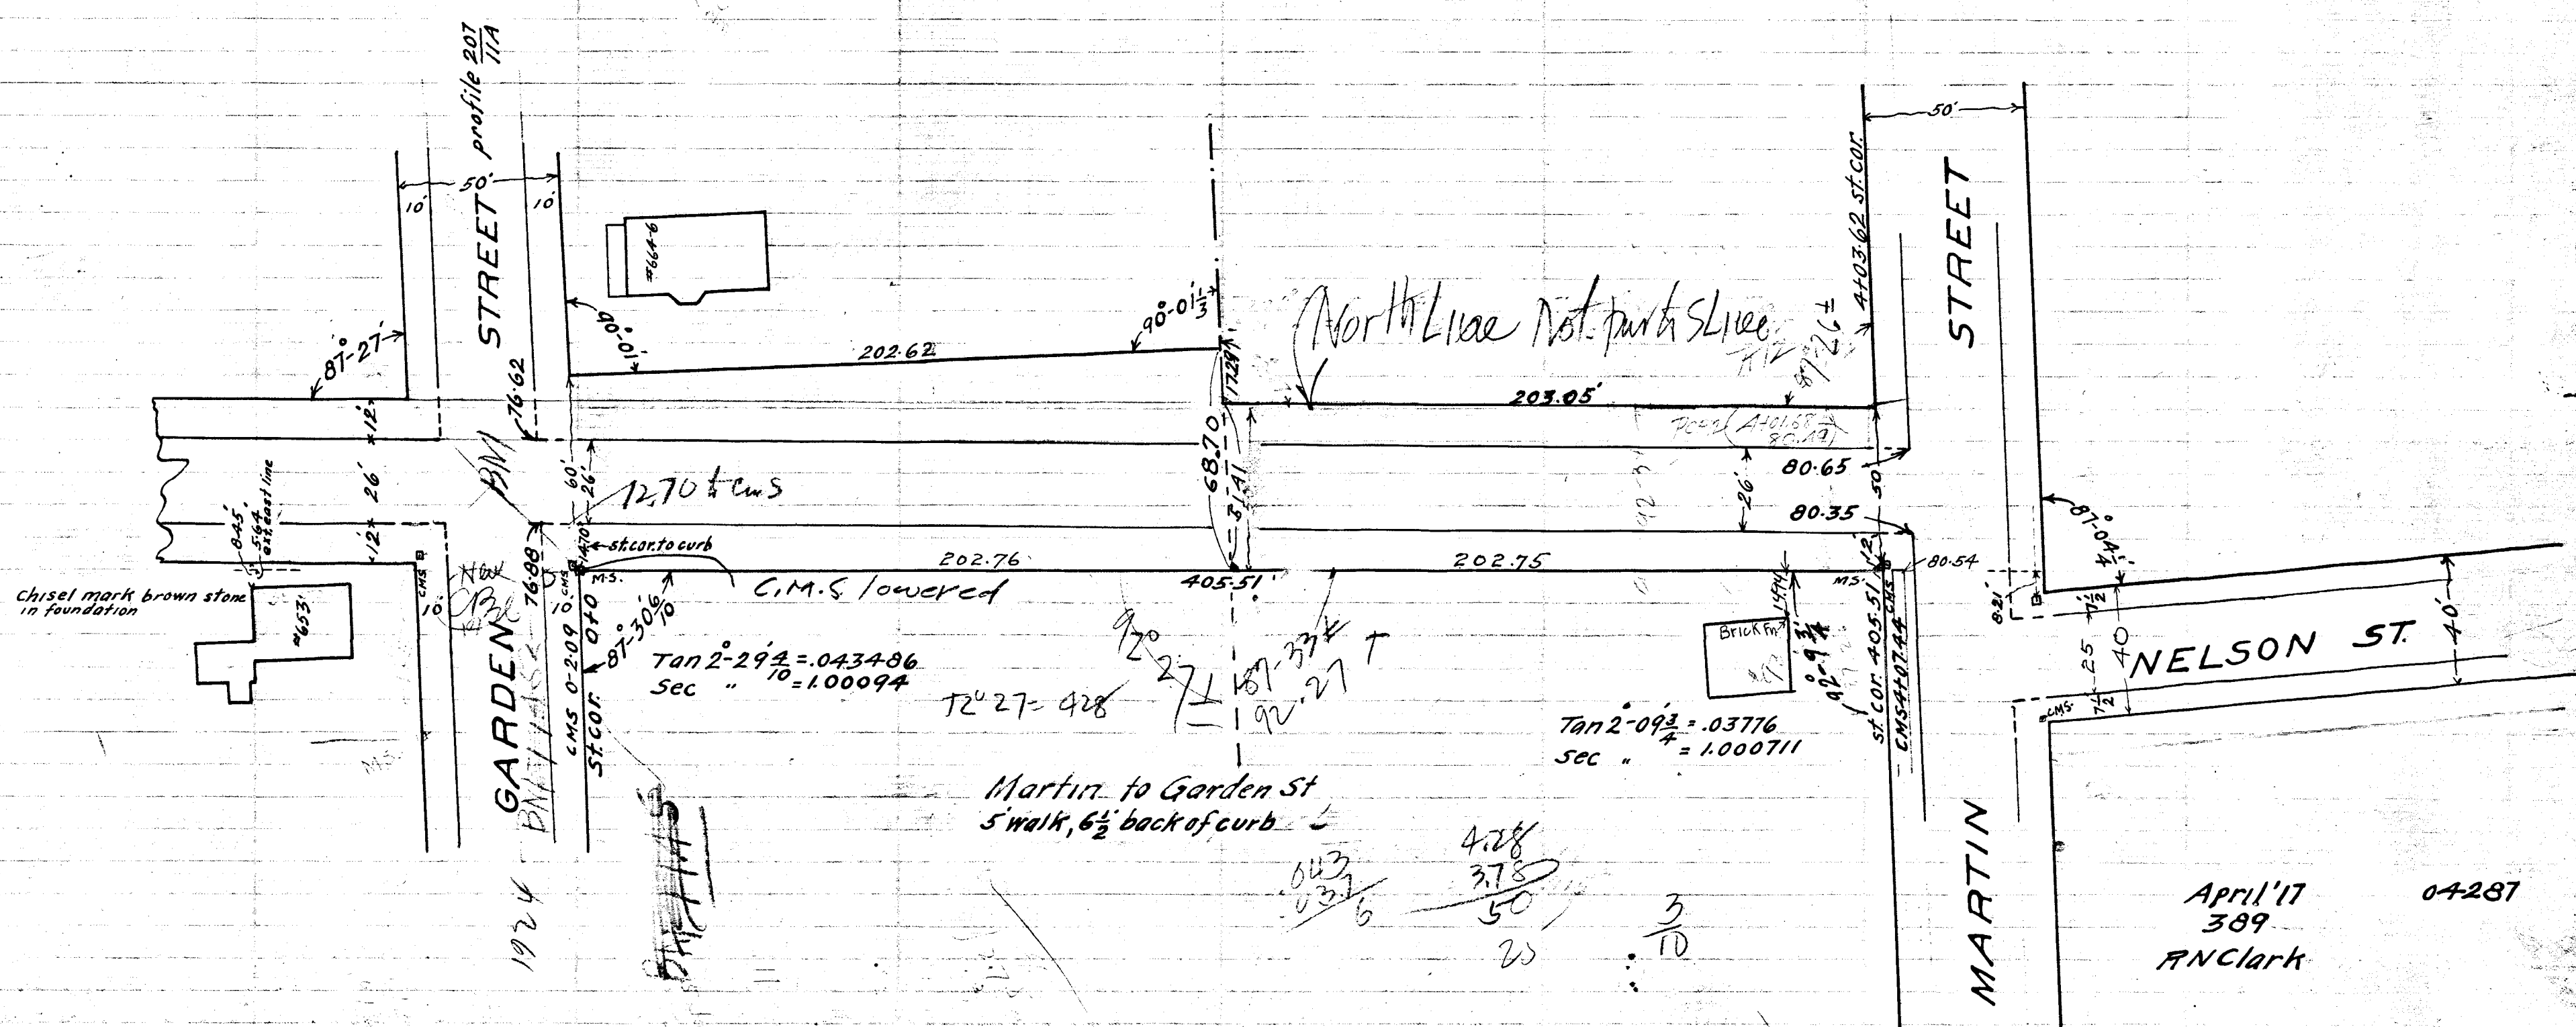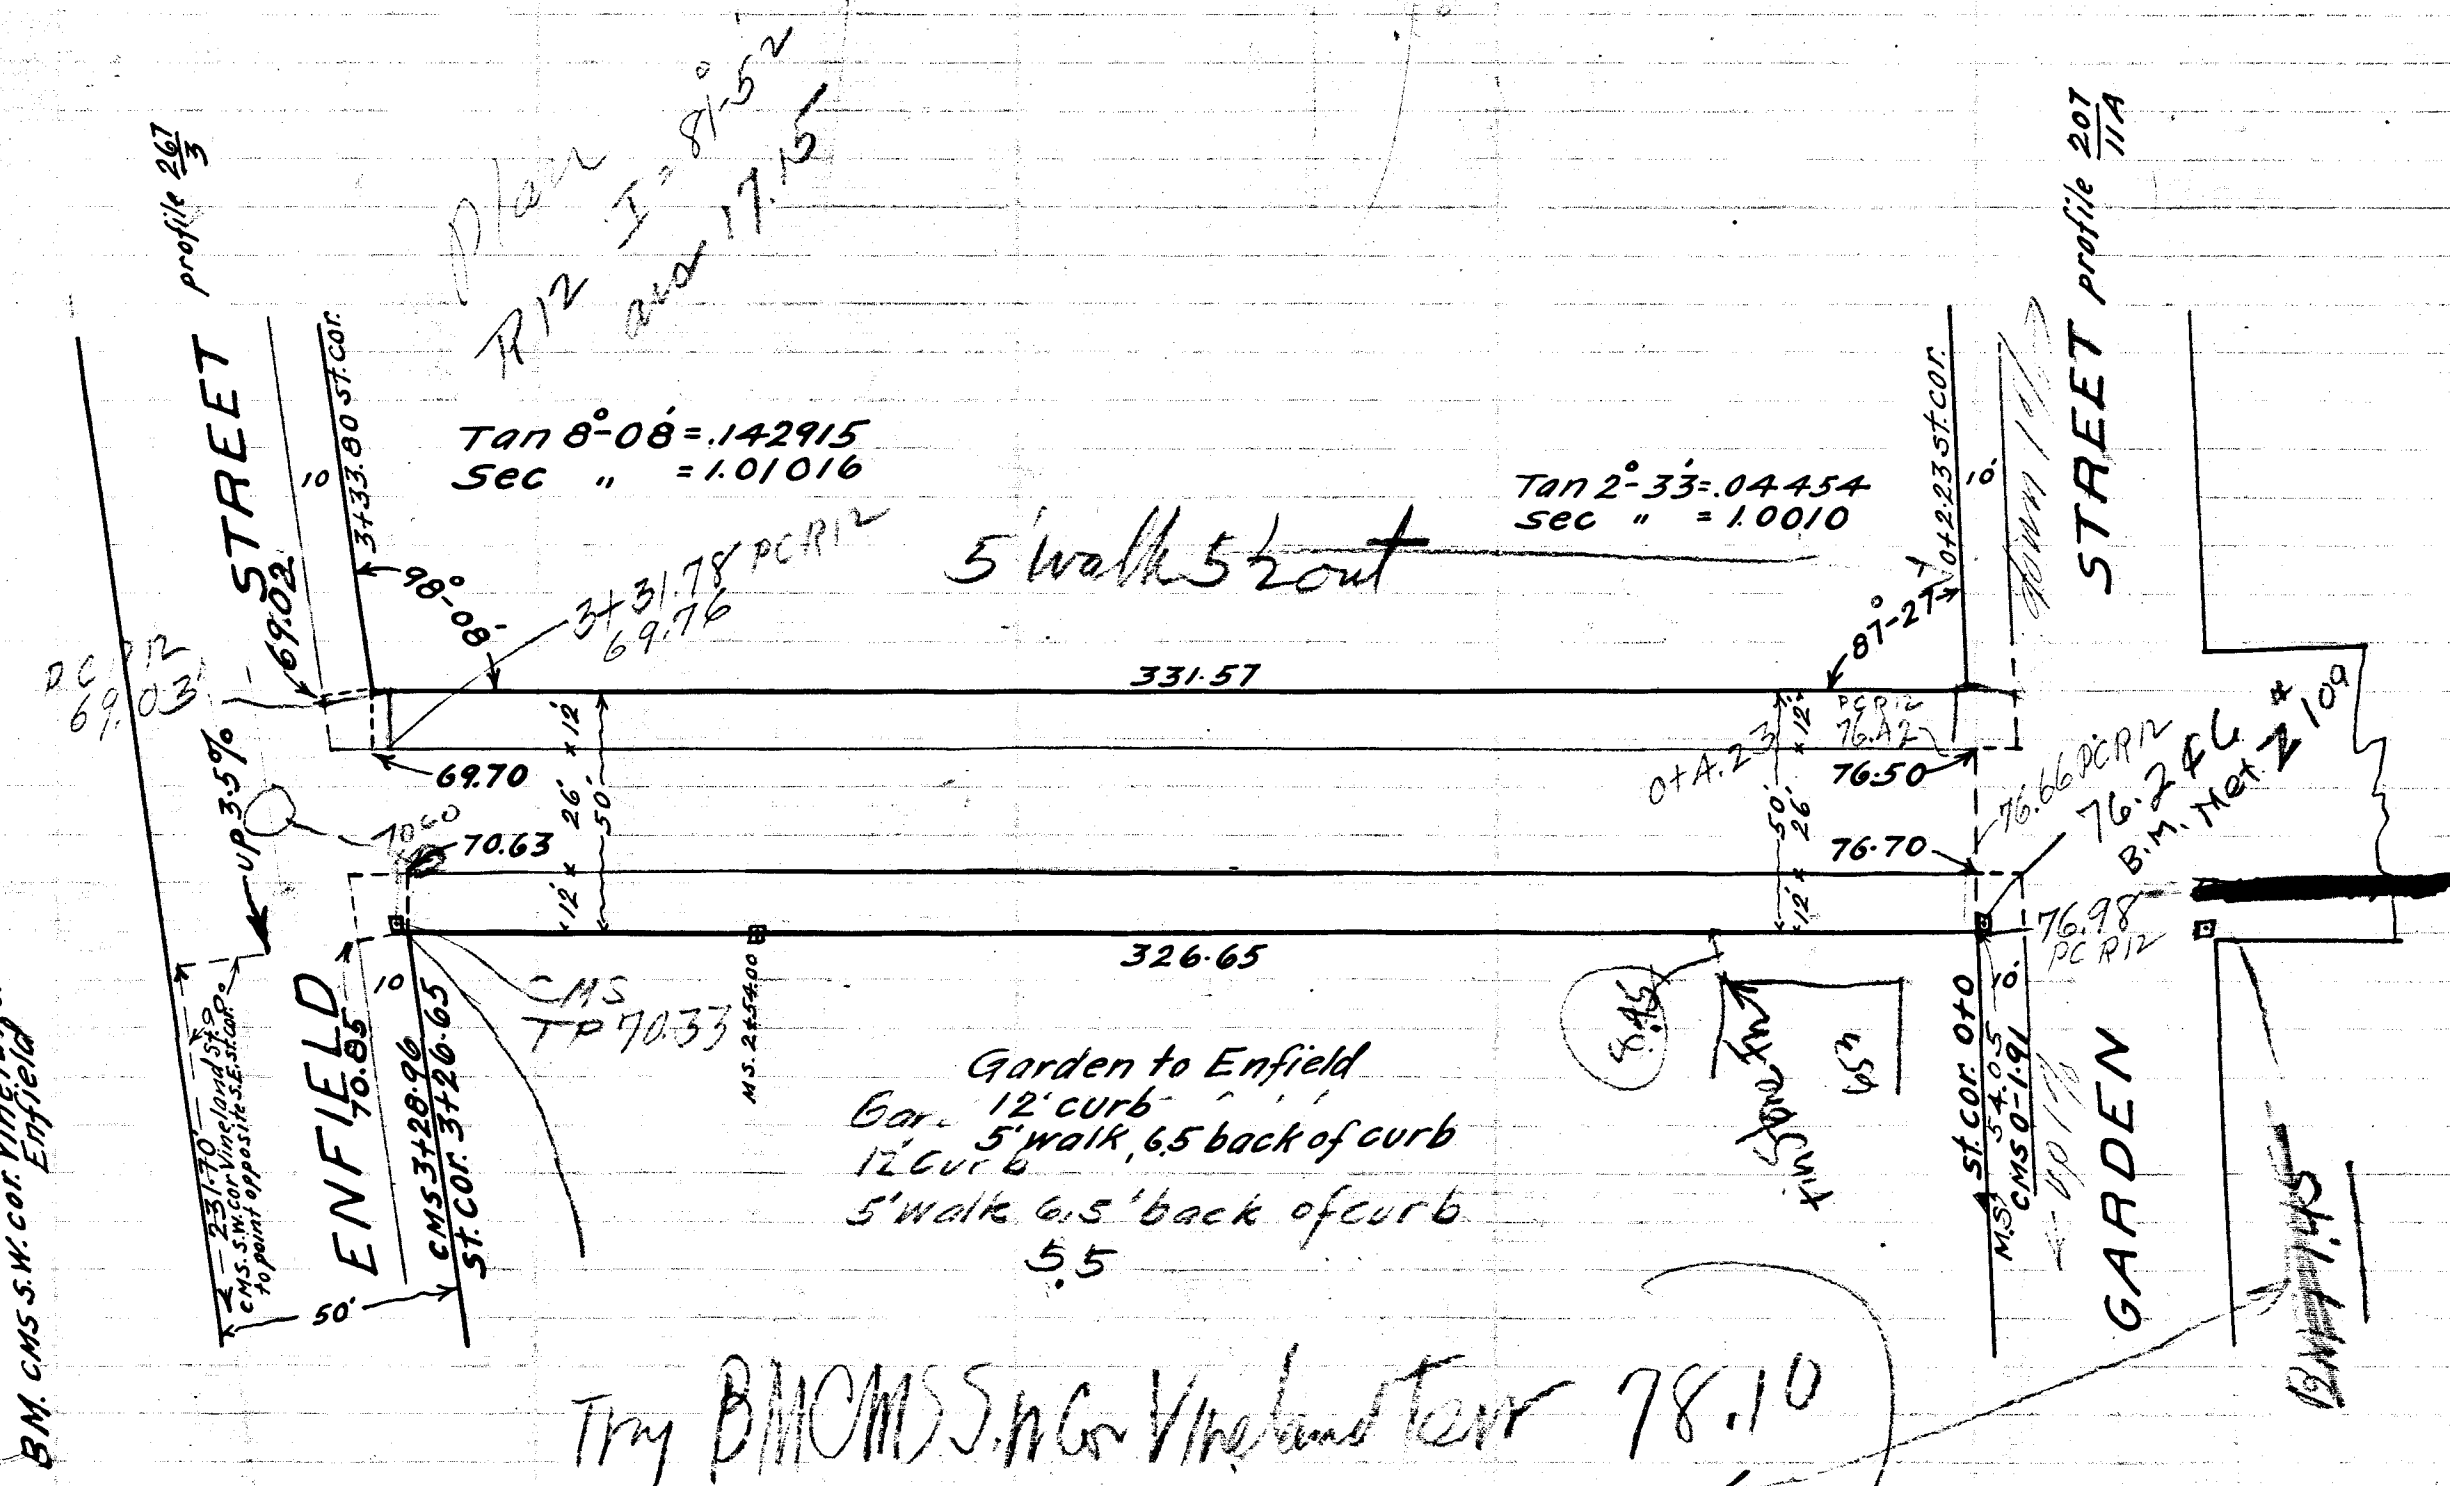

April '17
389
R.N. Clark
04287