


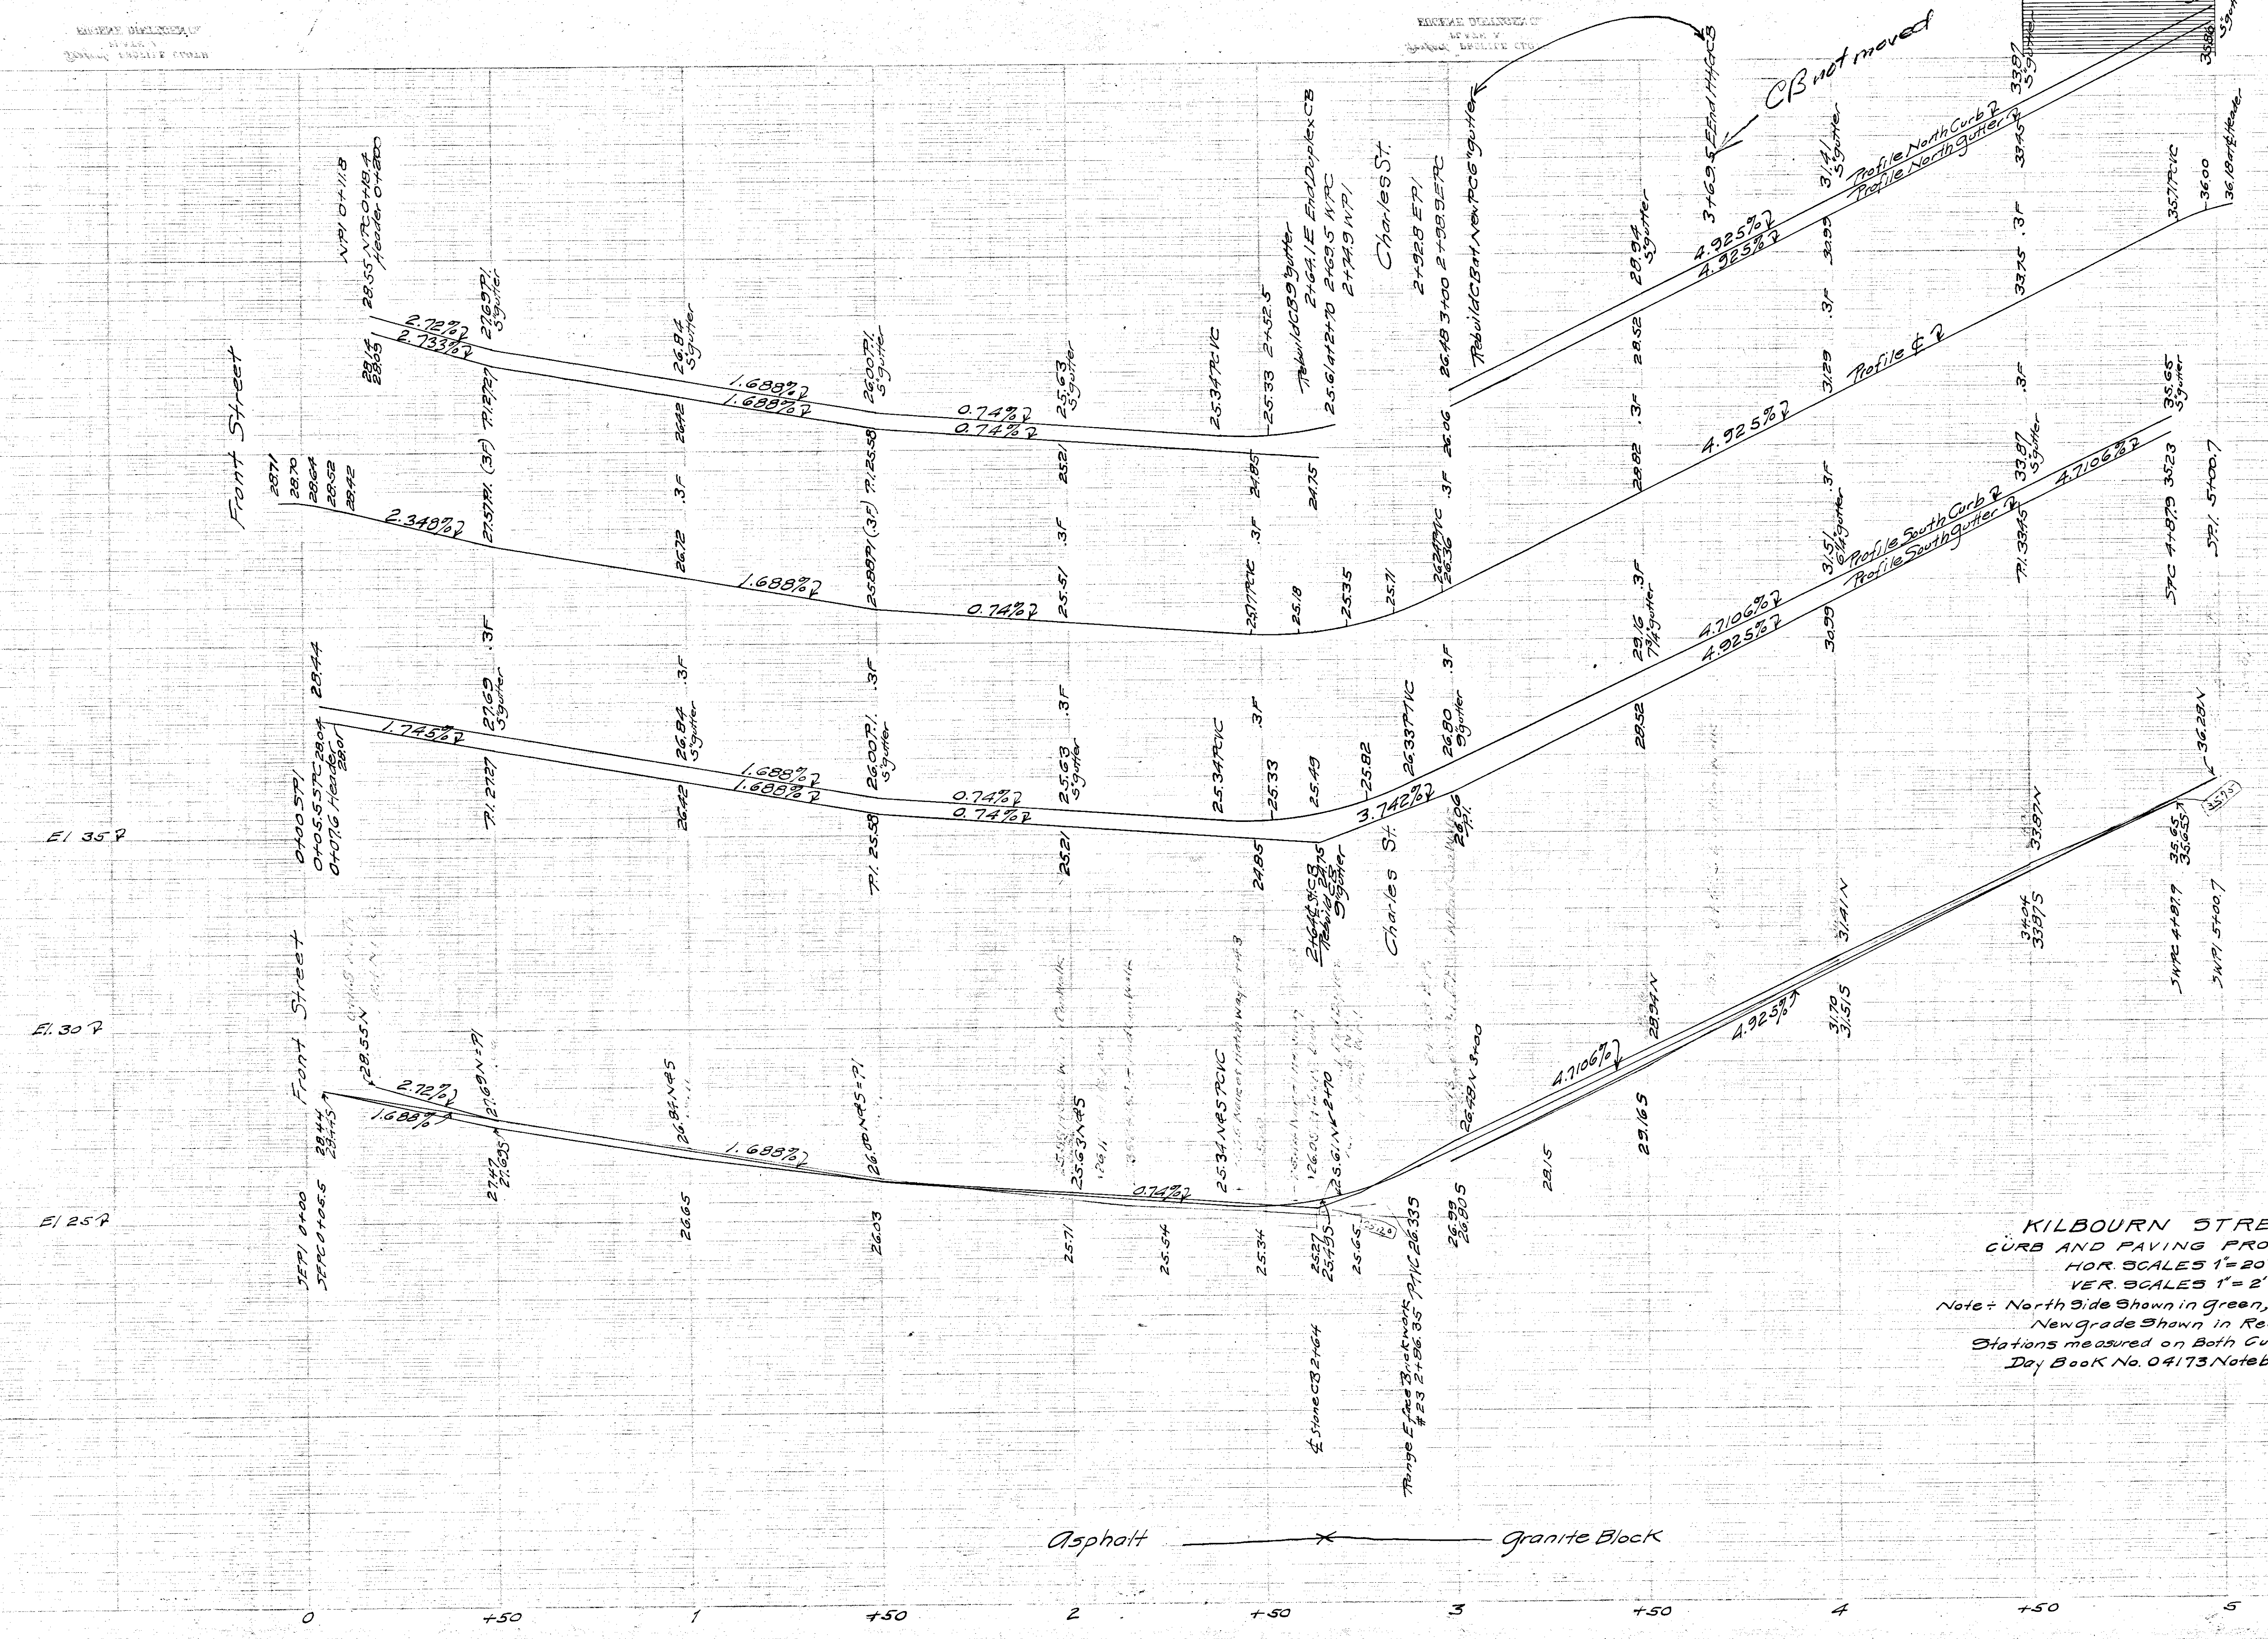

Estimated Amounts

Resetting curb & walk	.50
gr. Block	6.25
Asp	2.50

KILBOURN STREET
CURB AND PAVING PROFILES
 HOR. SCALES 1"=20'
 VER. SCALES 1"=2'
 Note: North Side Shown in Green, South in Black
 Newgrade Shown in Red
 Stations measured on Both Curb Lines
 Day Book No. 04173, Notebook K397

Department of Engineering
 Hartford Conn.
 Feb. 1917