
 


Diff 140
GB

140
GB

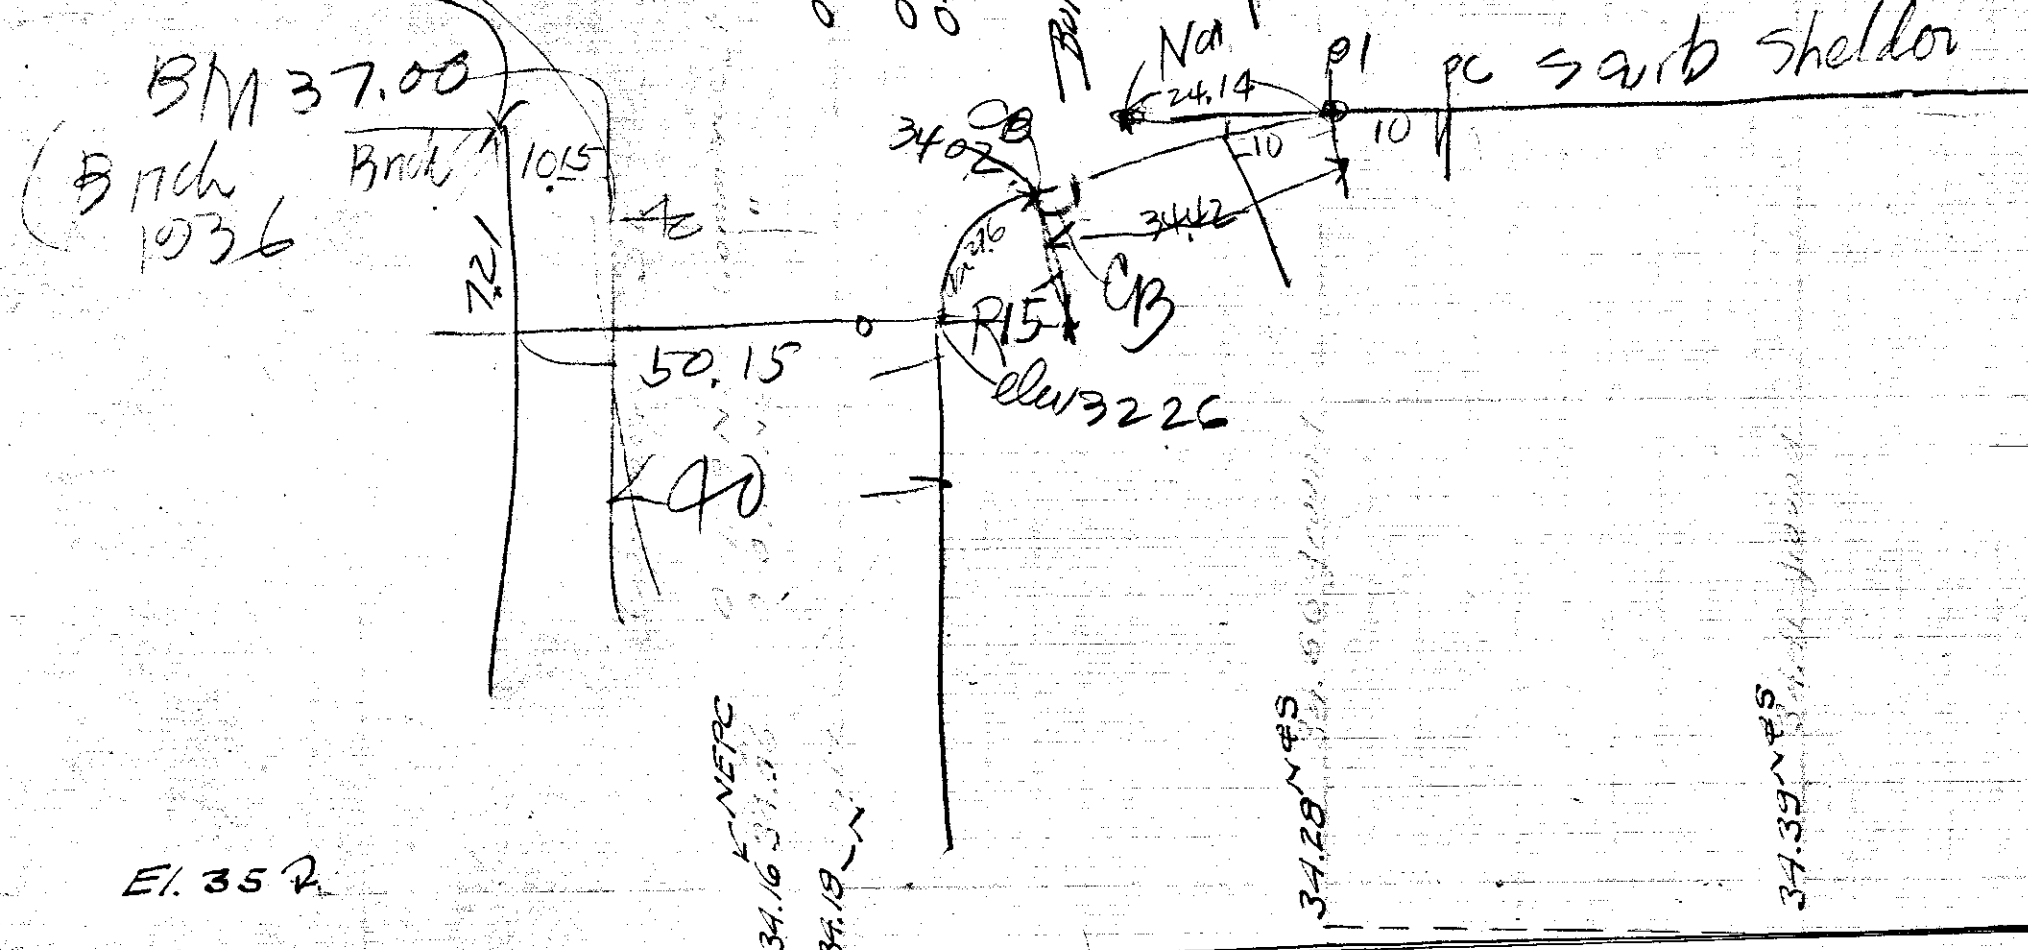

36.96 BM Granby W.T. 2 below Brk
SE of HELCO 4410 Sheldon
578
58

SHELDON STREET
TAYLOR STREET TO CHARTER OAK AVENUE
CURB AND PAVING PROFILES
HOR. SCALES 1"=20'
VER. SCALES 1"=2'
Note: North Side Shown in Green, South in Black
Vertical Curve in Red
Stations measured on South Curb Line
Day Book No. 04201 Notebook K447
Date of 1921 5K
P88
Department of Engineering
Hartford Conn.
Feb. 1921