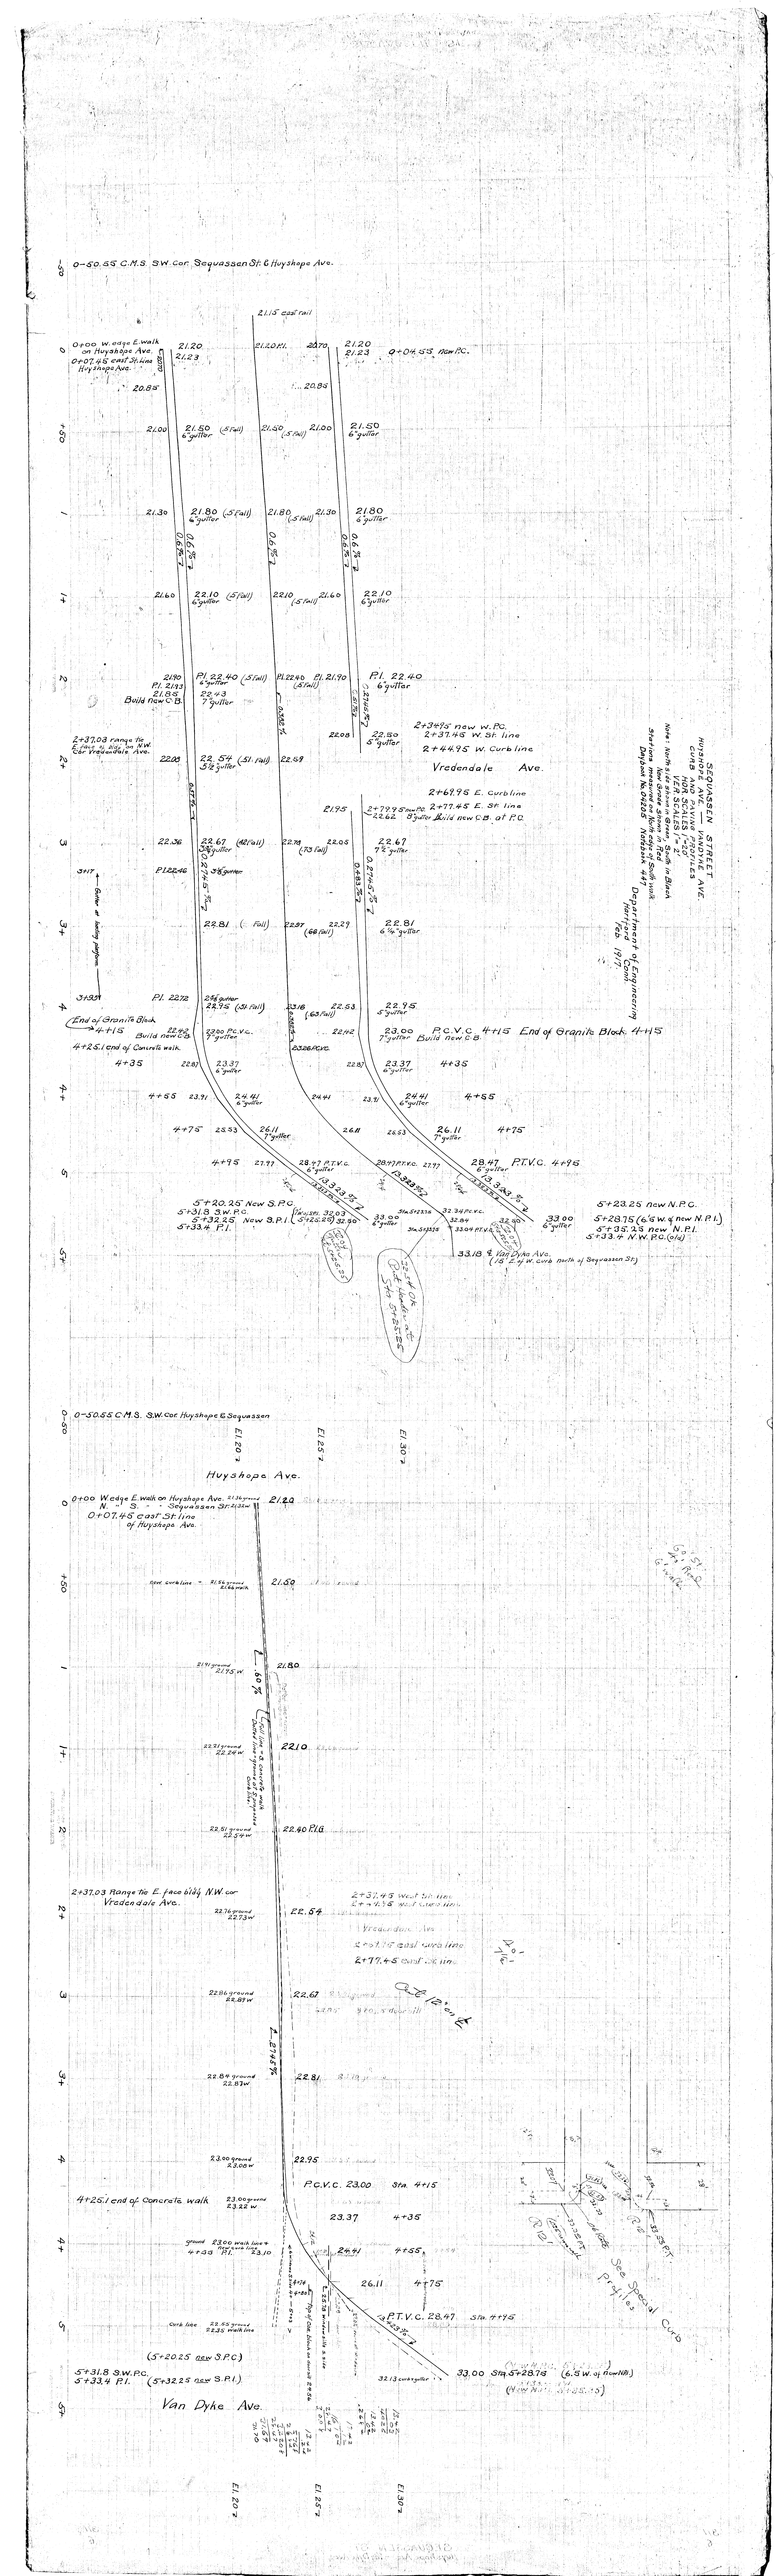
SEQUASSEN STREET
HUYSHOPE AVE.
CURB AND PAVING PROFILES
VER. SCALE 1" = 5'
HOR. SCALE 1" = 50'
New North Line shown in Green, South in Black
Stations measured on North side of South walk
Datum No. 94265 Notebook 44 Department of Engineering
1917
0-50.55 C.M.S. S.W. Cor. Sequassen St. & Huyshope Ave.
0+00 W. edge E. walk on Huyshope Ave.
0+07.45 east St. line Huyshope Ave.
21.15 east rail
0+04.55 new P.C.
2+37.03 range tie E. face bldg. on N.W. Cor. Vredendale Ave.
Vredendale Ave.
2+34.95 new W. P.C.
2+37.45 W. St. line
2+44.95 W. Curb line
2+67.95 E. Curb line
2+79.95 new P.C.
2+77.45 E. St. line
Build new C.B.
End of Granite Block 4+15
4+25.1 end of Concrete walk
Build new C.B.
P.C.V.C. 4+15 End of Granite Block 4+15
P.T.V.C. 4+95
5+20.25 New S.P.C.
5+31.8 S.W. P.C.
5+32.25 New S.P.I.
5+33.4 P.I.
5+23.25 new N.P.C.
5+28.75 (6.5' W. of new N.P.I.)
5+35.25 new N.P.I.
5+33.4 N.W. P.C. (6')
33.18 % Van Dyke Ave. (18' E. of W. Curb north of Sequassen St.)
0-50.55 C.M.S. S.W. Cor. Huyshope & Sequassen
Huyshope Ave.
0+00 Wedge E. walk on Huyshope Ave. N. of Sequassen St. line
0+07.45 east St. line of Huyshope Ave.
2+37.03 Range tie E. face bldg. N.W. cor. Vredendale Ave.
2+37.43 West St. line
2+44.95 West Curb line
Vredendale Ave.
2+67.95 east Curb line
2+77.45 East St. line
4+25.1 end of Concrete walk
P.C.V.C. 23.00 Sta. 4+15
P.T.V.C. 28.47 Sta. 4+95
See Special Curb
(5+20.25 new S.P.C.)
5+31.8 S.W. P.C.
5+33.4 P.I.
(5+32.25 new S.P.I.)
33.00 Sta. 5+28.75 (6.5' W. of new N.P.I.)
Van Dyke Ave.