
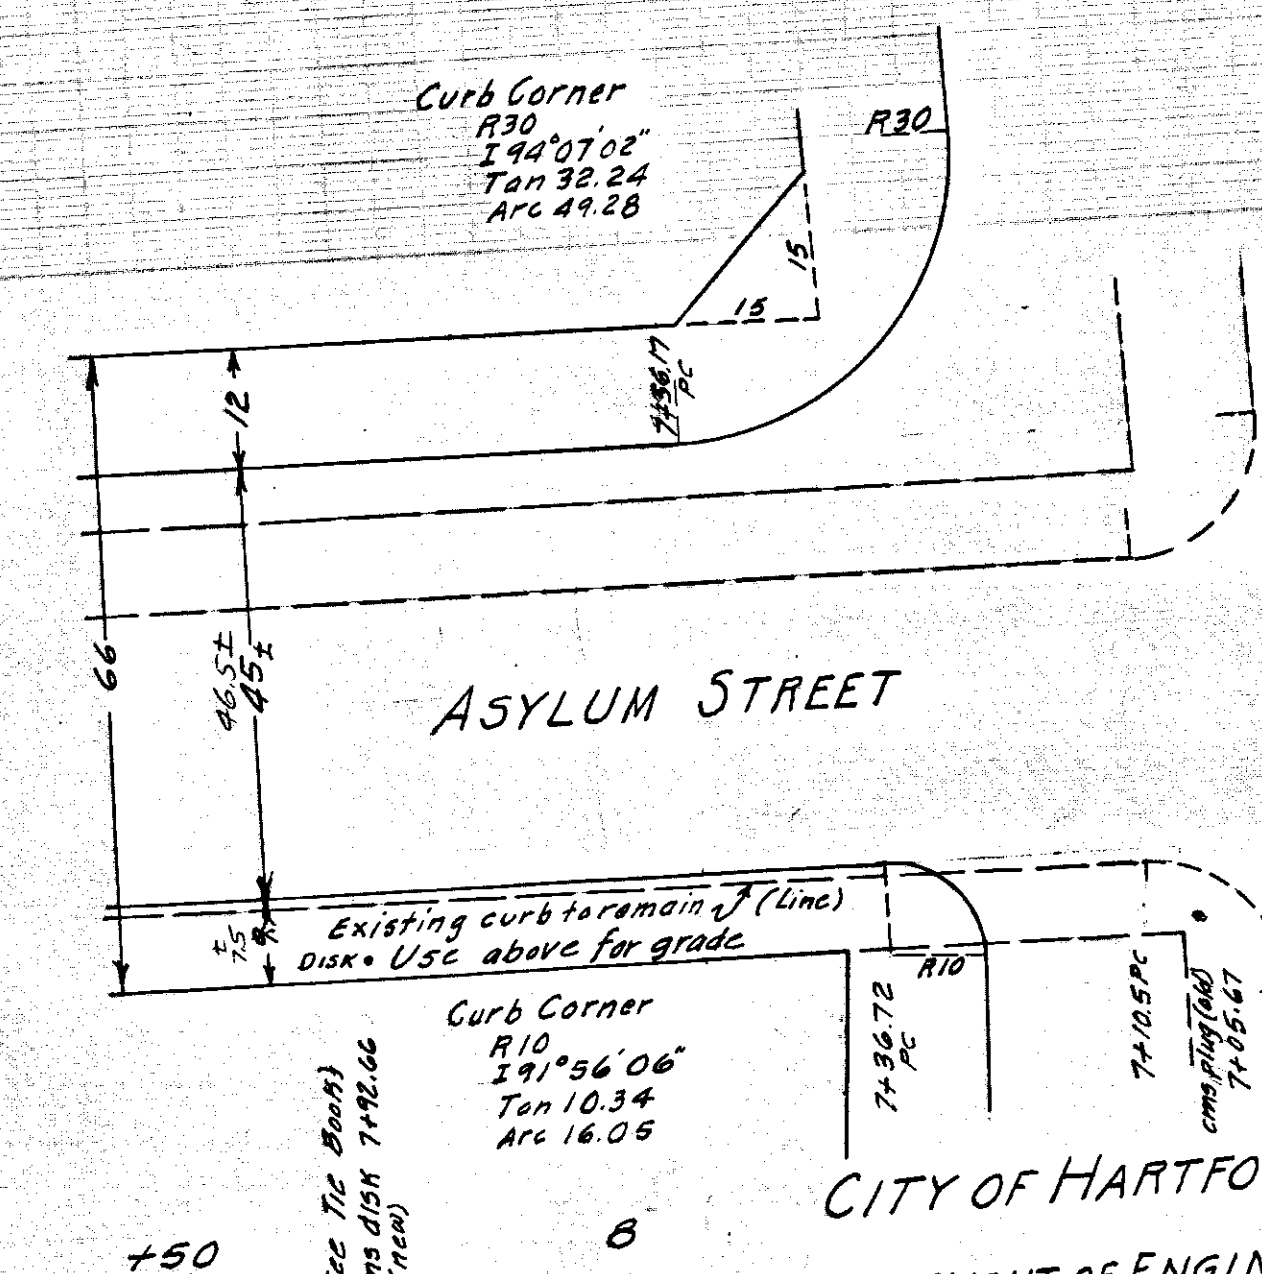
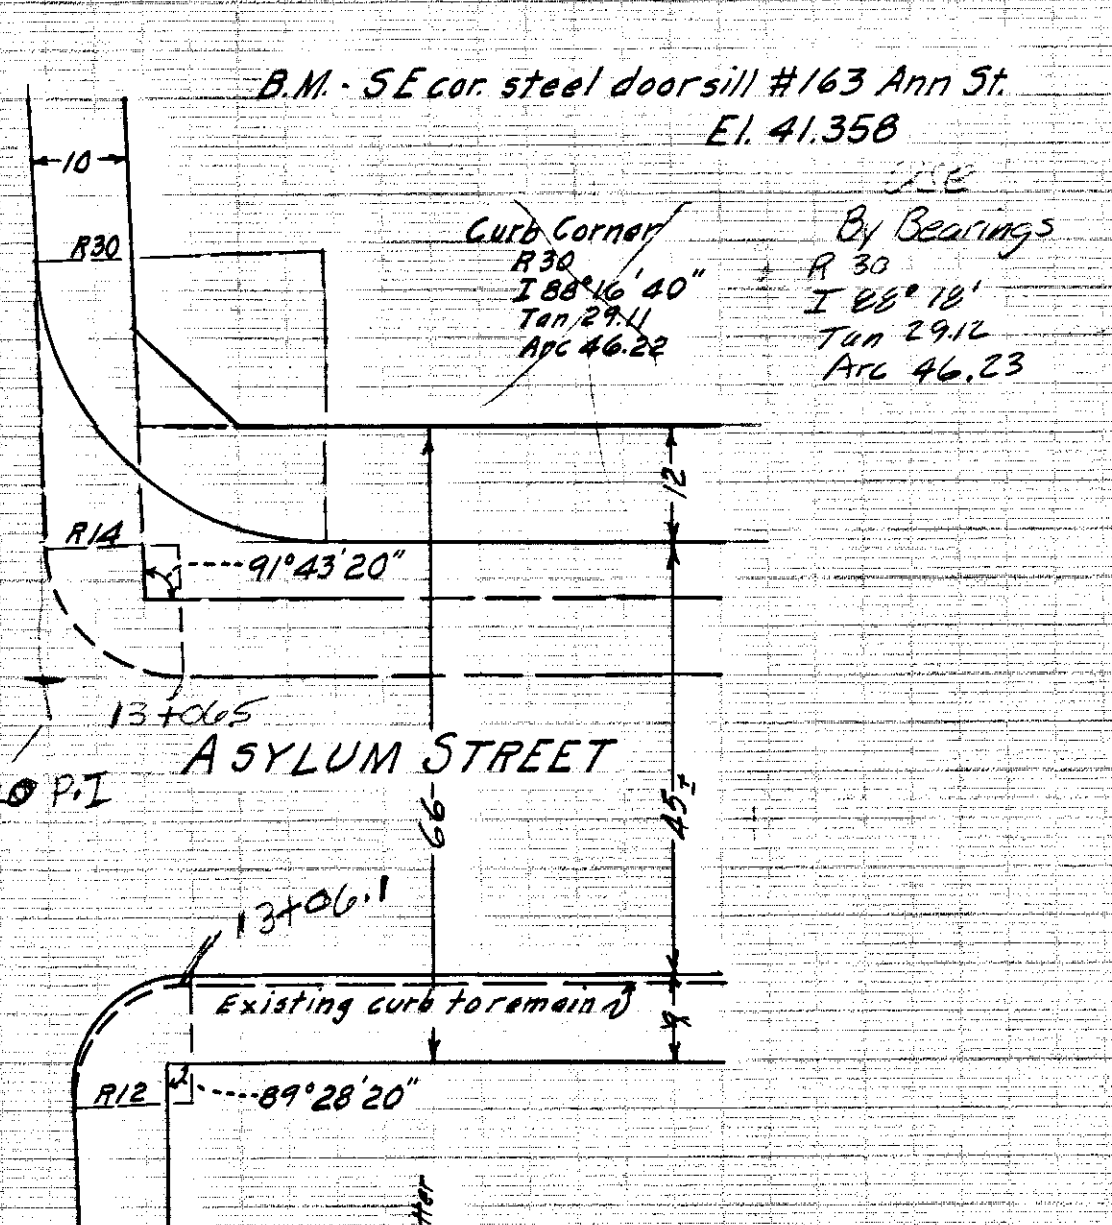




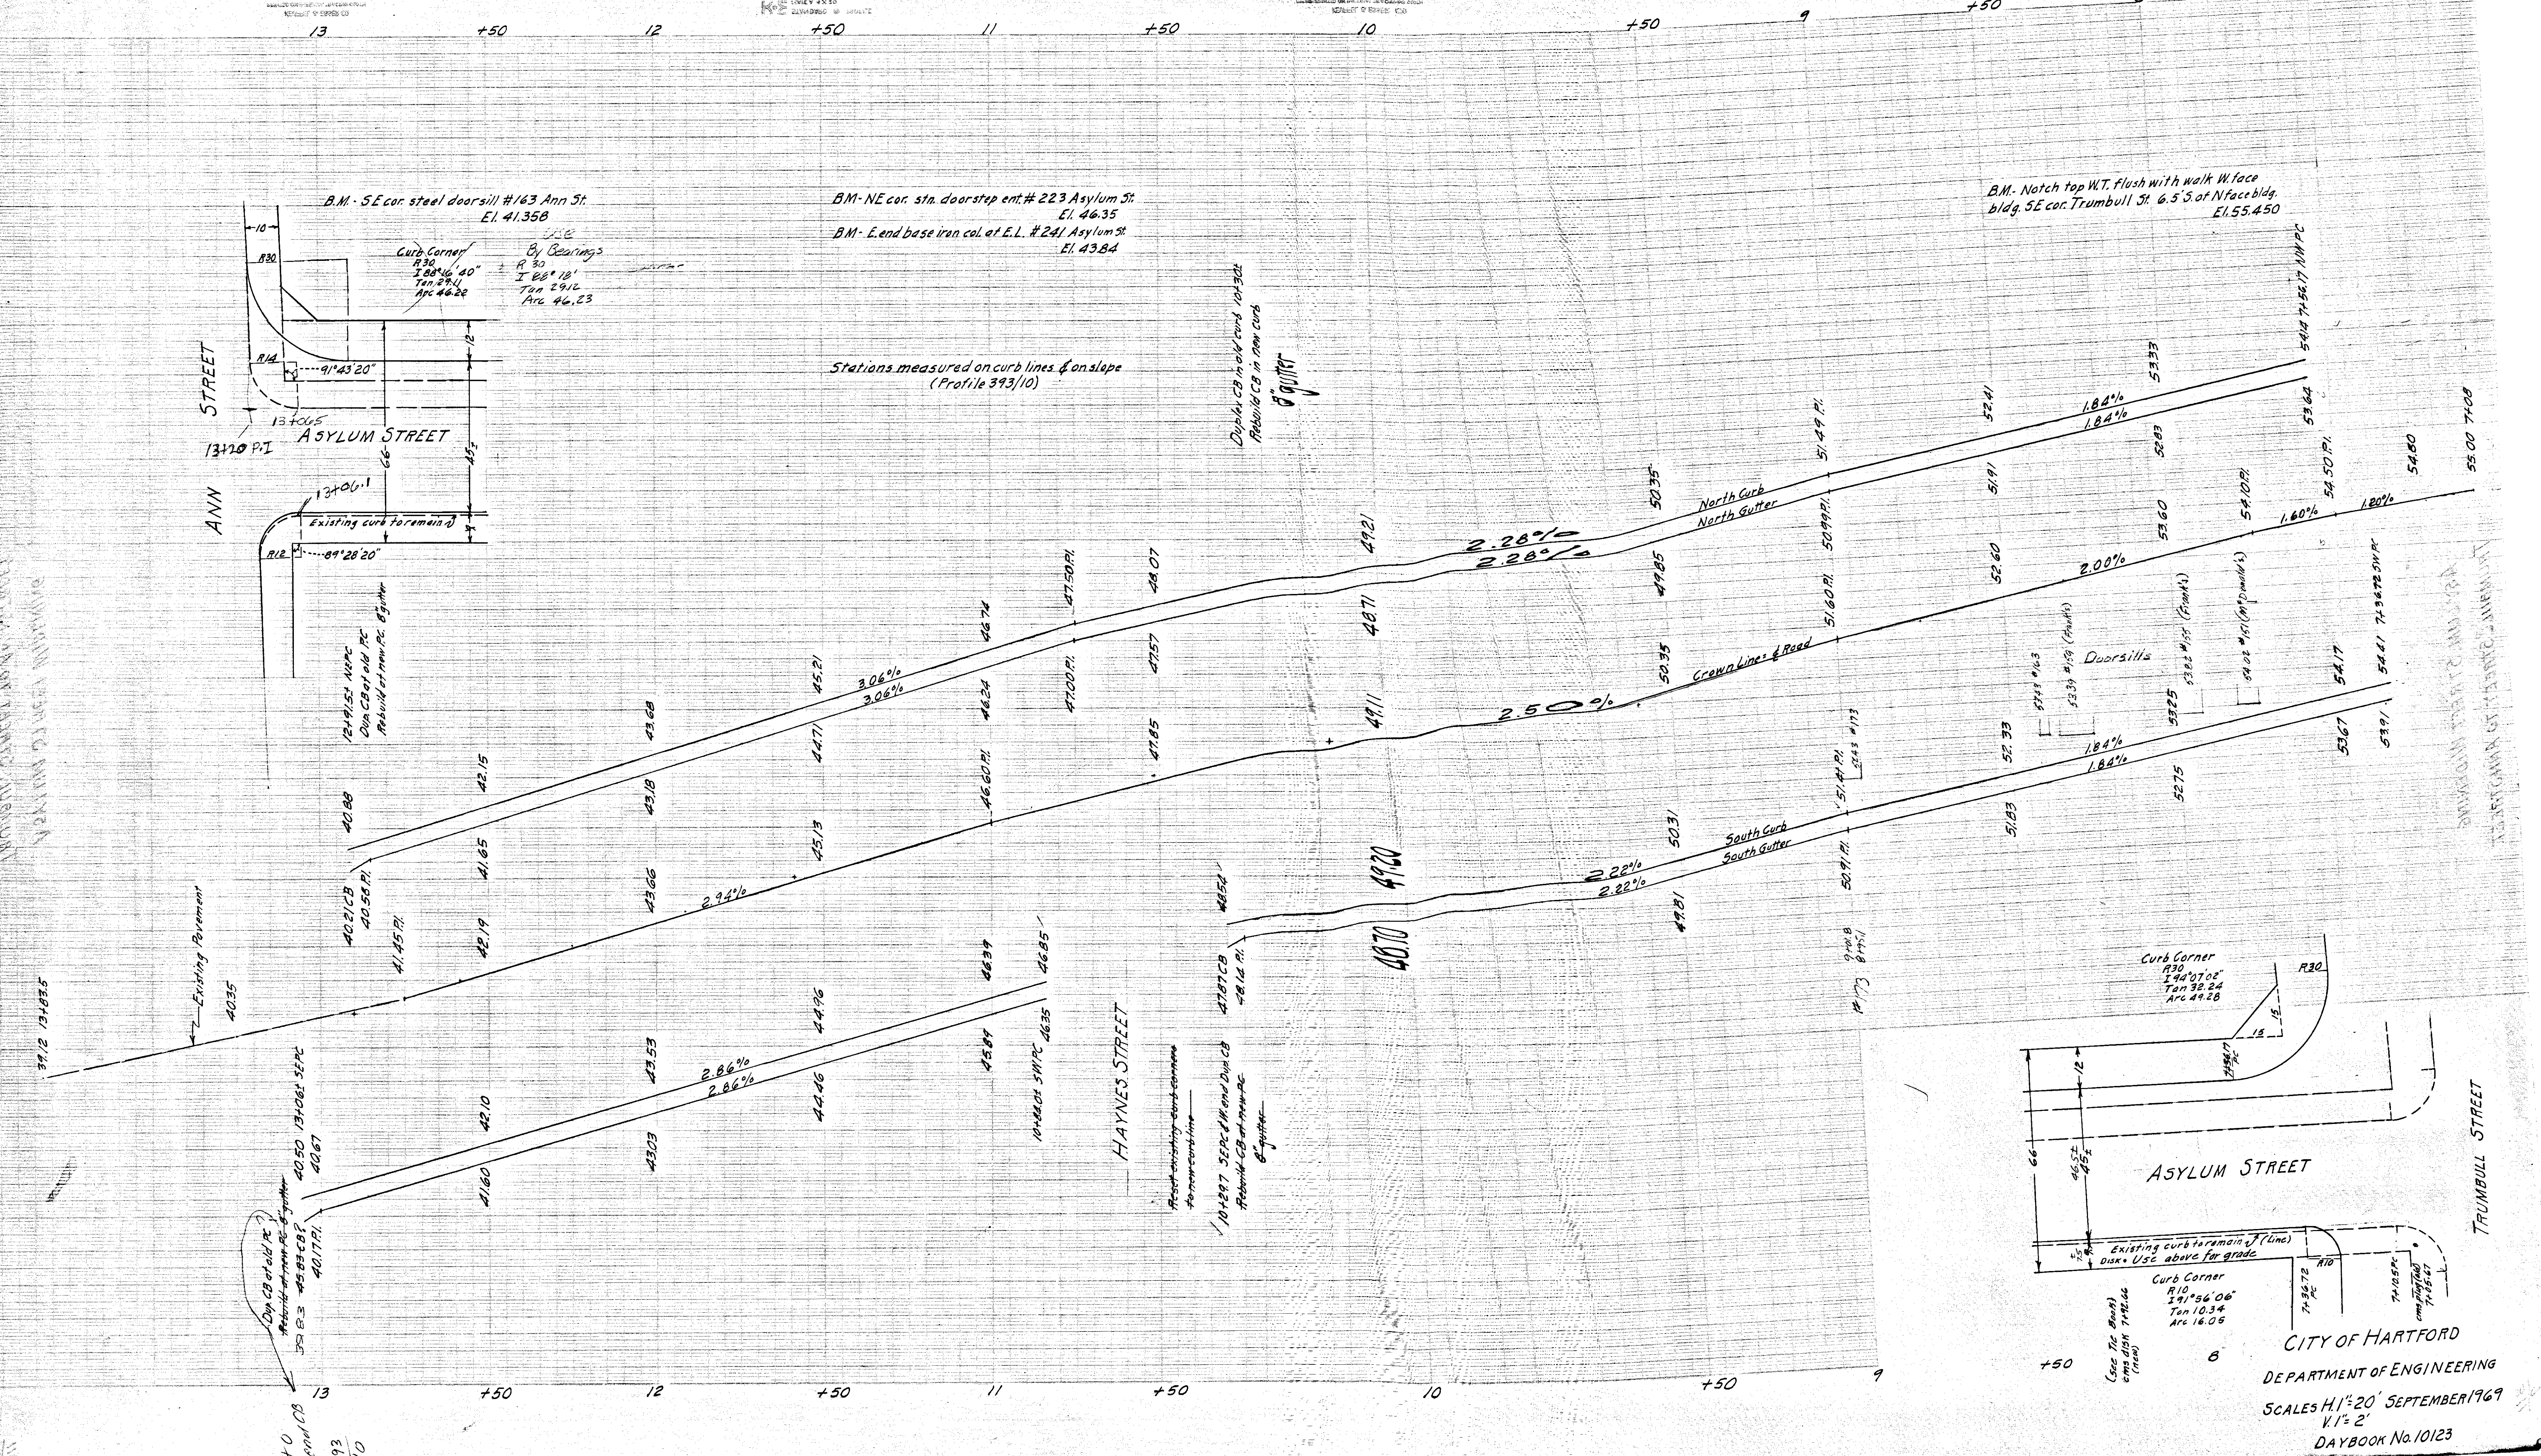

CITY OF HARTFORD
DEPARTMENT OF ENGINEERING
SCALE H. 1" = 20' V. 1" = 2'
SEPTEMBER 1967
DAYBOOK No. 10123