CHAPEL STREET
CURB PROFILE
HOR. SCALE 1"=20'
VER. SCALE 1"=2'
Note: North side shown in Green, South in Black
New grade shown in Red
Stations measured on South Curb line
Day book No. 04208 Note book 417
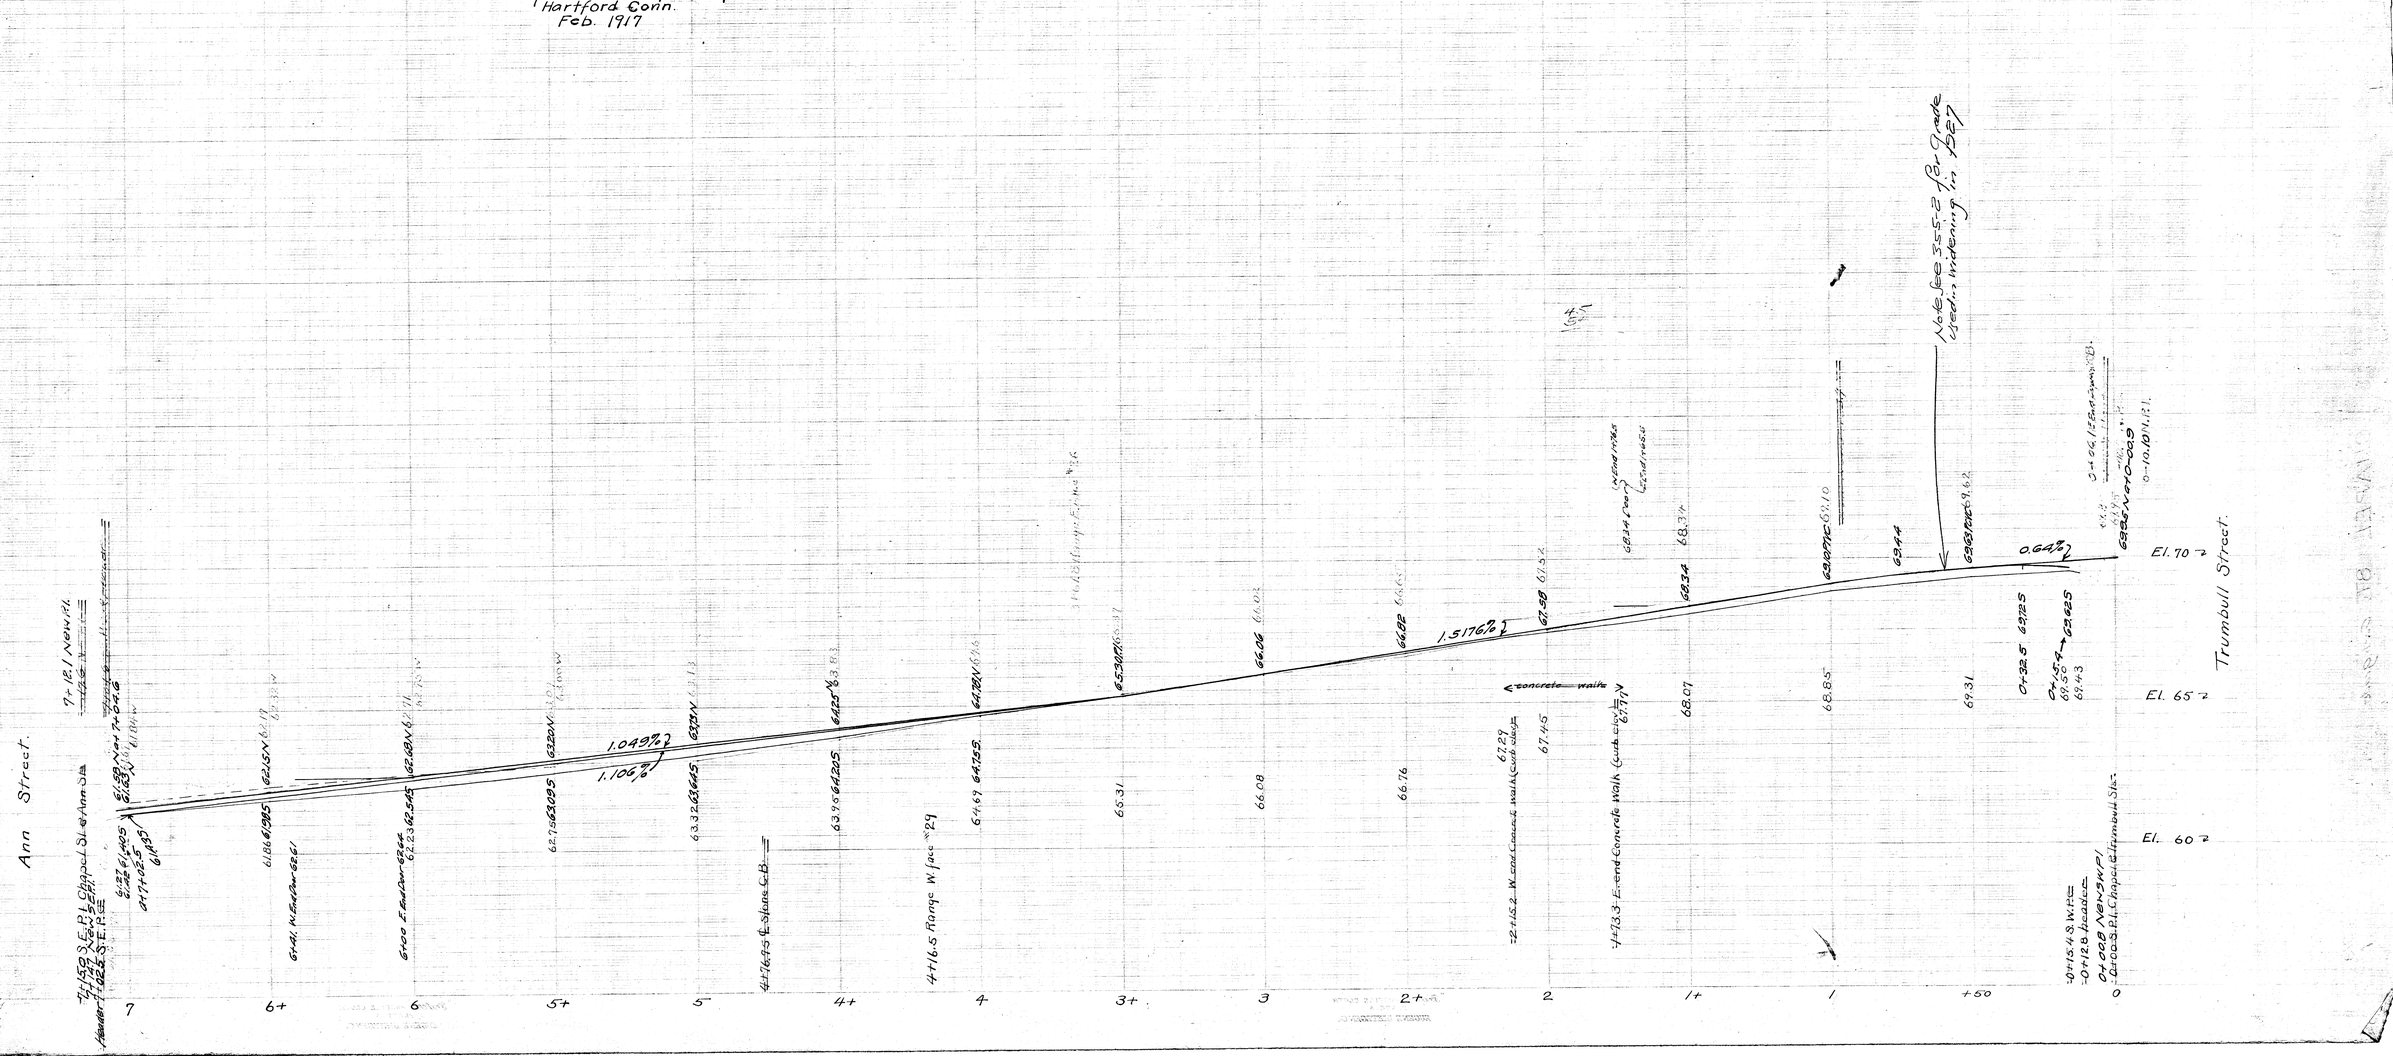
Department of Engineering
Hartford Conn.
Feb. 1917