



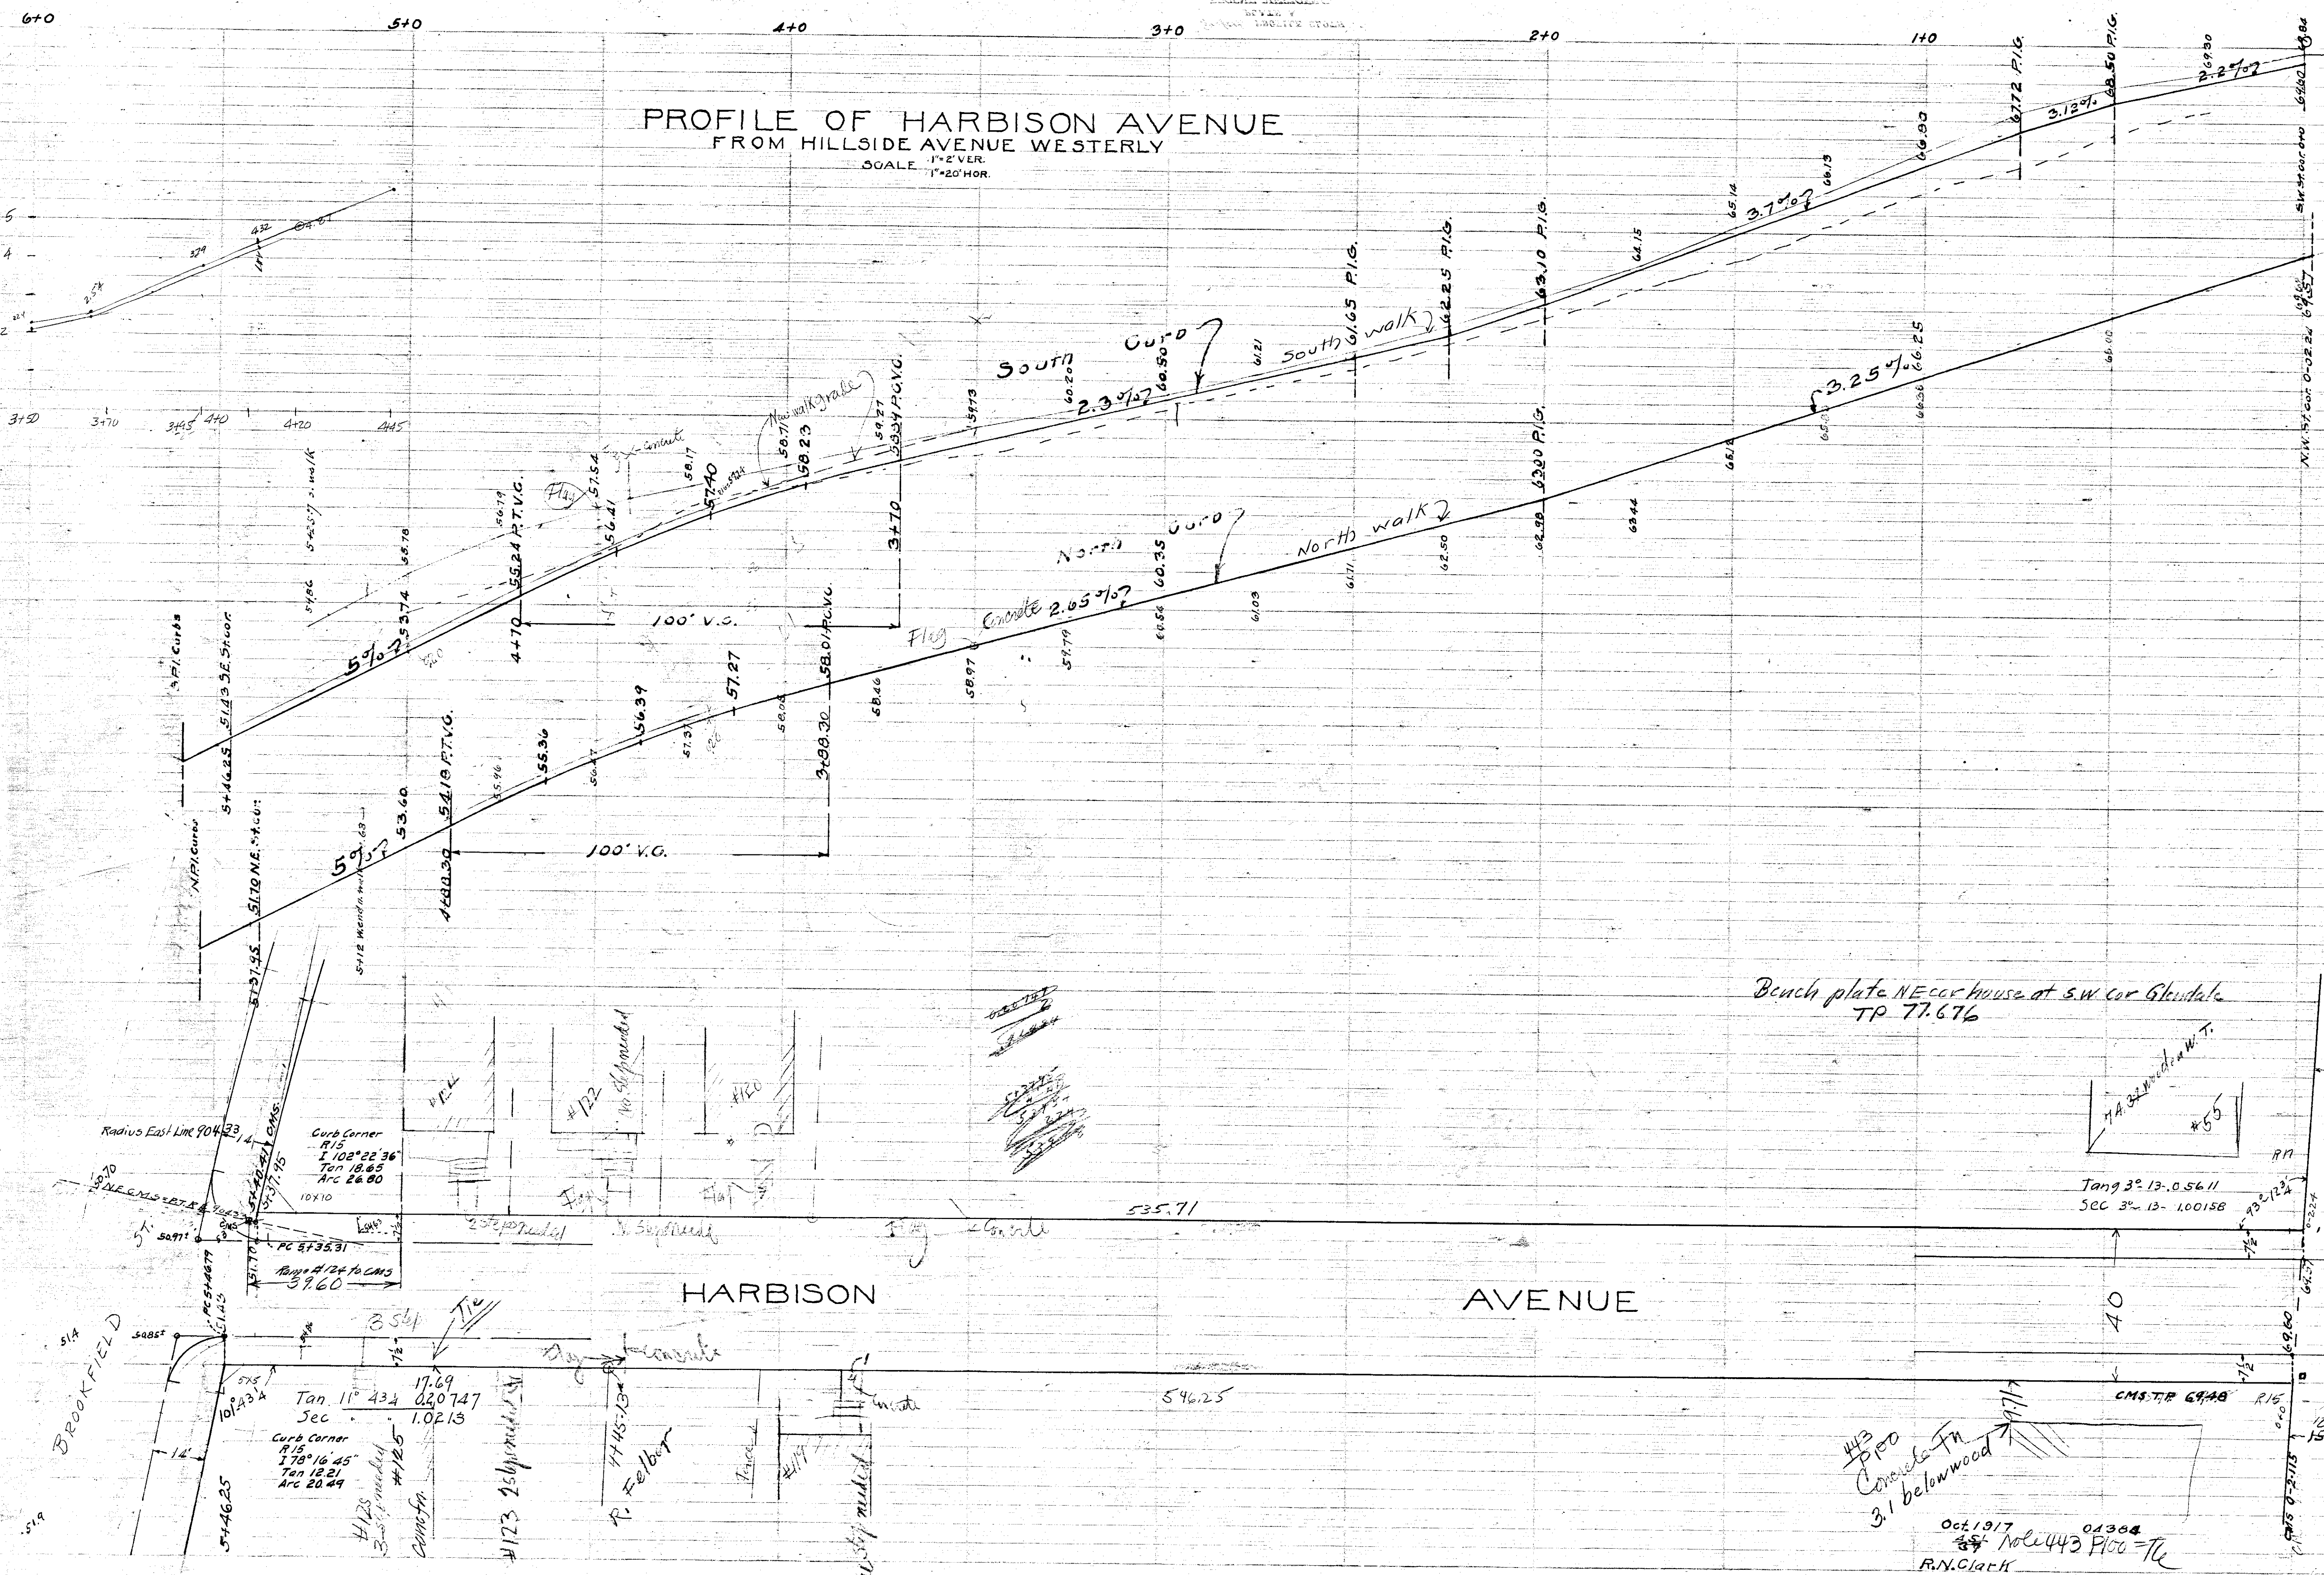

Bench plate NE cor house at S.W. cor Glendale
TP 77.676

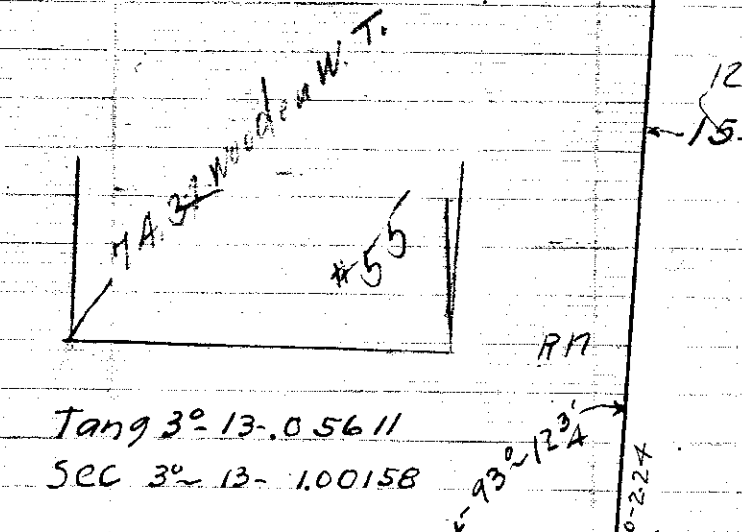

HILLSIDE AVE.

AVENUE

HARBISON








Oct 1917
R.N. Clark