


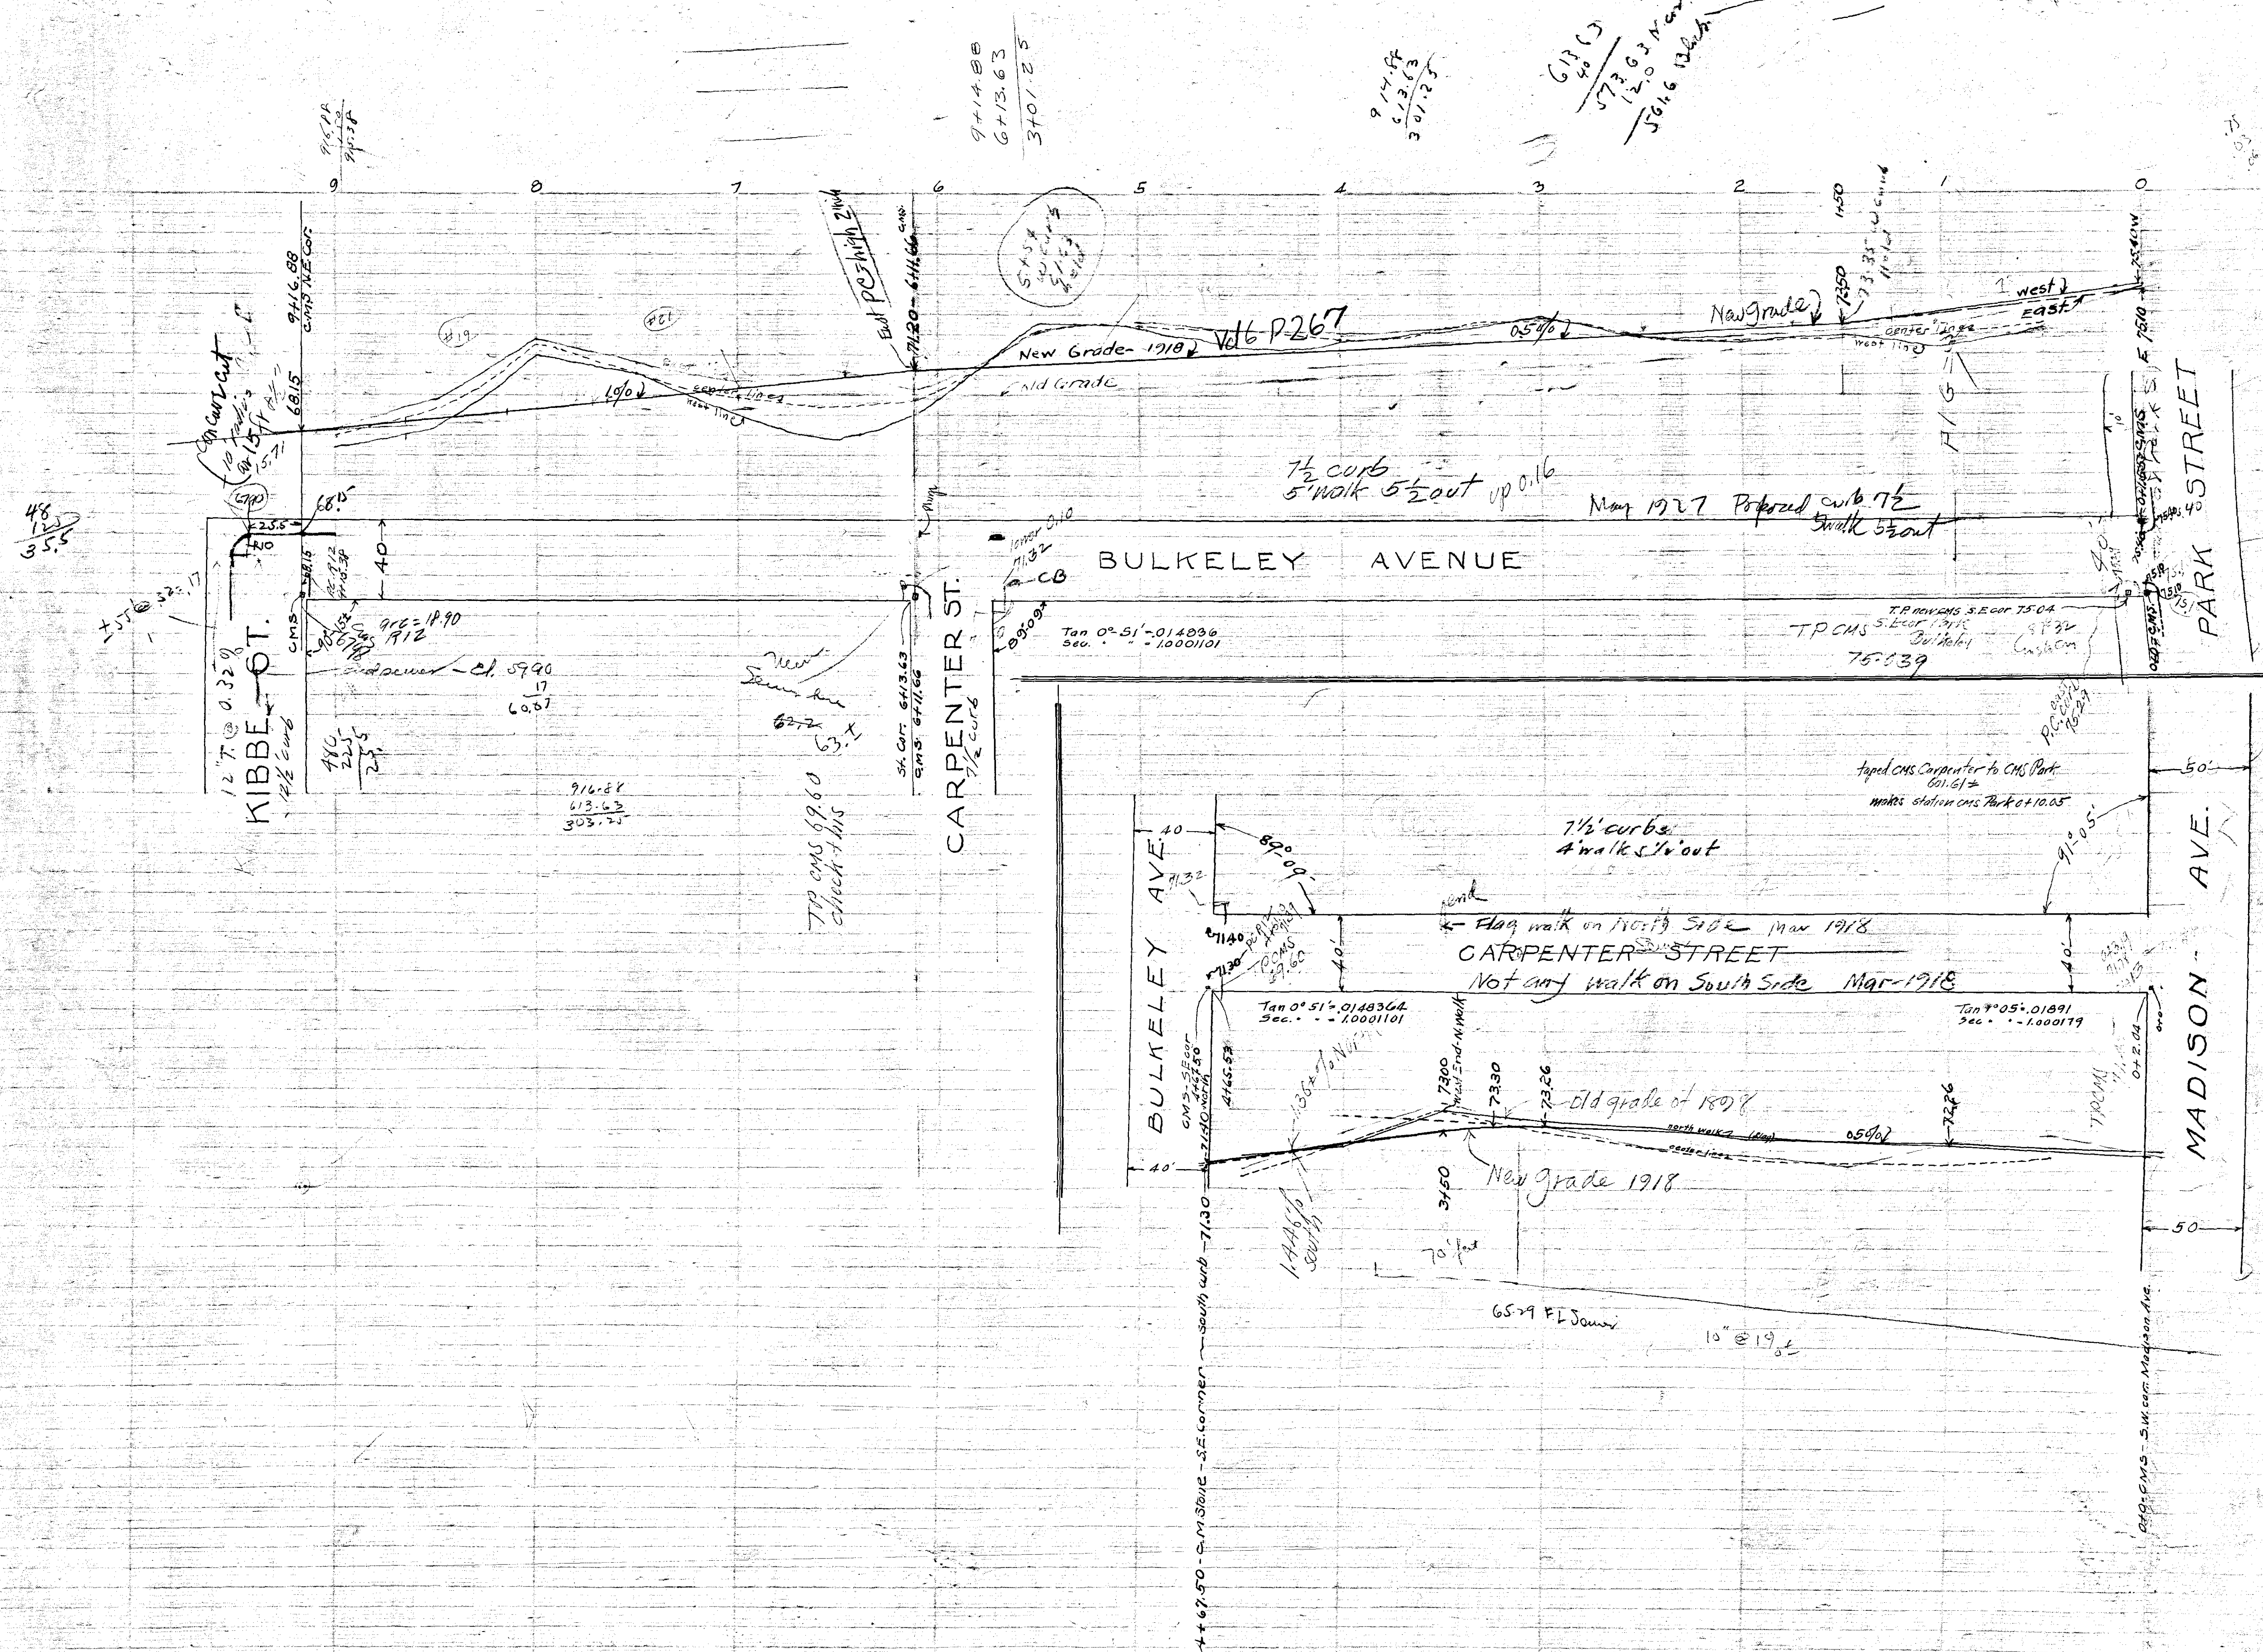

48
12
35.5

9+14.88
6+13.63
3+01.25

9+14.88
6+13.63
3+01.25

613.63
573.63
120.3
5616.13

12" 7' 0.32%

KIBBE ST.

916.84
613.63
303.21

TP CMS 69.60
check this

CARPENTER ST.

Tan 0° 51' - 0.148364
Sec. - 1.0001101

BULKELEY AVENUE

BULKELEY AVE.

Tan 0° 51' - 0.148364
Sec. - 1.0001101

CARPENTER STREET
Not any walk on South Side Mar-1918

1 1/2' curbs
4' walk 5' out

Old grade of 1898

New Grade 1918

65.29 F.I. South

10' @ 19%

T.P. CMS 75.04
S.E. cor 1918
Bulkeley
75.139

typed CMS Carpenter to CMS Park
61.61±
make station CMS Park +10.65


MADISON AVE.

69.61 CMS - SW cor Madison Ave.

Dec 1917
21/54

04432