



~~NORTH~~ CUL-DE-SAC- "B" STREET

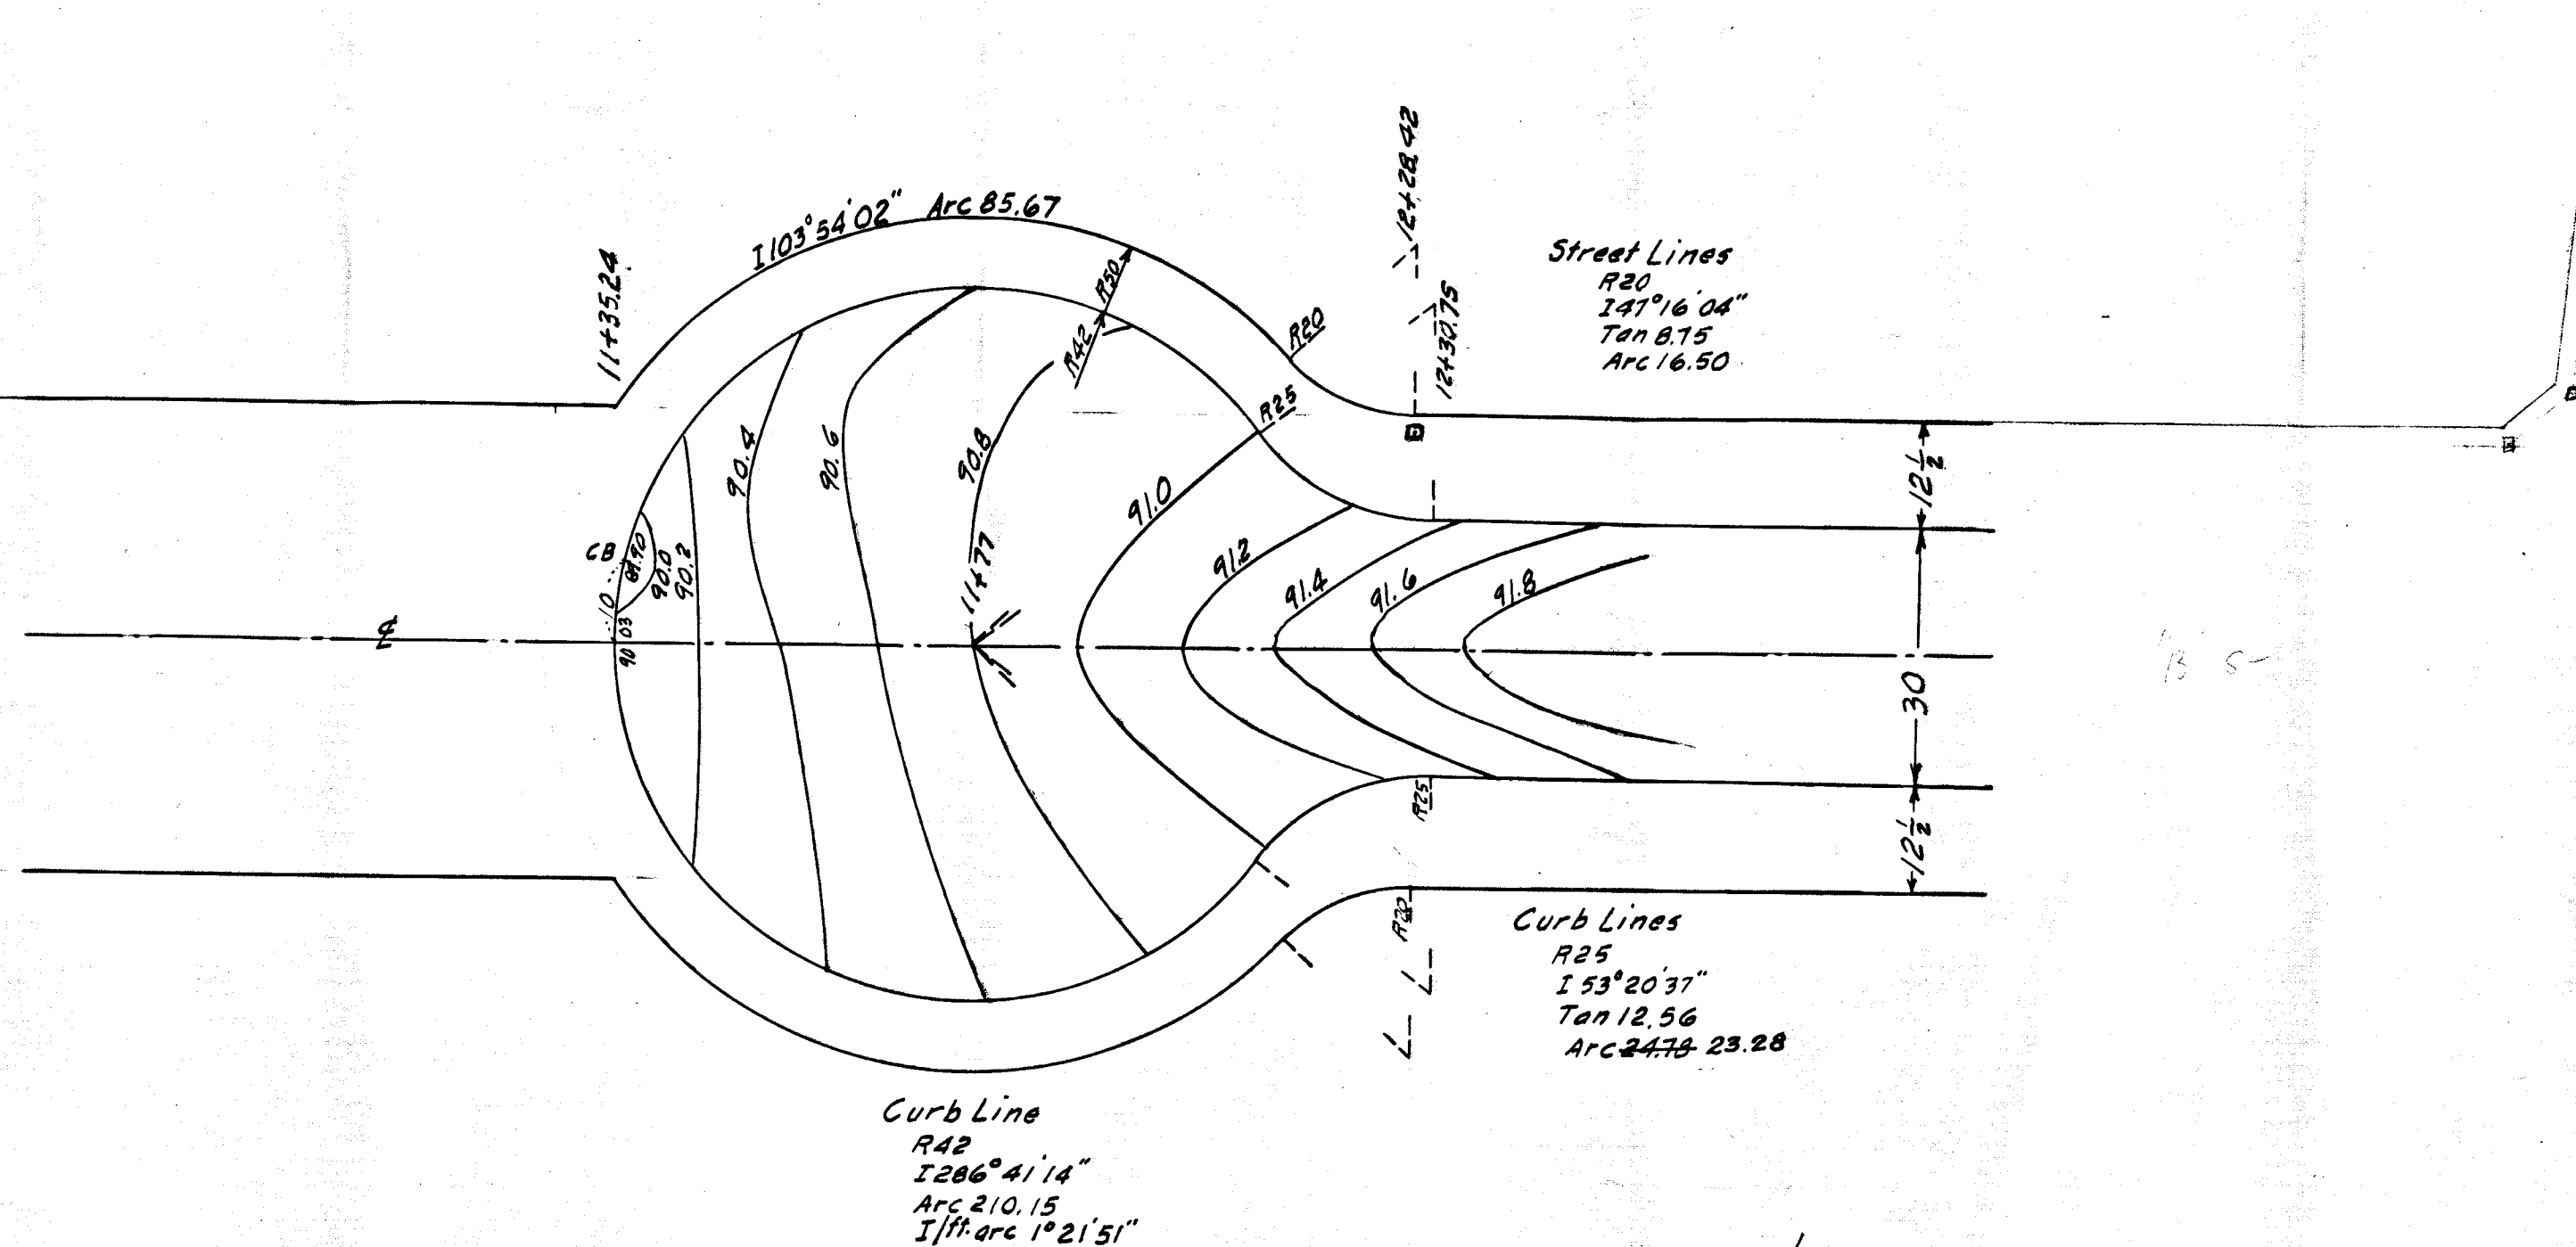

see 363/4

*Curb arc (R42) to be finished on concave side*

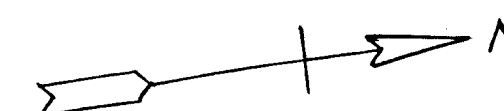