


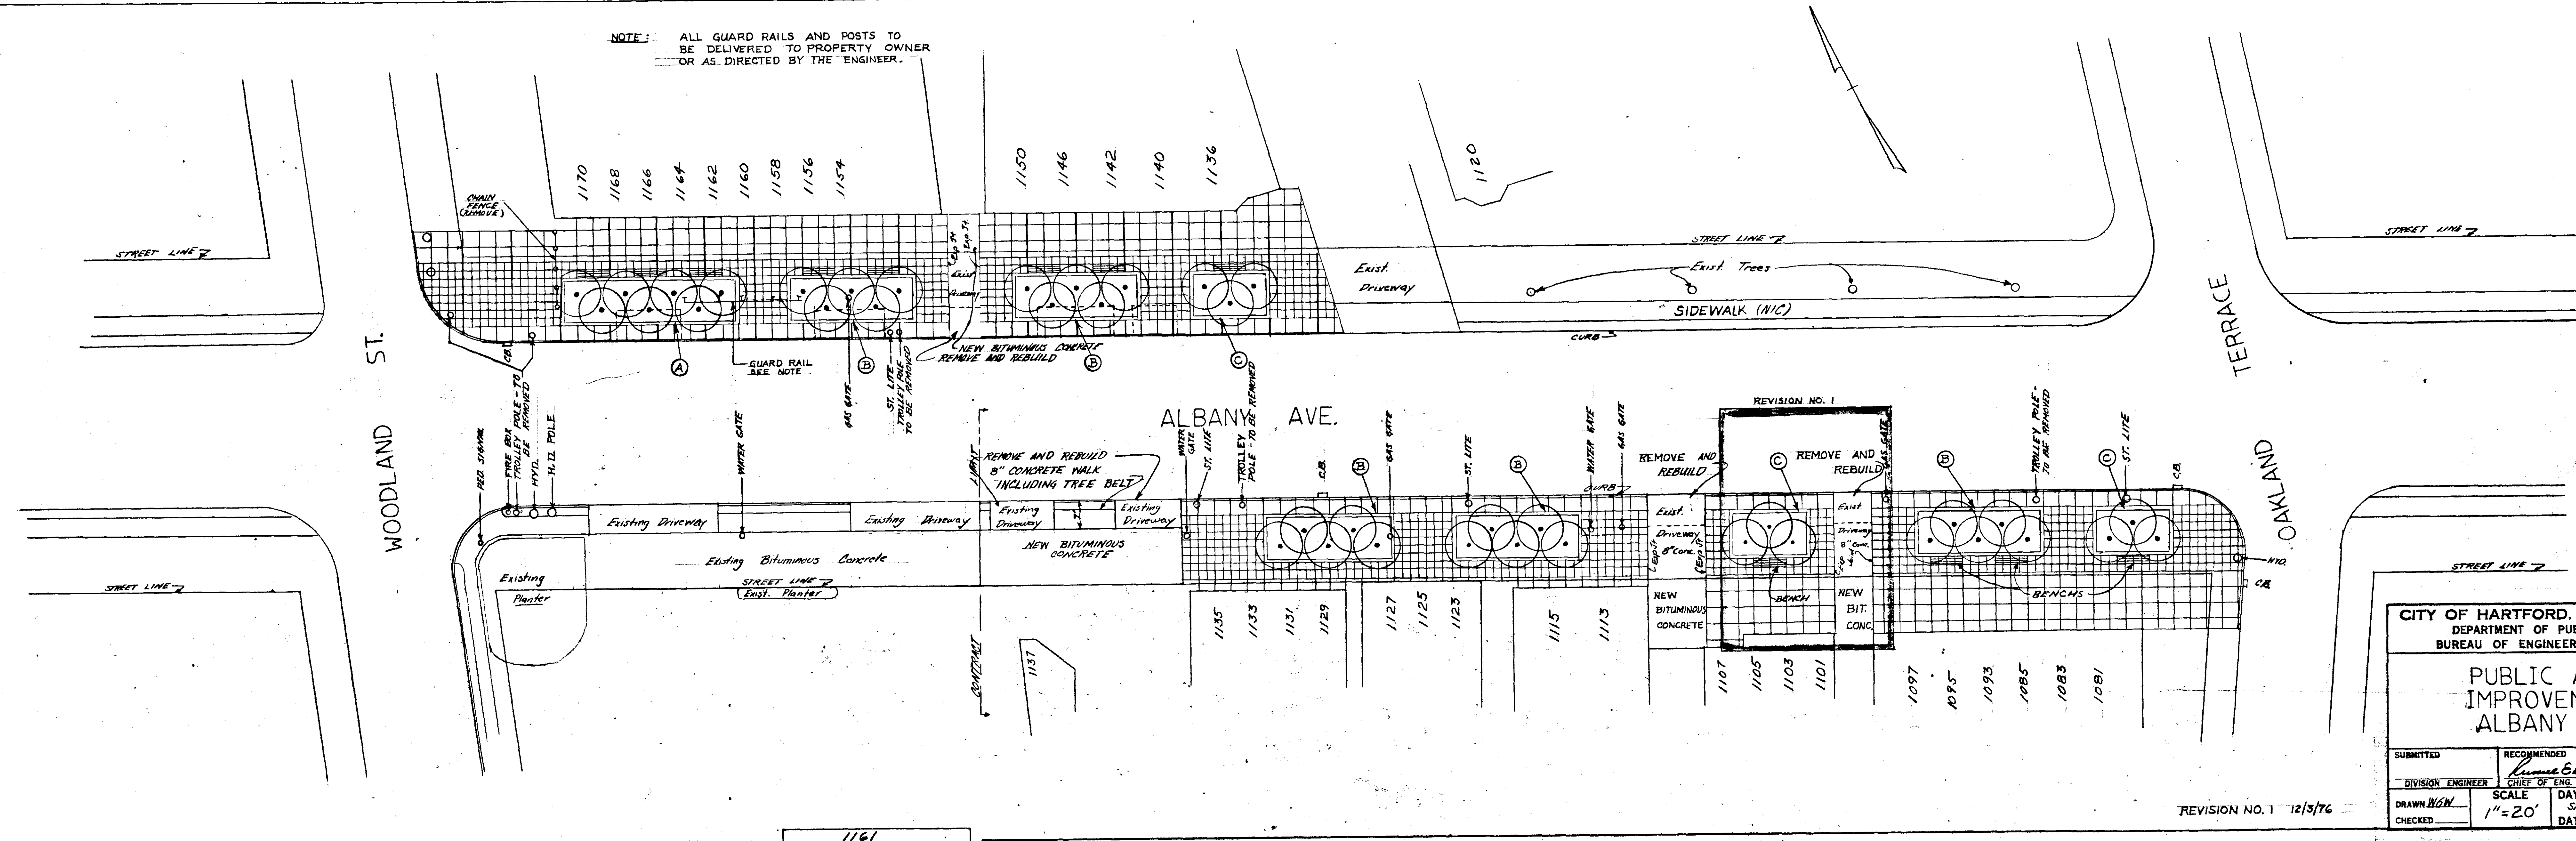

NOTE: ALL GUARD RAILS AND POSTS TO BE DELIVERED TO PROPERTY OWNER OR AS DIRECTED BY THE ENGINEER.

CITY OF HARTFORD, CONNECTICUT DEPARTMENT OF PUBLIC WORKS BUREAU OF ENGINEERING SERVICES		
PUBLIC AREA IMPROVEMENTS ALBANY AVE.		
SUBMITTED	RECOMMENDED	APPROVED
DIVISION ENGINEER	CHIEF OF ENG. SERV.	ASSY. DIR. CITY ENG.
DRAWN <i>WGN</i>	SCALE 1"=20'	DAYBOOK NO. 010554-B SHEET 2 of 3
CHECKED		DATE MARCH 1976

REVISION NO. 1 12/3/76