

LIBERTY STREET REALTY CO.
PROPERTY AND ENVIRONS

HARTFORD CONN.,


APRIL - 1911.

SCALE 400' = 1"

REVISED SEPT. 28 1915

John T. Hudson CIVIL ENGINEER

PLAN NO. 1.

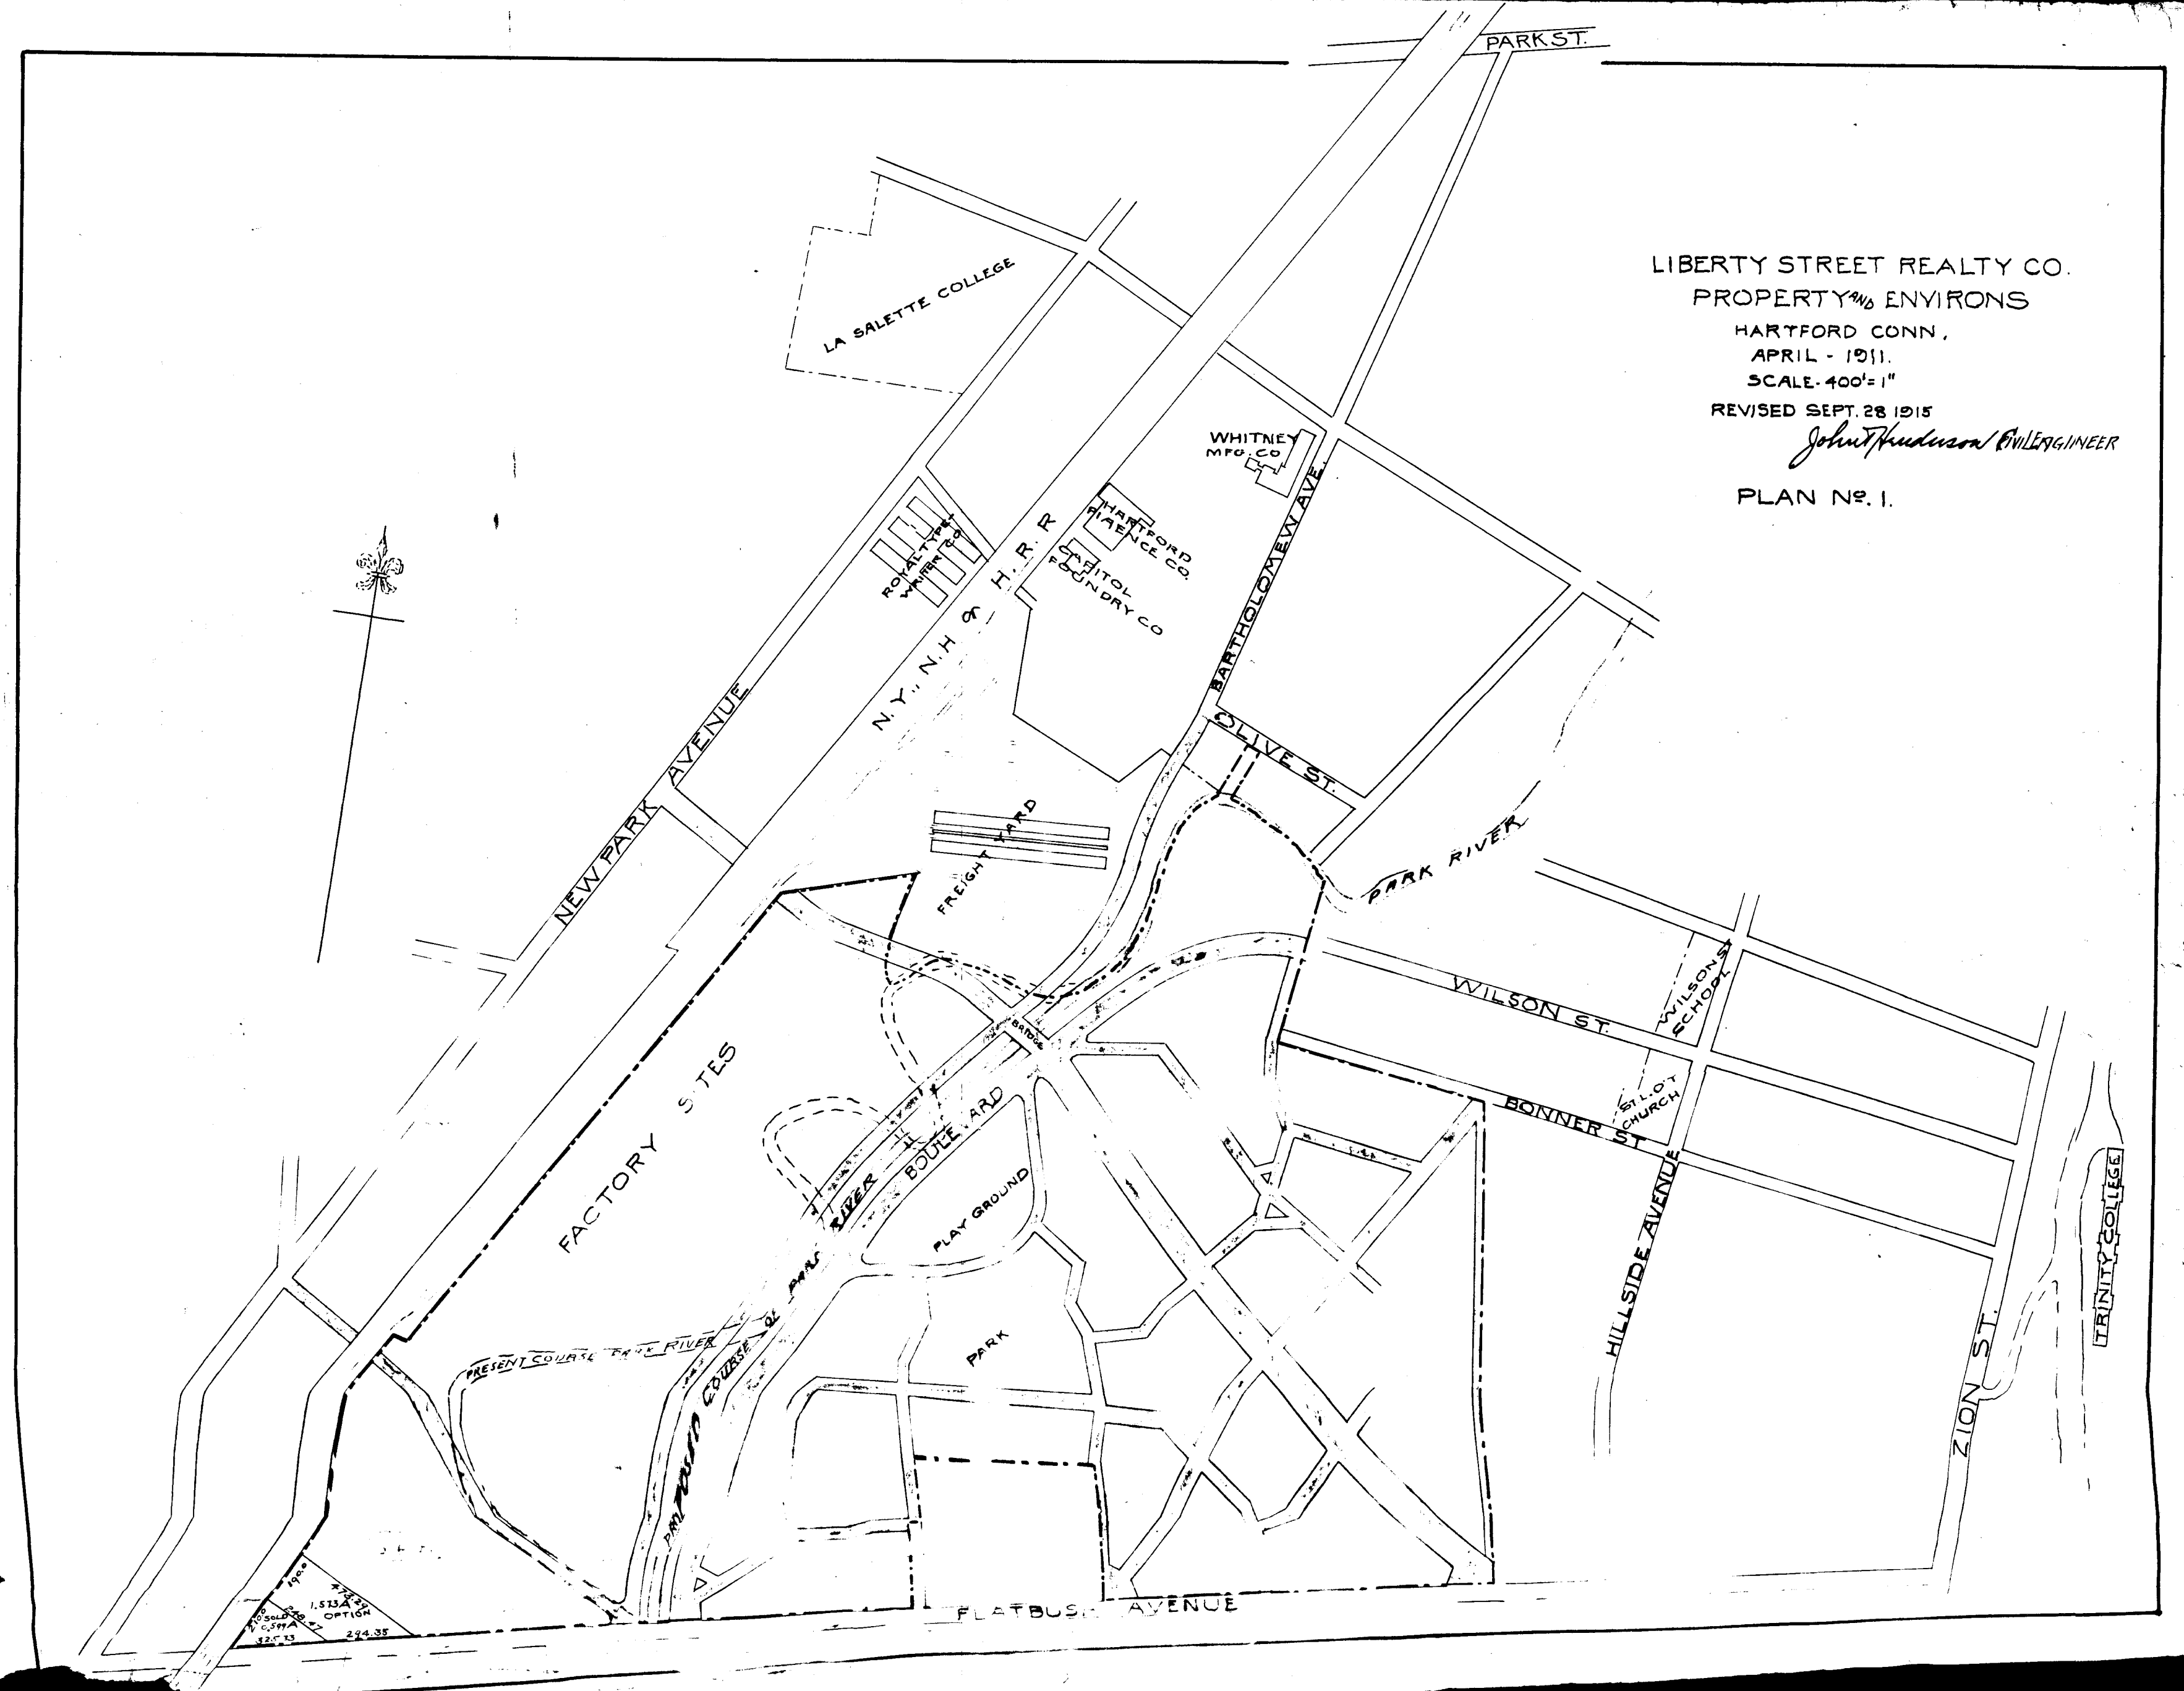

1900
1.513
OPTION
244.35
32.53