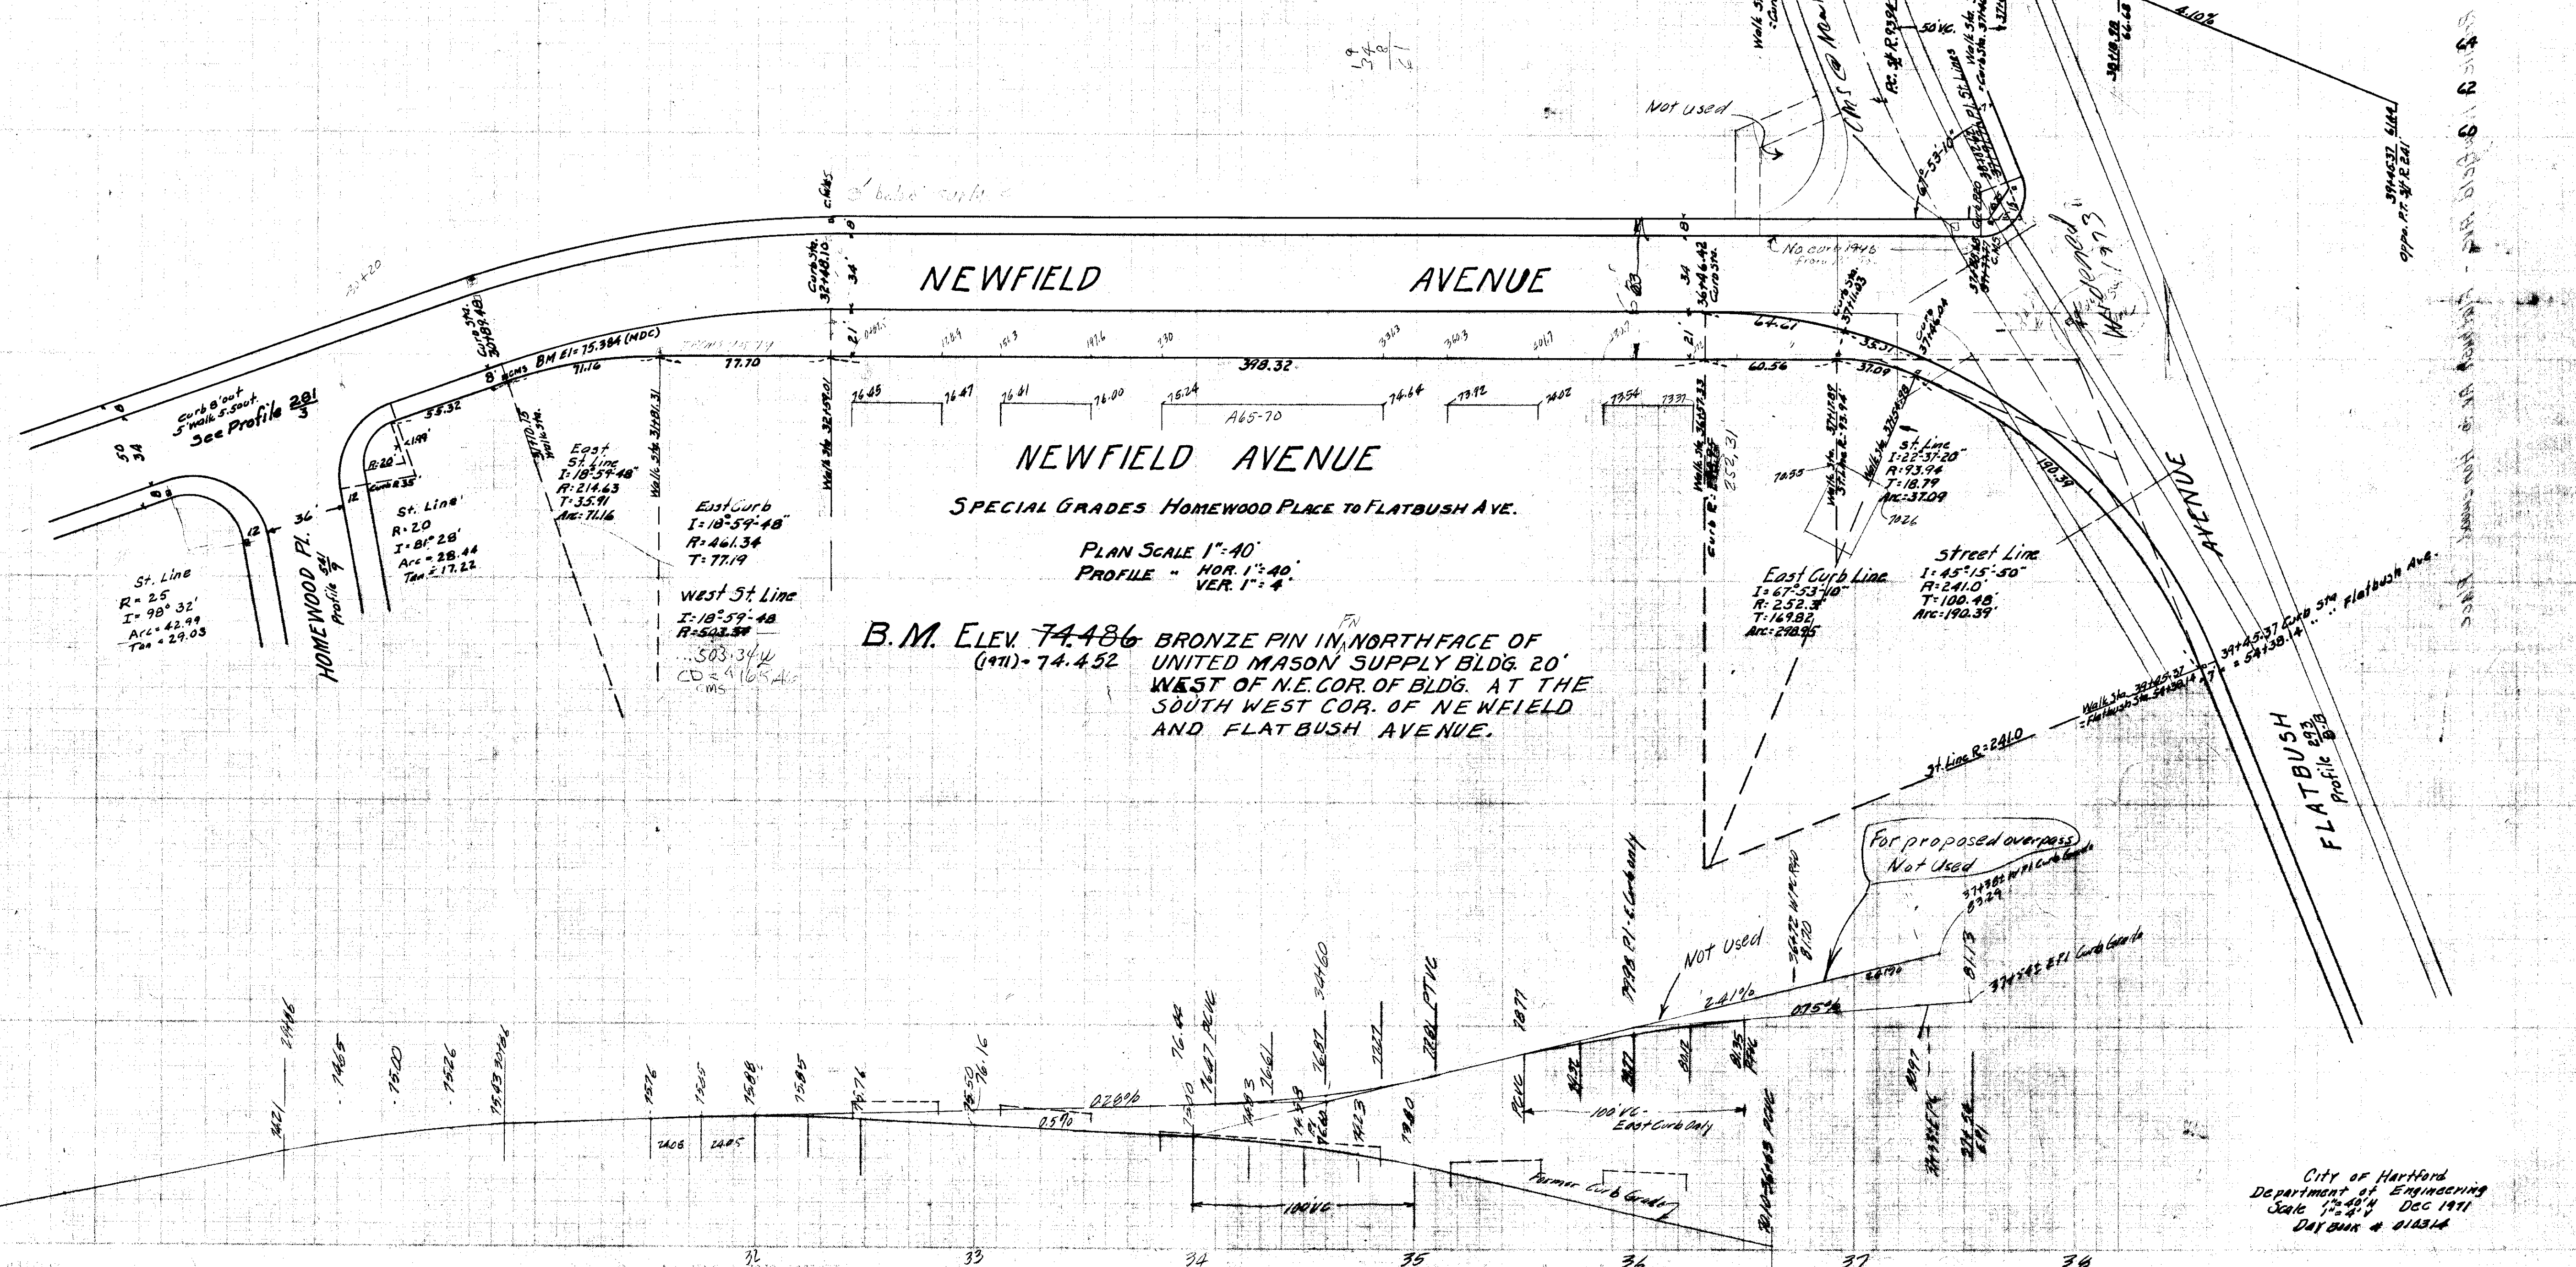


[illegible]

Sheet 4