


Number Plan
POPE PARK HIGHWAY NO. 4
Park St. to Wellington St.
Intervals: 25' Scale: 1"=40'
April, 1920.
R.N. Clark.
City Engineer.

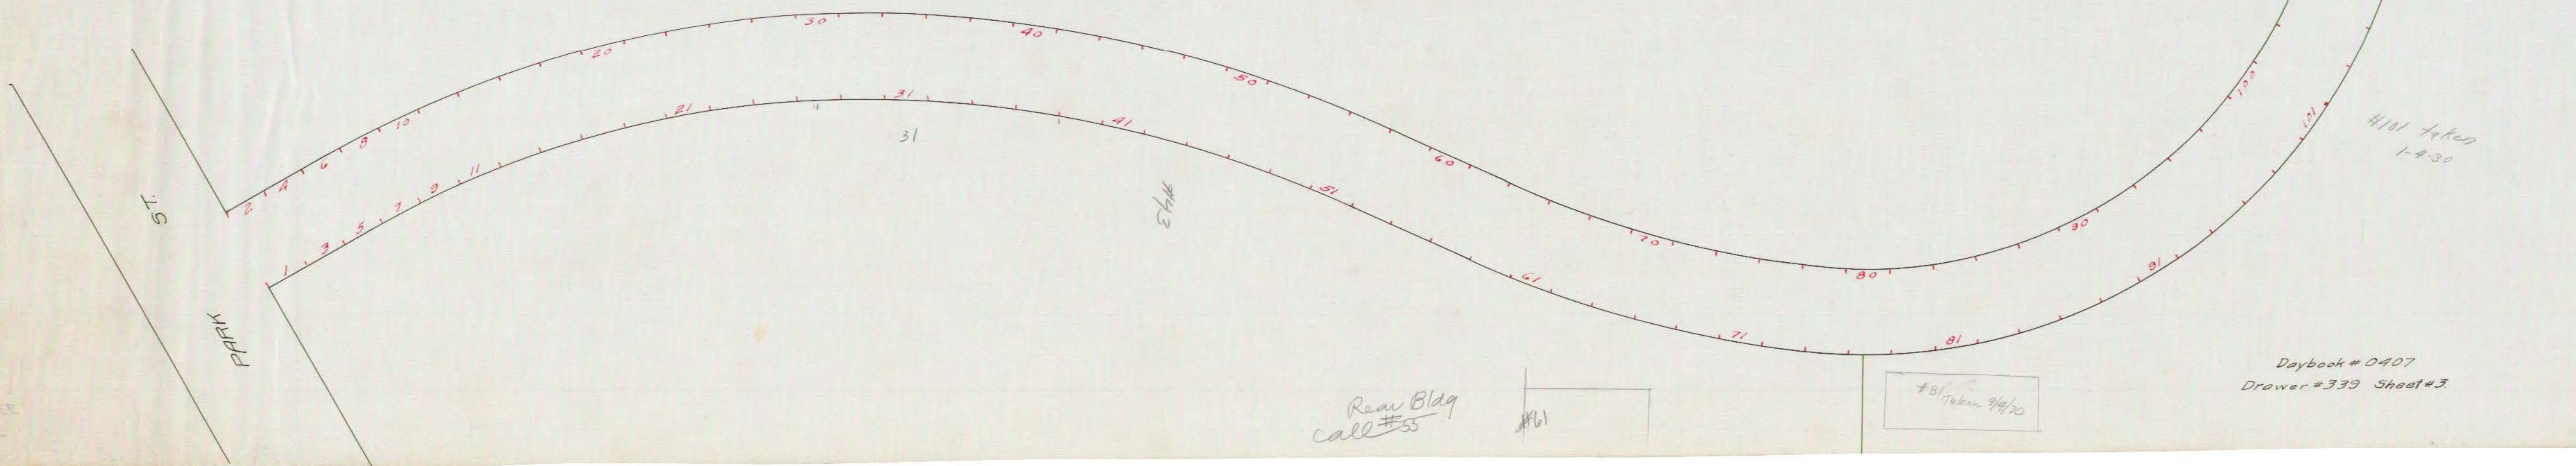

Daybook # 0407
Drawer #339 Sheet #3