


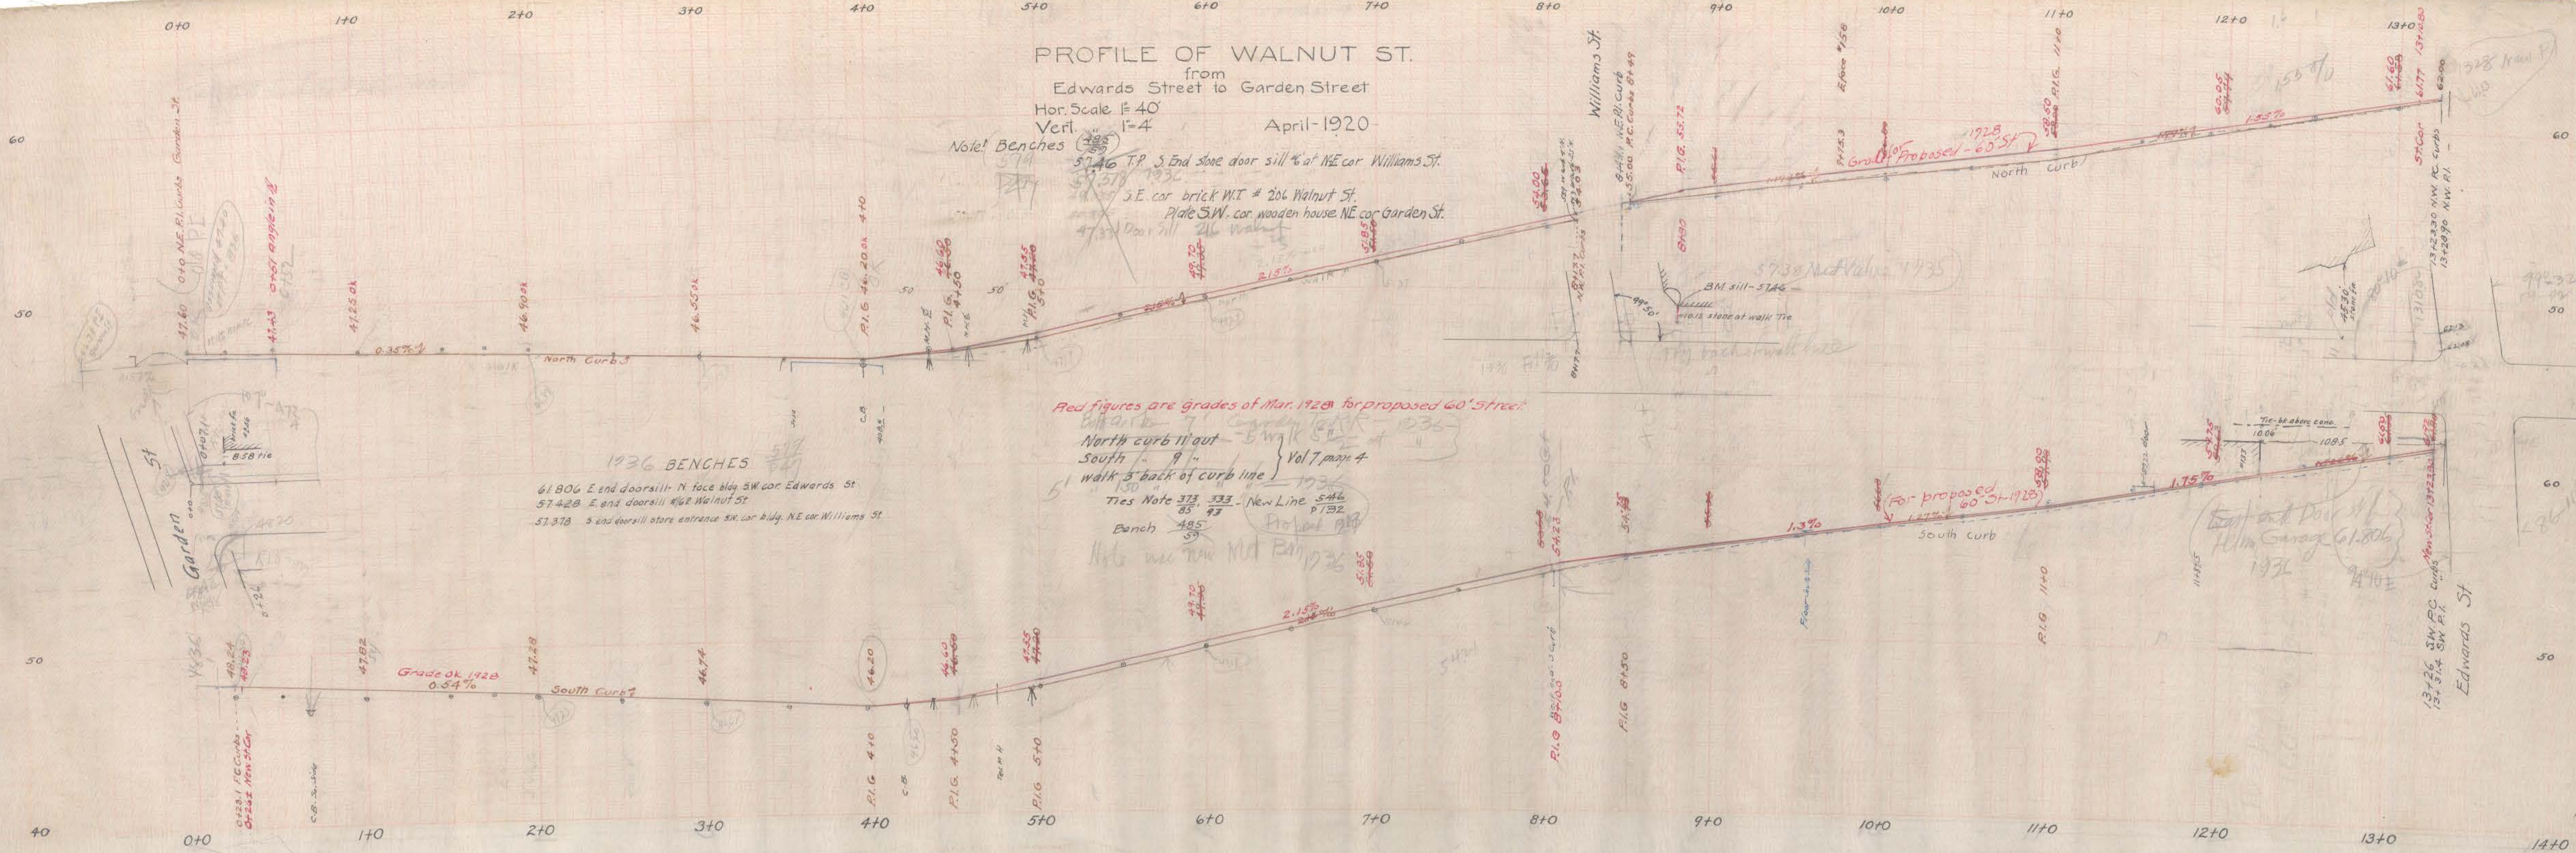

April-1920
481-116-116
485-116-116
R.N.C.