


WEST HARTFORD BOULEVARD

RODNEY STREET

5' walk, 8 1/2' out - 3' curb
12' curb
see profile 179

WARRENTON AVENUE

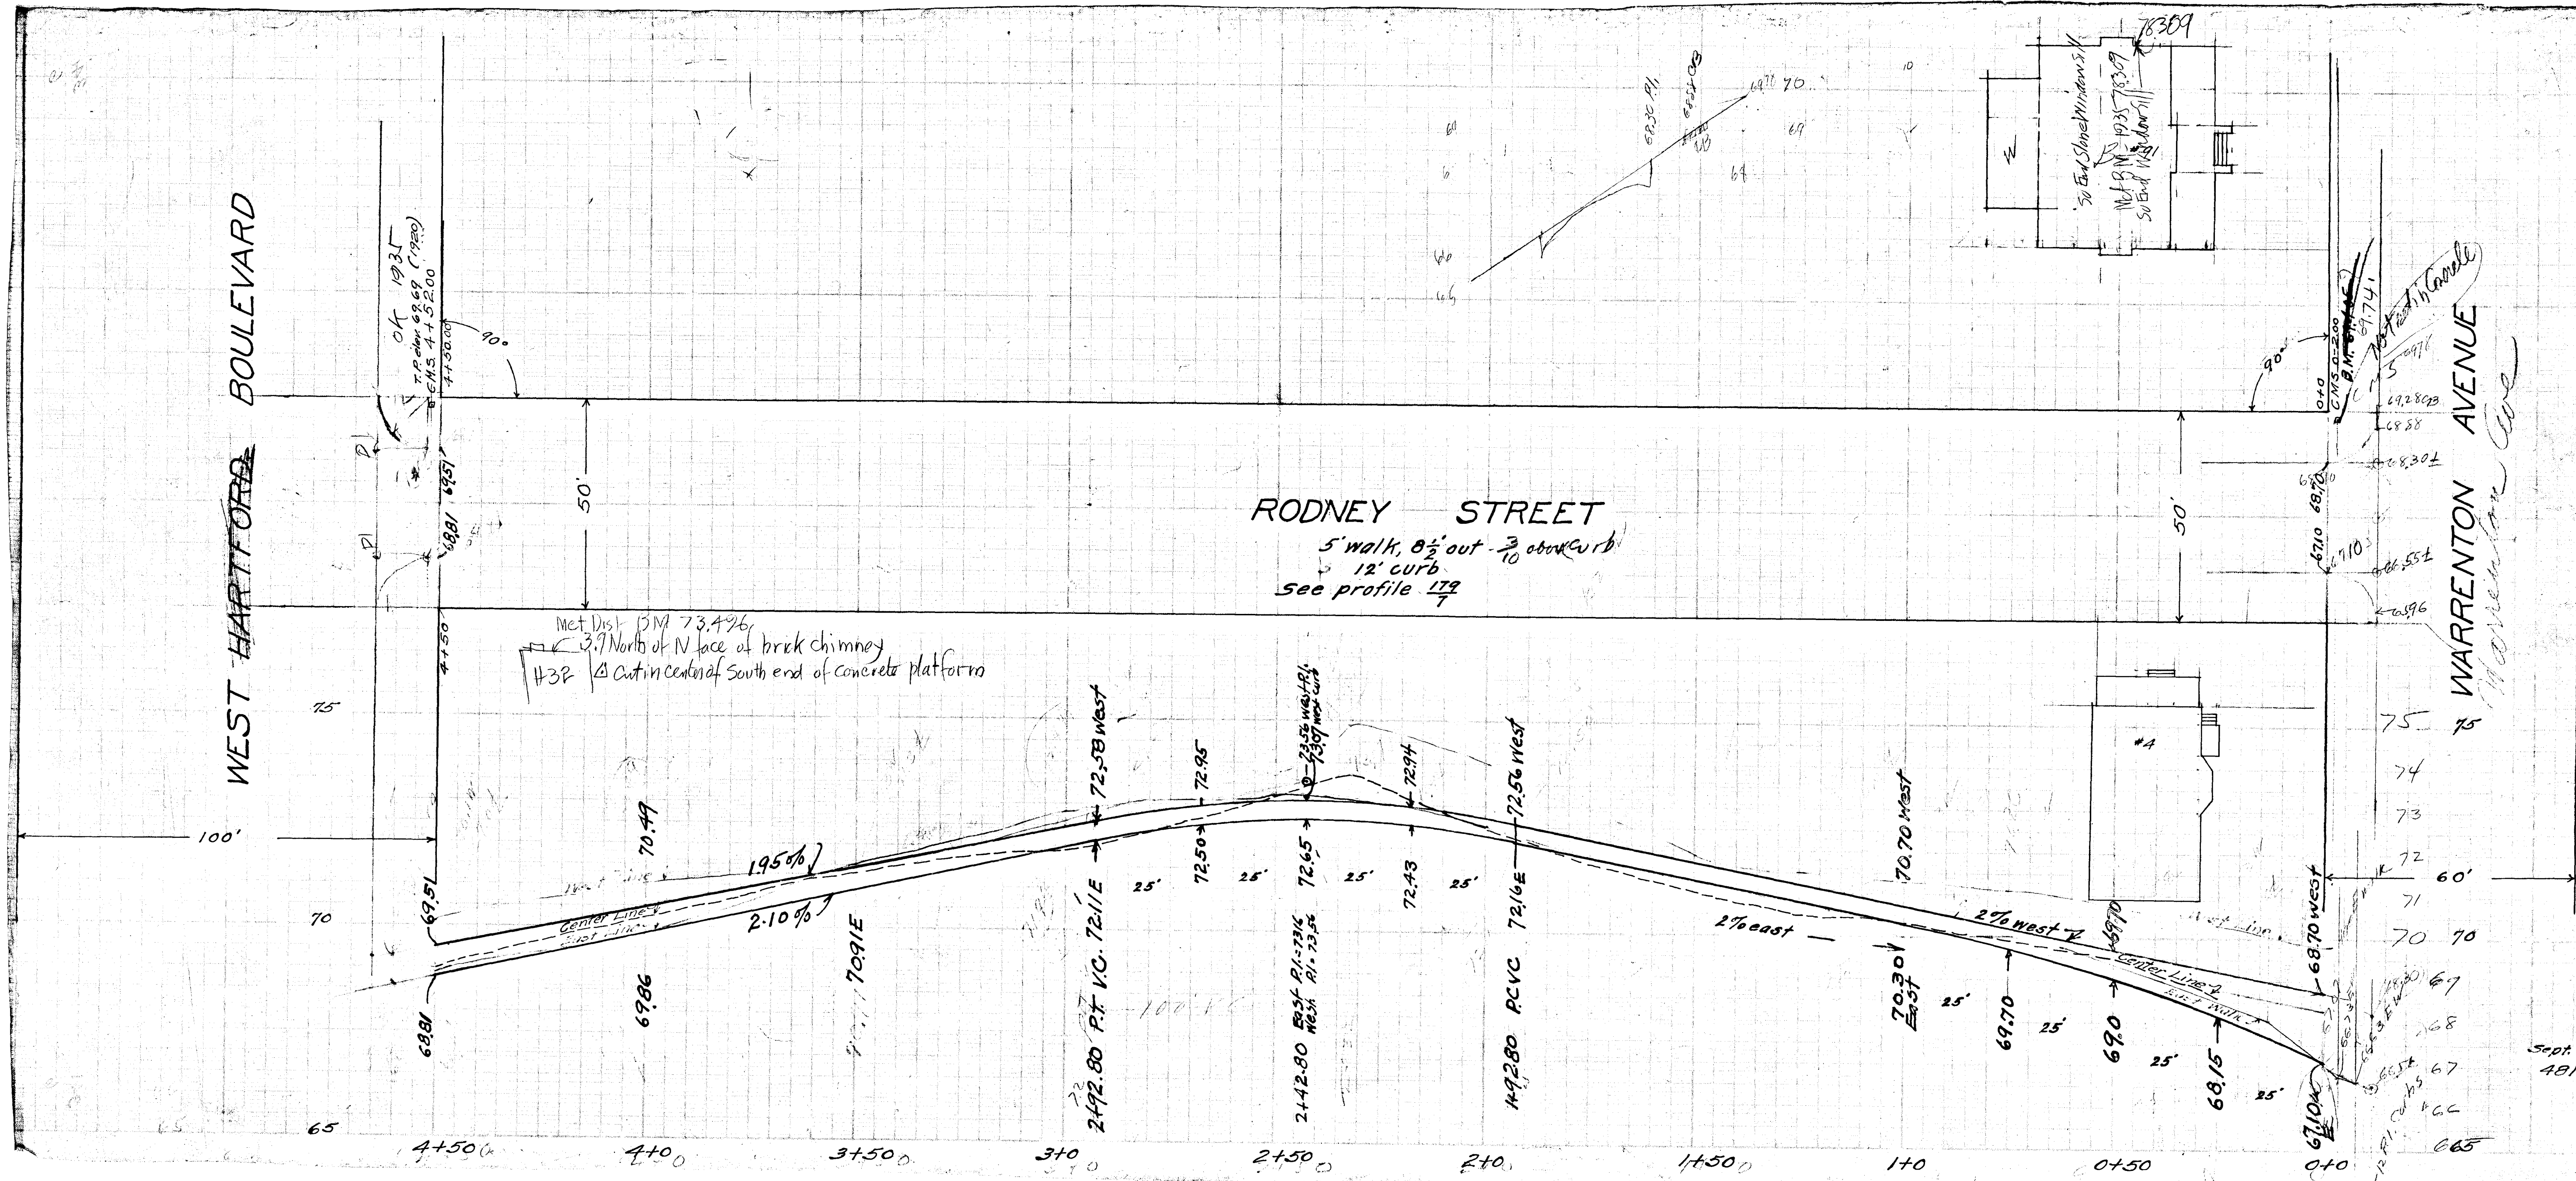

Sept. 1920
481 PR20

05008